




EASI FILE CORP. IRVINE, CA		EPH 36
102		

102-11

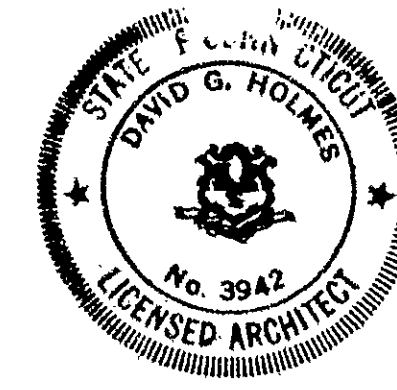

All elevations are referenced to finished floor at each level (0'-0"). All other elevations are ±('- -").

Certification
The undersigned does hereby certify that to the best of his knowledge and belief these plans contain all information required by Connecticut General Statutes Section 47-228 relating to plans.
David G. Holmes

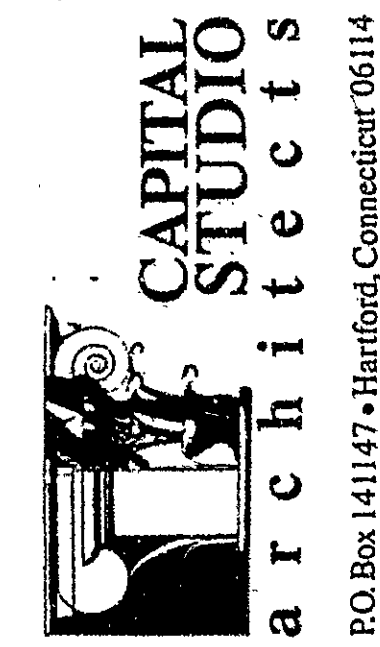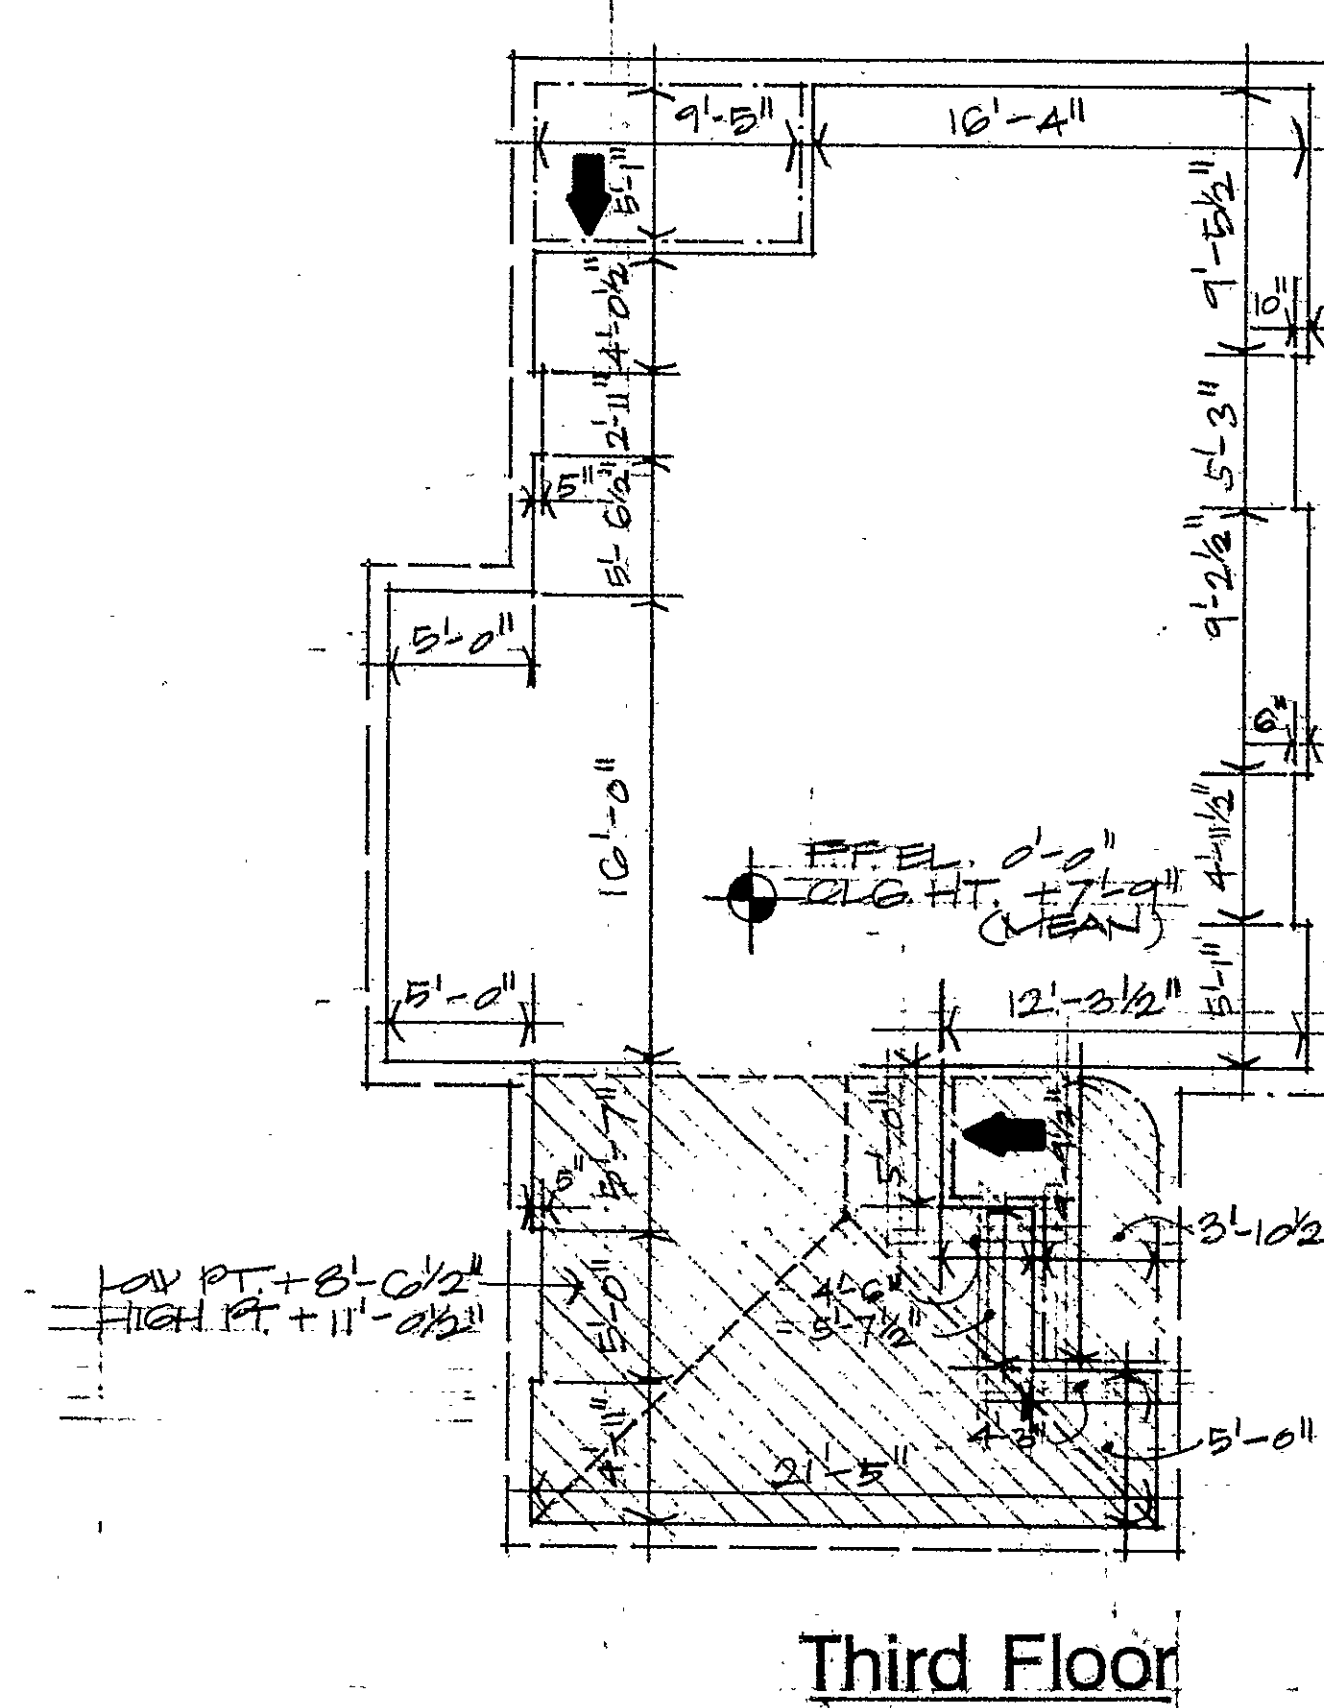

Congress Street
Condominium, Ltd.
Declarant



- LEGEND**
- UNIT BOUNDARY
 - EXT. SURFACE
 - ELEV. CHANGE
 - LTD. COMM. ELEM. CEIL.
 - HGT. CHANGE
 - SLOP. CEIL. ABOVE

Sheet #1

Unit A43d

0 2 4 8'

REF. NORTH

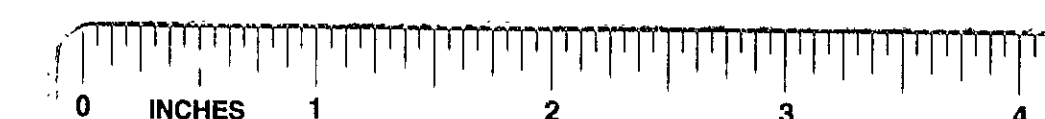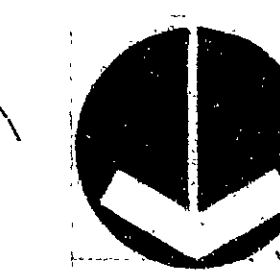

RECEIVED IN