


RECEIVED BY
FREDERICKSON & SONS
VOL. 1

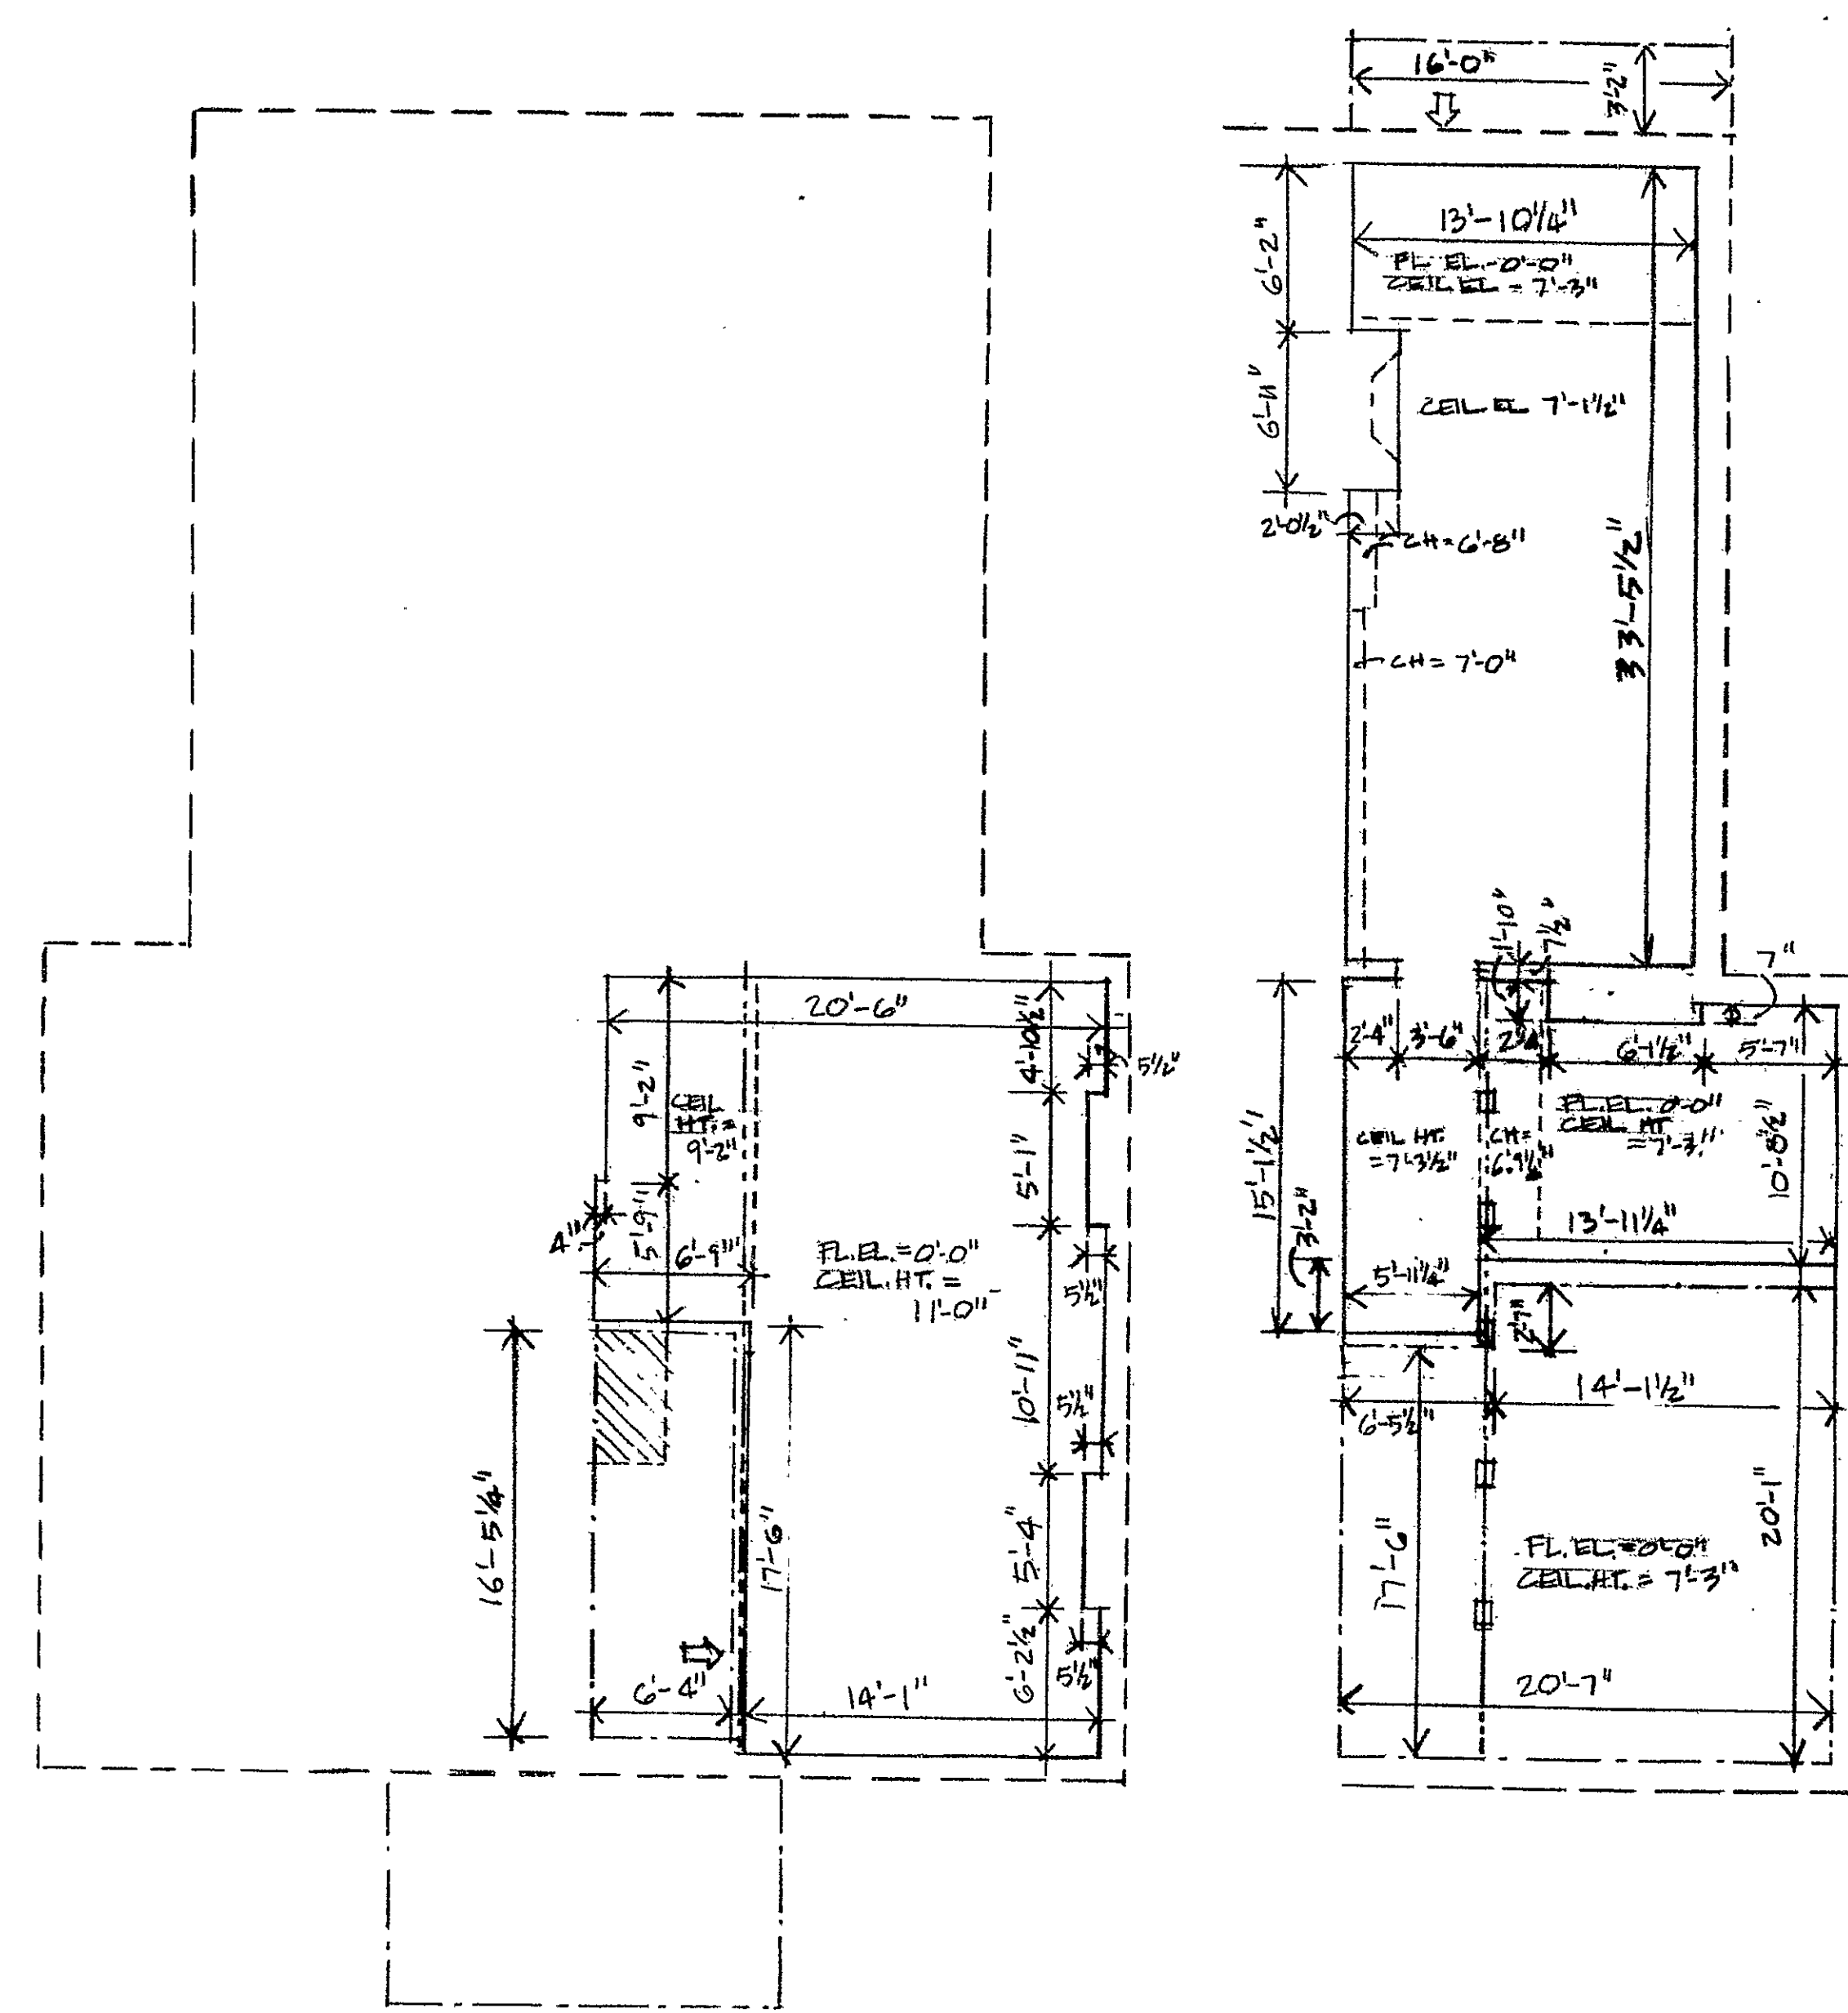

FIRST FLOOR


BASEMENT FLOOR

Certification


The undersigned does hereby certify that to the best of his knowledge and belief, these plans contain all information required by Connecticut General Statutes Section 47-228 relating to plans.

John T. Wilcox Jr.


All elevations are referenced to the finished floor at each level (0'-0"). All other elevations are ± (_ ' - _ ").

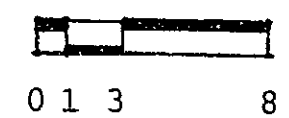

Scale in feet.

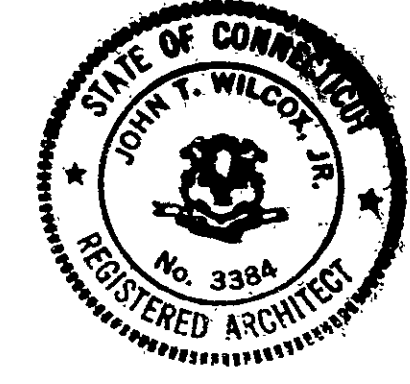

REF. NORTH	CONGRESS STREET CONDOMINIUM, LTD.
Declarant	
LEGEND	
—	UNIT BOUNDARY
- - -	EXT. SURFACE
- - - - -	CEIL. ELEV. CHANGE
- - - - -	LTD. COMM. ELEM.
- - - - -	FLOOR ELEV. CHANGE
- - - - -	BRNG. PART OR BEAM
■	MASONRY MASS
▨	SLOPED CEIL. AREA
John T. Wilcox Jr. R.A. ARCHITECT 37 Orchard Rd Farmington, Conn. 06032 203 678-1945	UNIT C 67a

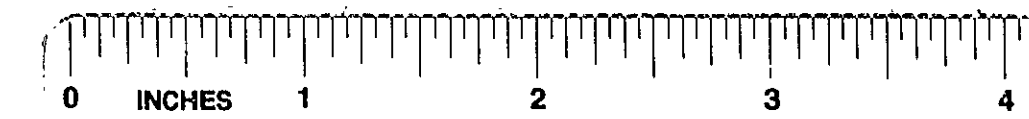

Condo # 103