


RECEIVED BY
FEB 17 11 17 AM '80
VOL. 103-1

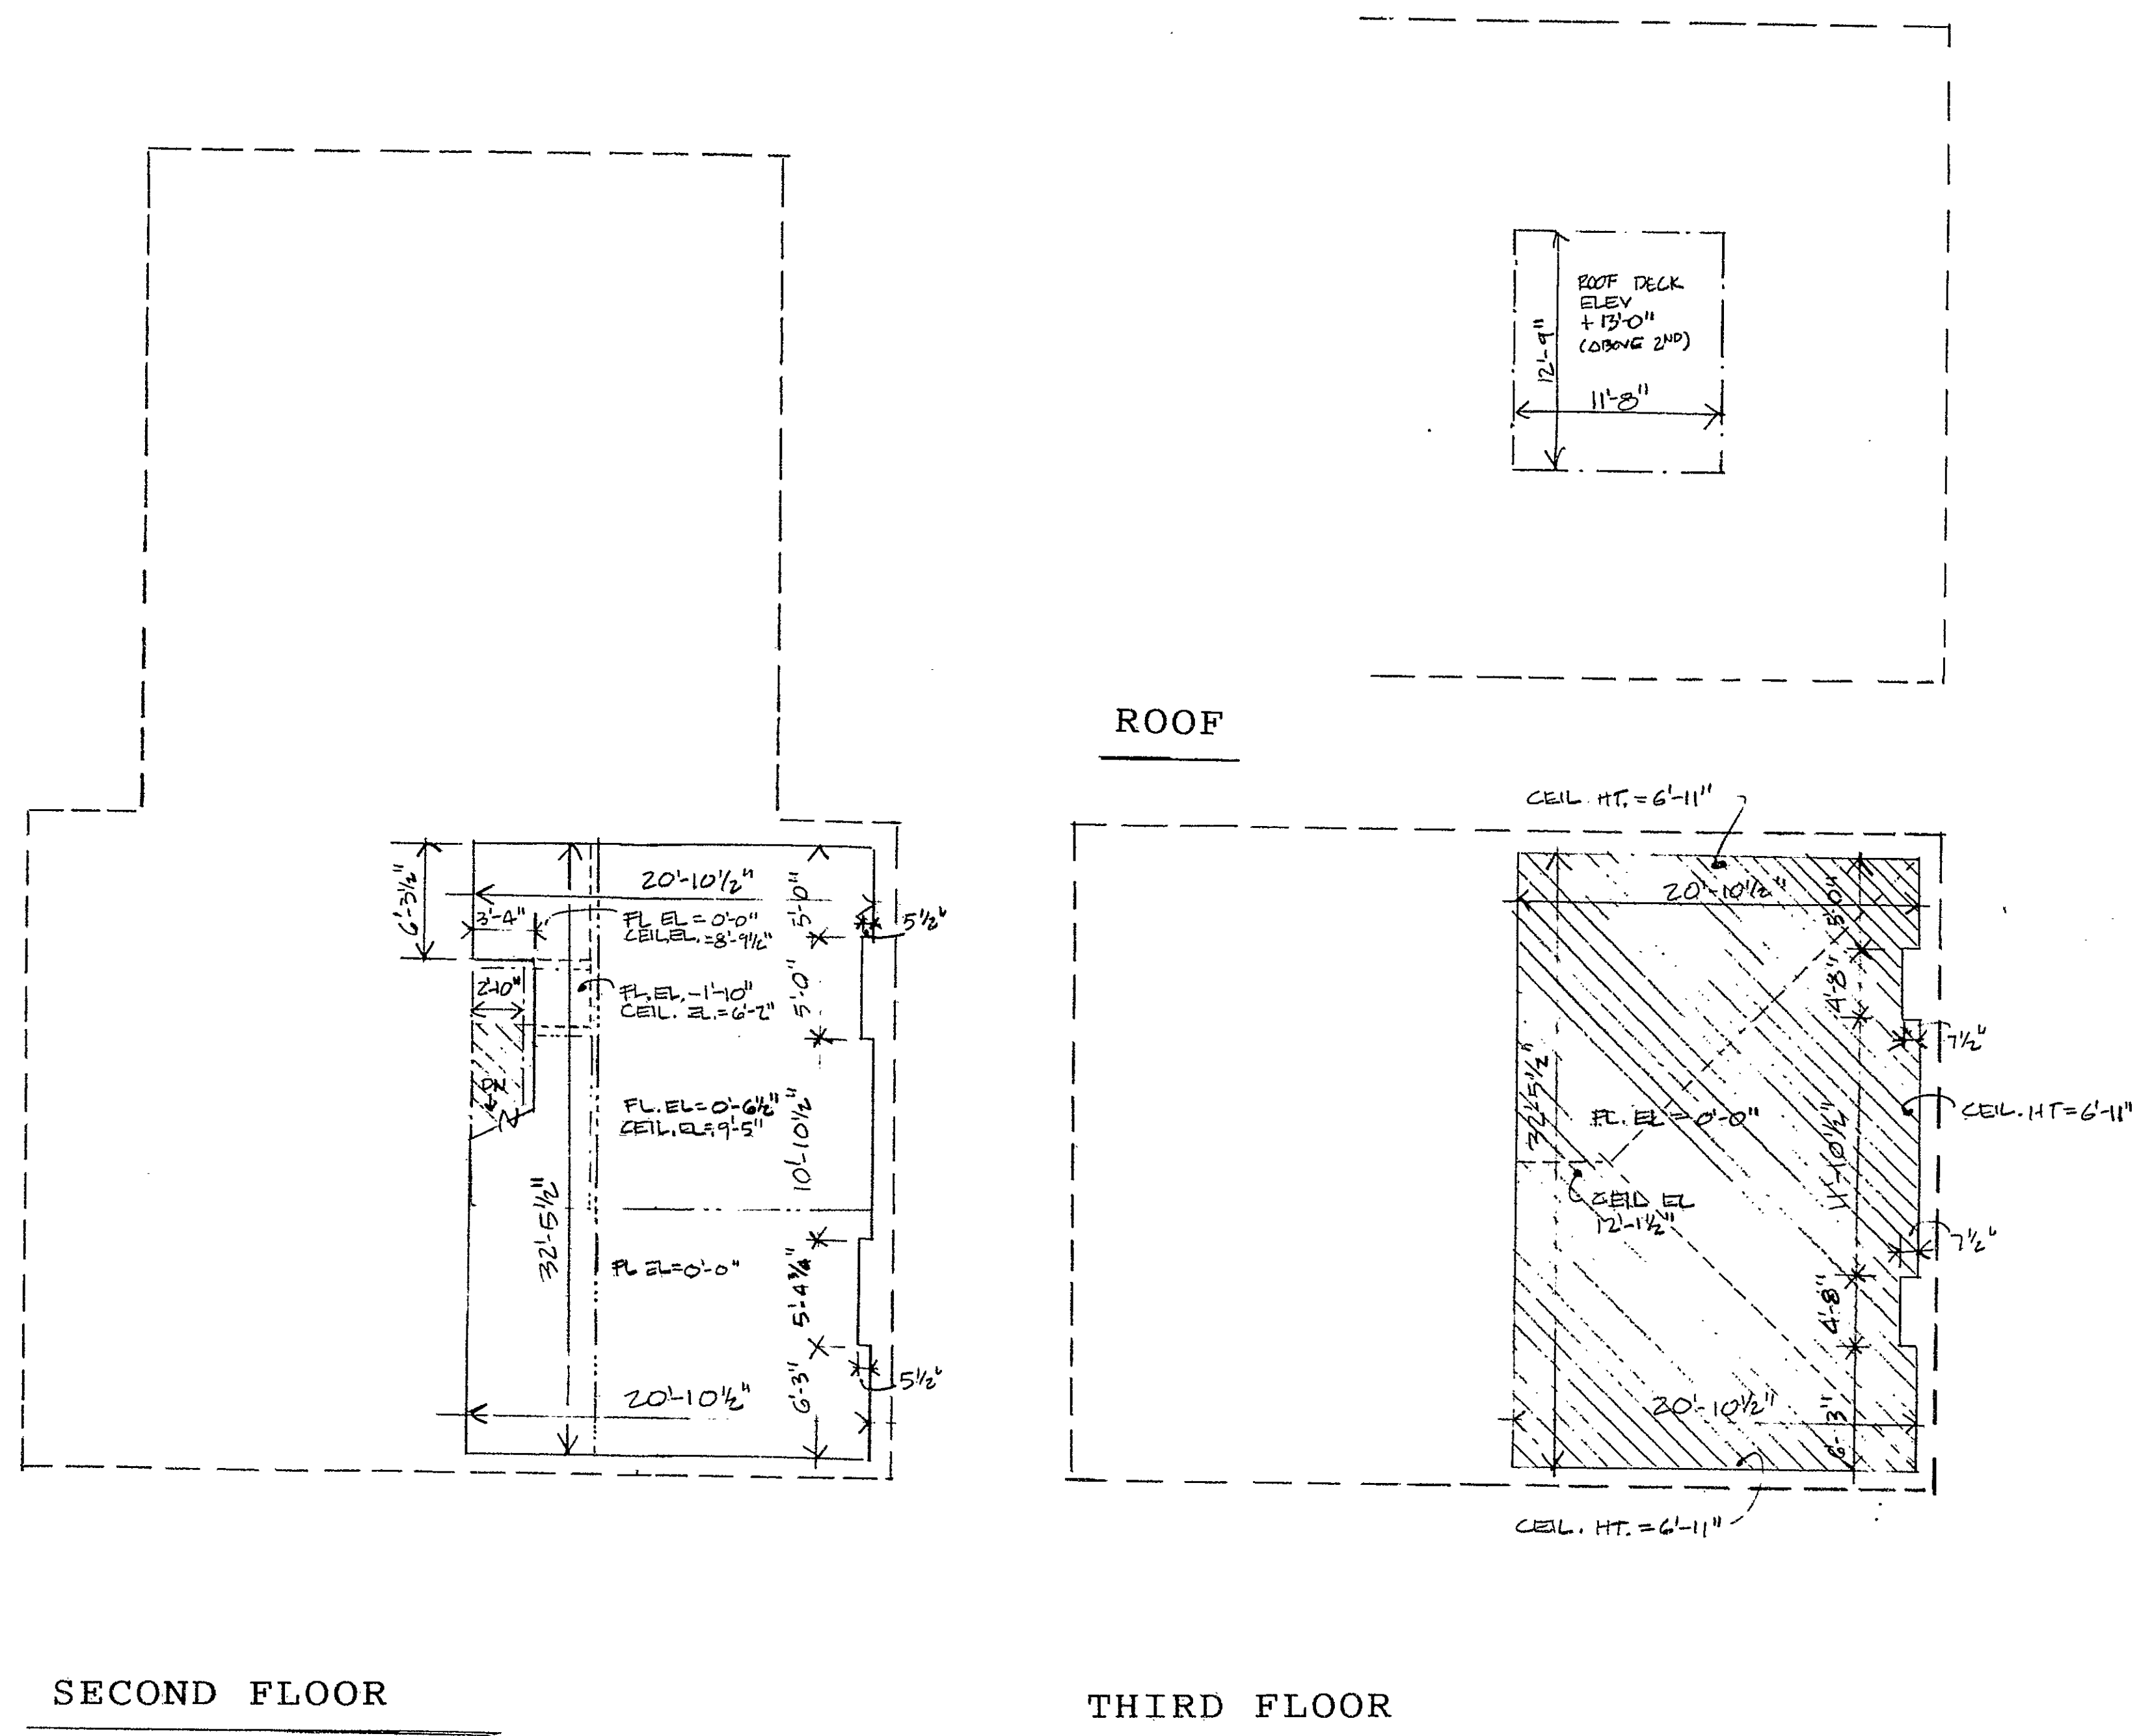

Certification

The undersigned does hereby certify that to the best of his knowledge and belief, these plans contain all information required by Connecticut General Statutes Section 47-228 relating to plans.

John T. Wilcox Jr.


All elevations are referenced to the finished floor at each level (0'-0"). All other elevations are ± ("'-").

0 1 3 8

Scale in feet.



REF. NORTH	CONGRESS STREET CONDOMINIUM, LTD.
Declarant	
LEGEND	
- UNIT BOUNDARY - EXT. SURFACE - CEIL. ELEV. CHANGE - LTD. COMM. ELEM. - FLOOR ELEV. CHANGE - BRNG PART OR BEAM - MASONRY MASS - SLOPED CEIL. AREA	
John T. Wilcox Jr. R.A. ARCHITECT 37 Orchard Rd Farmington, Conn. 06032 203 678-1945	UNIT C 67b

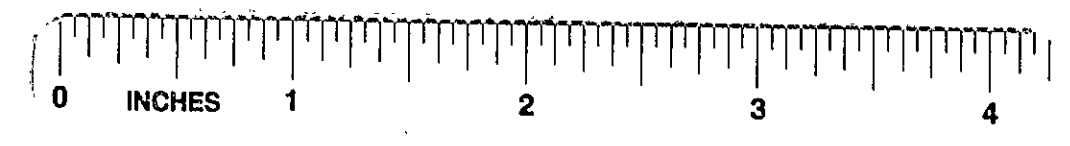

Condo # 103.