


RECEIVED BY  
FED 11 11 1980  
TO  
VOL

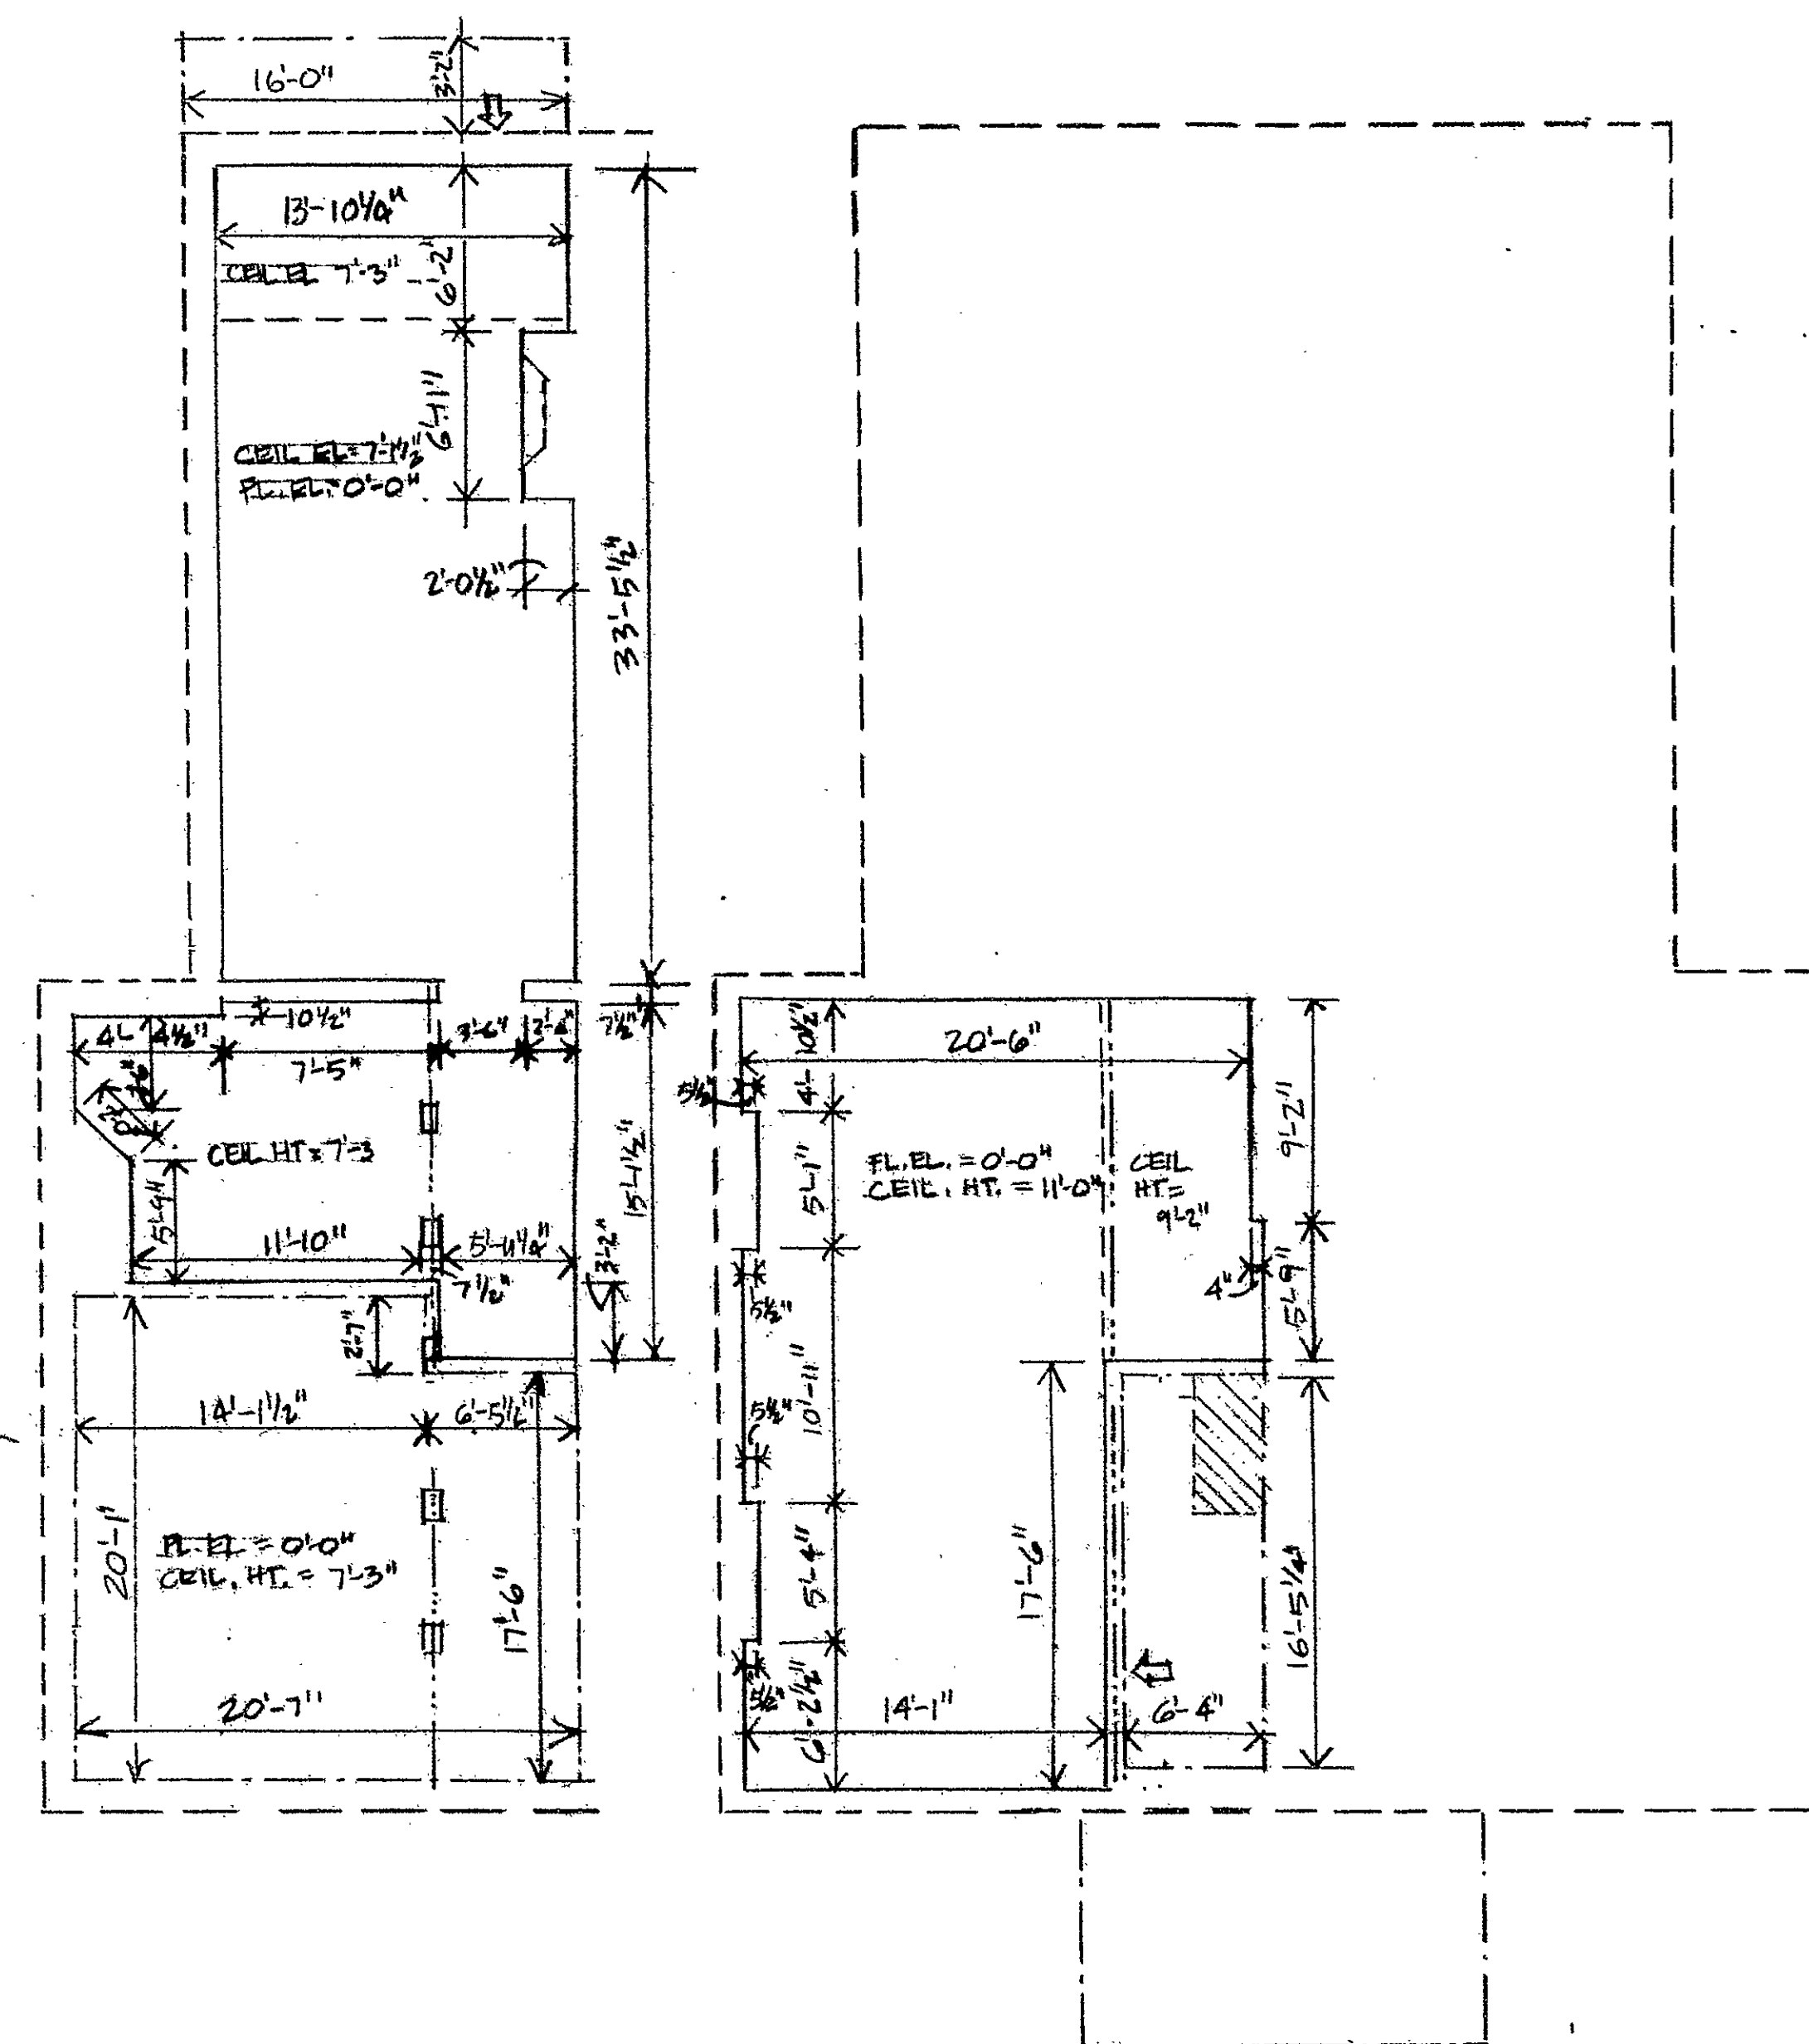

BASEMENT FLOOR

FIRST FLOOR

Certification


The undersigned does hereby certify that to the best of his knowledge and belief, these plans contain all information required by Connecticut General Statutes Section 47-228 relating to plans.

*John T. Wilcox Jr.*

All elevations are referenced to the finished floor at each level (0'-0"). All other elevations are ± (±'-").



Scale in feet.

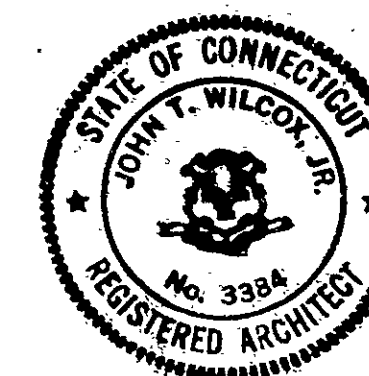

|   |                                   |
|---|-----------------------------------|
| REF. NORTH   | CONGRESS STREET CONDOMINIUM, LTD. |
| Declarant   |                                   |
| LEGEND   |                                   |
| <ul style="list-style-type: none"><li>UNIT BOUNDARY</li><li>EXT. SURFACE</li><li>CEIL. ELEV. CHANGE</li><li>LTD. COMM. ELEM.</li><li>FLOOR ELEV. CHANGE</li><li>BRNG PART OR BEAM</li><li>MASONRY MASS</li><li>SLOPED CEIL. AREA</li></ul> |                                   |
| John T. Wilcox Jr. R.A.<br>ARCHITECT<br>37 Orchard Rd<br>Farmington, Conn. 06032<br>203 678-1945   | UNIT<br>C 69a                     |



Condo # 103