



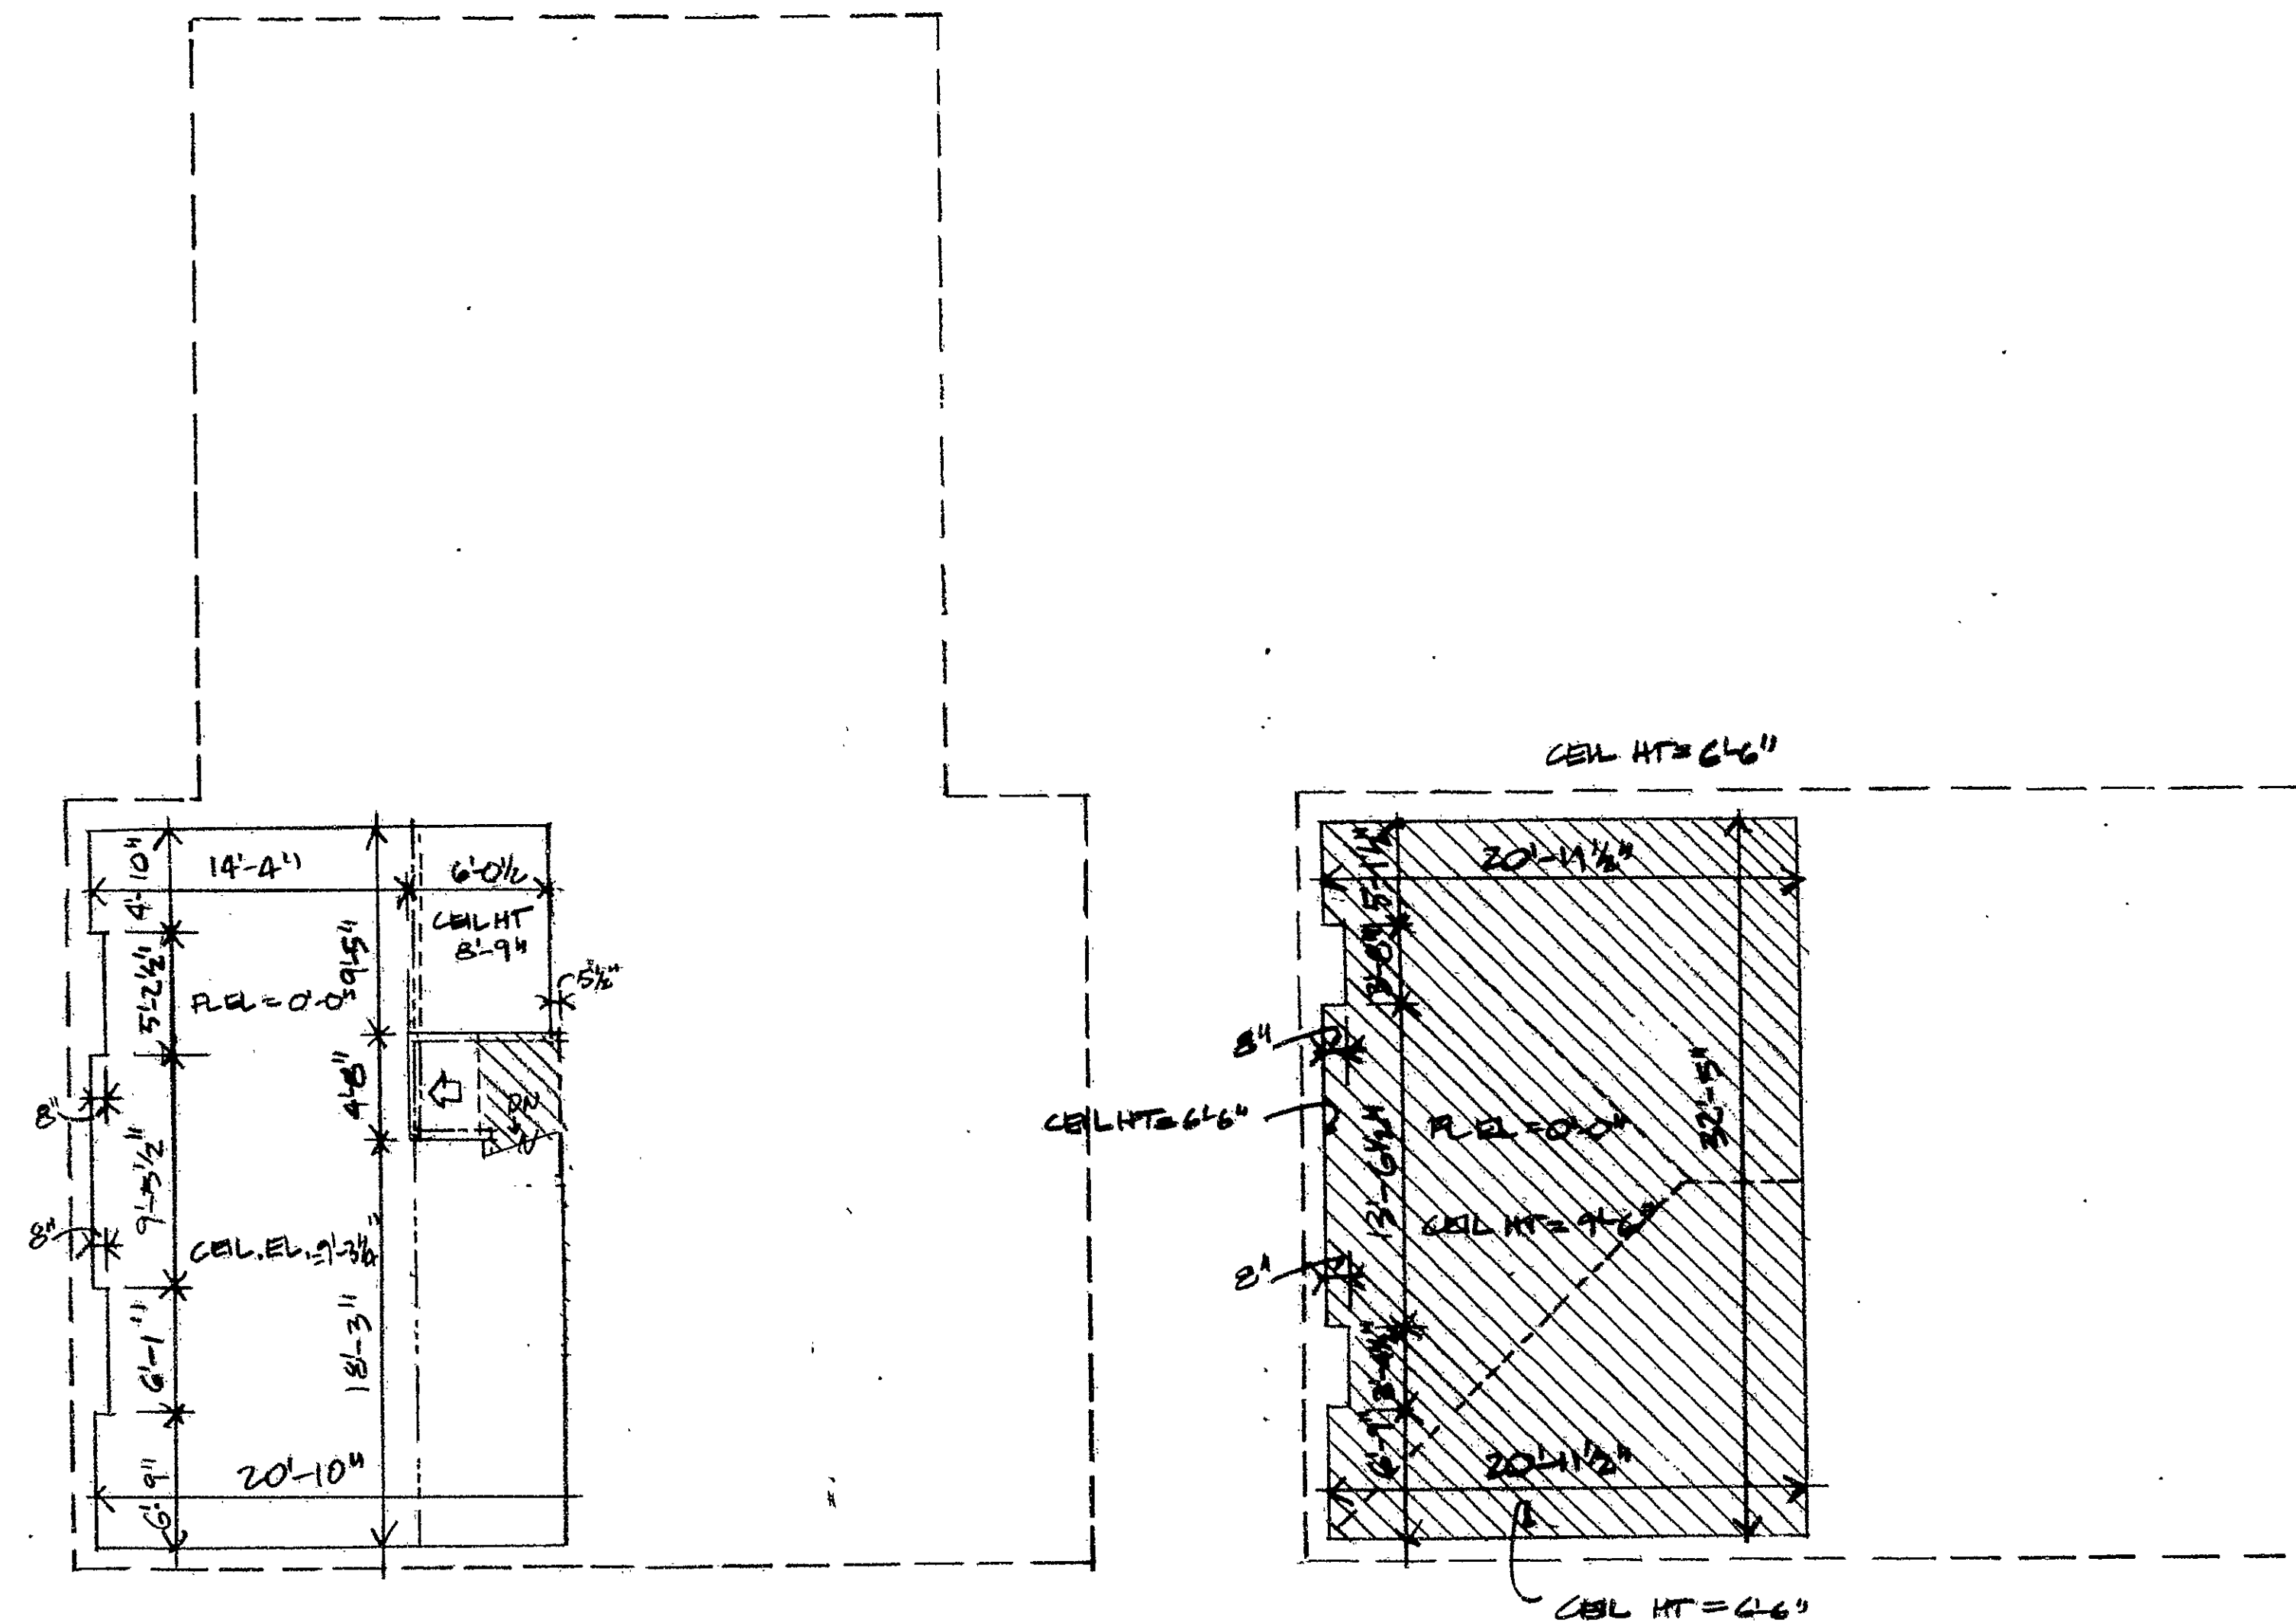

SECOND FLOOR


THIRD FLOOR

Certification


The undersigned does hereby certify that to the best of his knowledge and belief, these plans contain all information required by Connecticut General Statutes Section 47-228 relating to plans.

John T. Wilcox Jr.


All elevations are referenced to the finished floor at each level (0'-0"). All other elevations are $\pm$ (_'- _").

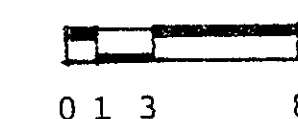

Scale in feet.

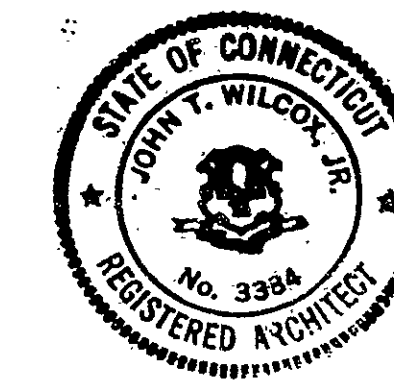

REF. NORTH	CONGRESS STREET CONDOMINIUM, LTD.
Declarant	
LEGEND	
- UNIT BOUNDARY - EXT. SURFACE - CEIL. ELEV. CHANGE - LTD. COMM. ELEM. - FLOOR ELEV. CHANGE - BRNG PART OR BEAM - MASONRY MASS - SLOPED CEIL. AREA	
John T. Wilcox Jr. R.A. ARCHITECT 37 Orchard Rd Farmington, Conn. 06032 203 678-1945	UNIT C 73b

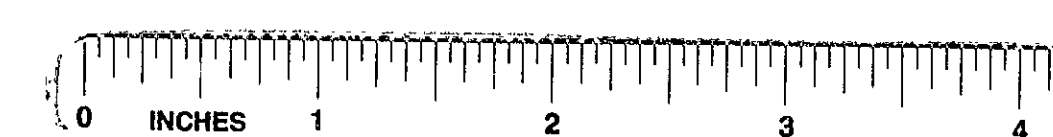

Condo # 103