


RECEIVED BY  
FEB 14 11 55 AM '80  
TODAY  
VOL

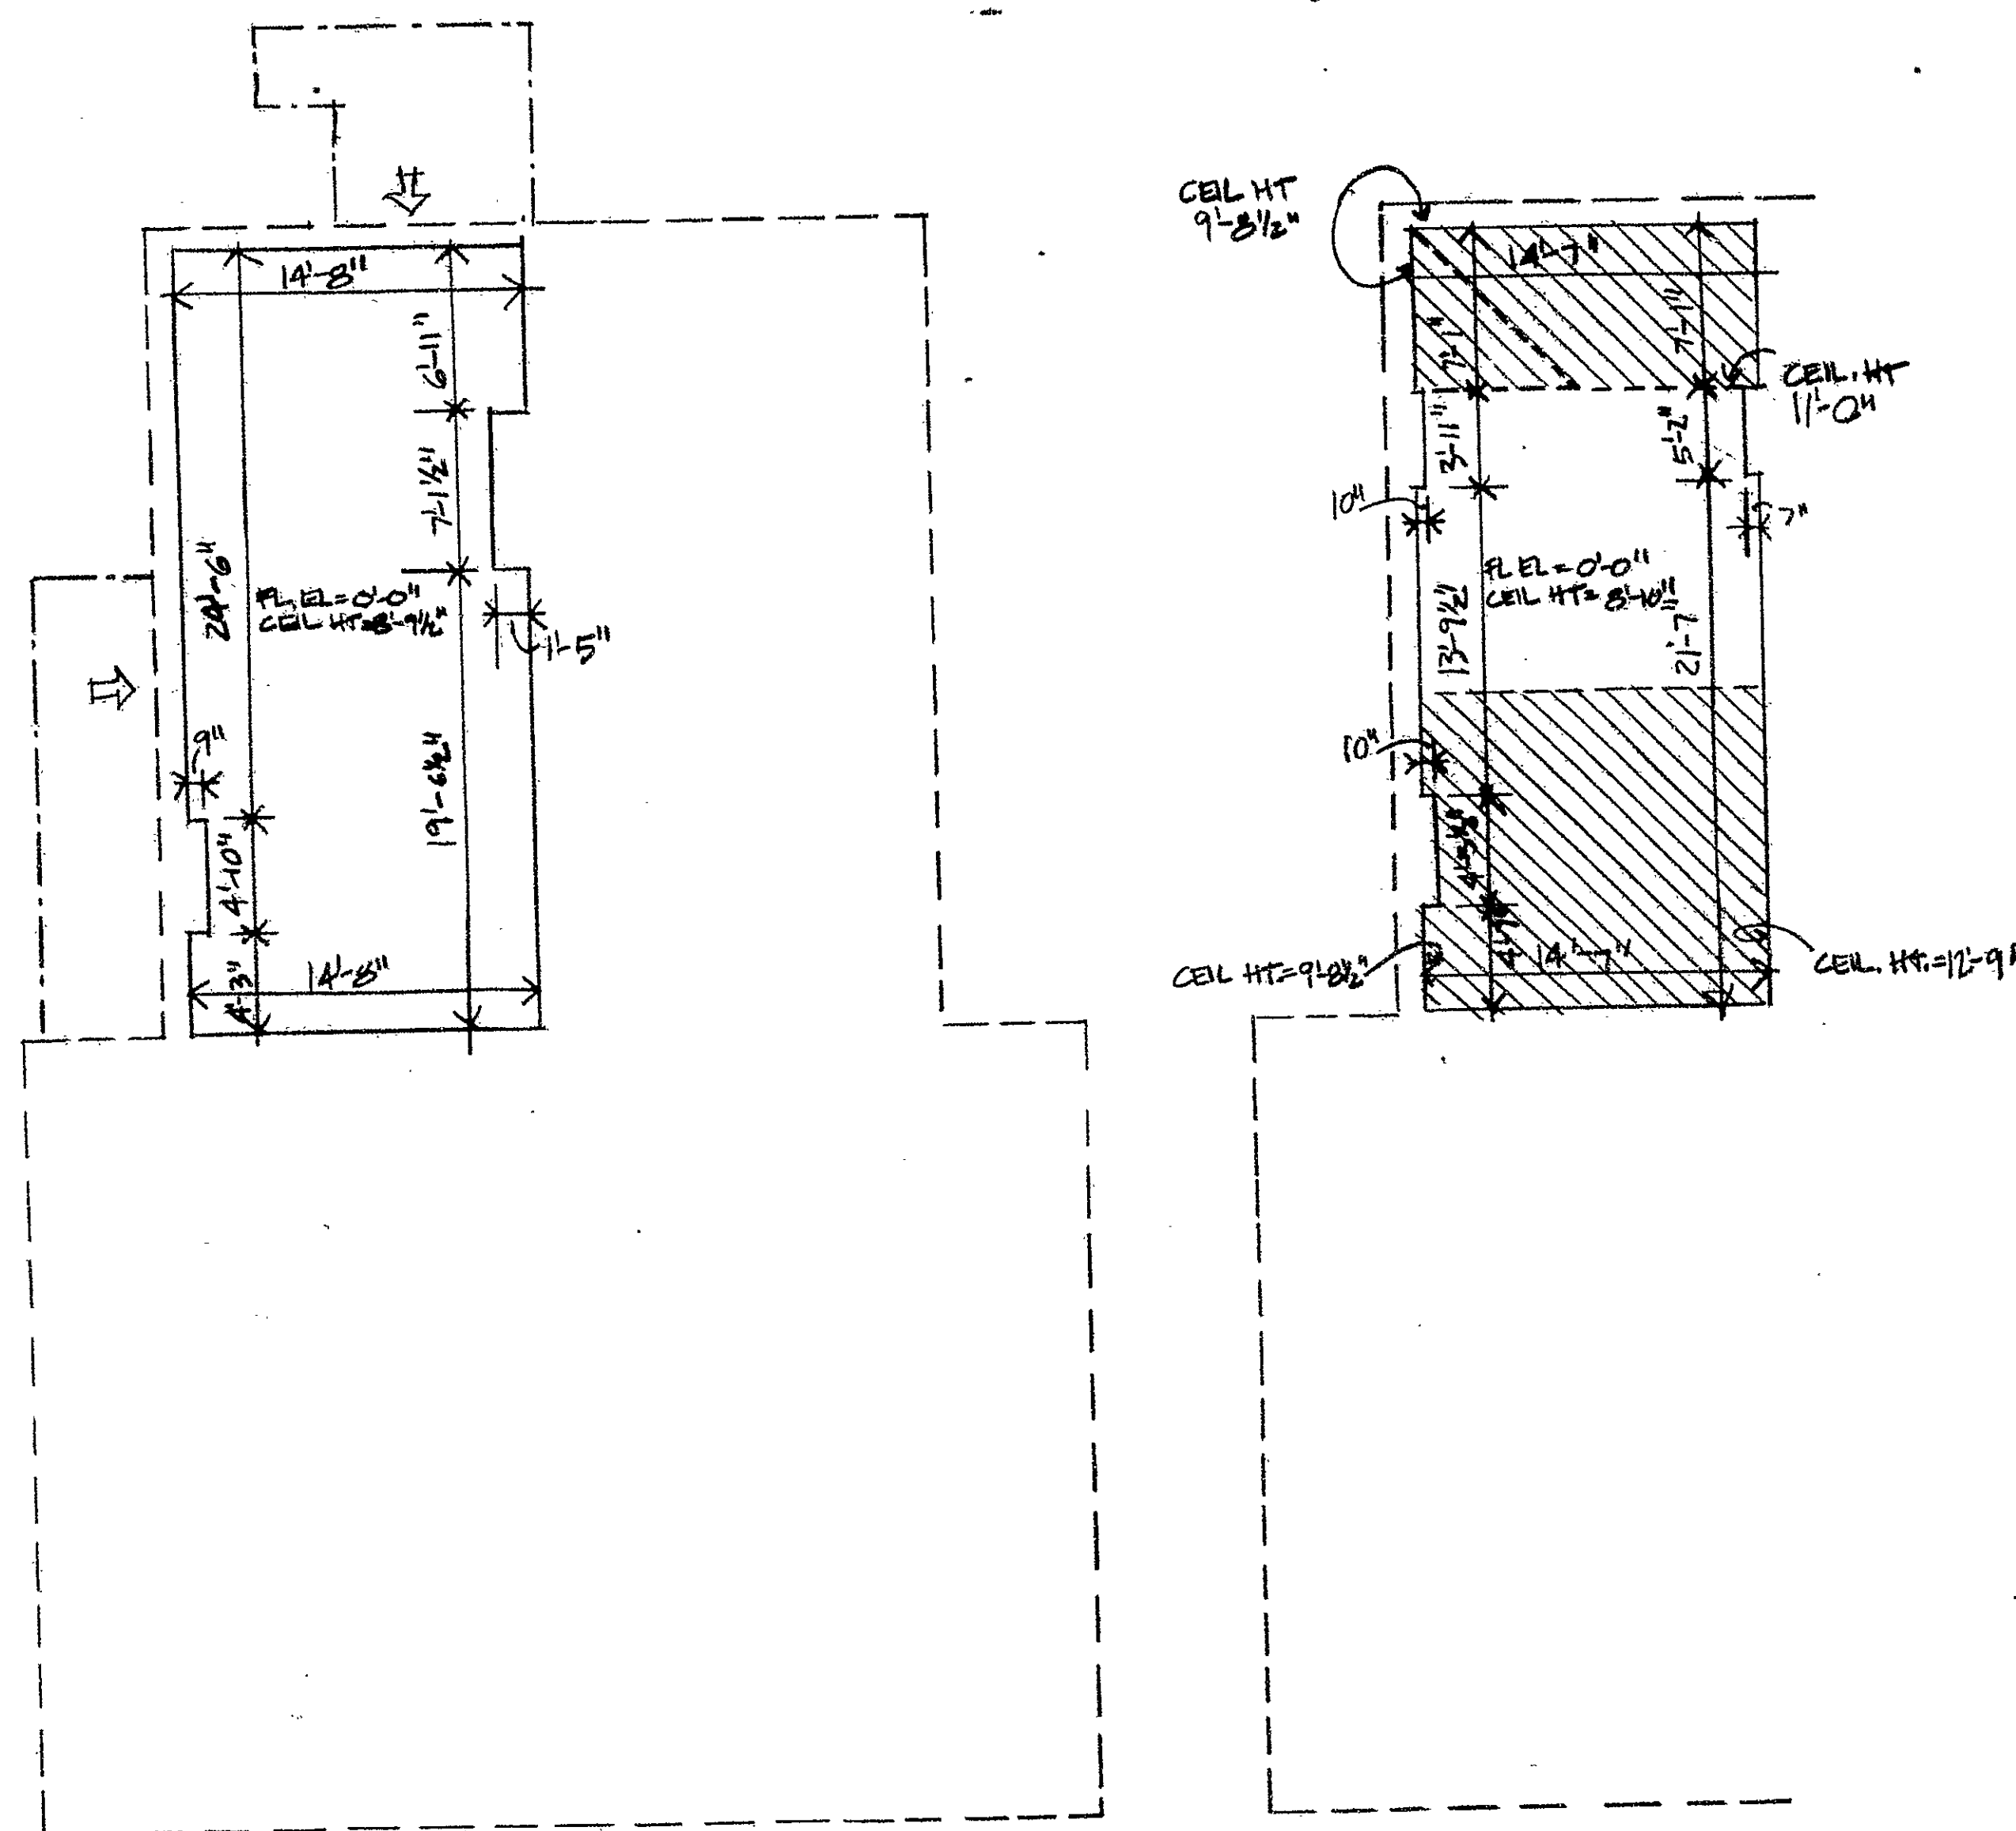

FIRST FLOOR

SECOND FLOOR

Certification


The undersigned does hereby certify that to the best of his knowledge and belief, these plans contain all information required by Connecticut General Statutes Section 47-228 relating to plans.

*John T. Wilcox Jr.*

All elevations are referenced to the finished floor at each level (0'-0"). All other elevations are ± ("'-").

0 1 3 8

Scale in feet.

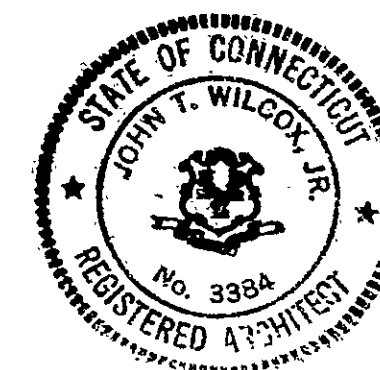

|                                                                                                  |                                   |
|--------------------------------------------------------------------------------------------------|-----------------------------------|
| REF. NORTH                                                                                       | CONGRESS STREET CONDOMINIUM, LTD. |
| Declarant                                                                                        |                                   |
| LEGEND                                                                                           |                                   |
| —                                                                                                | UNIT BOUNDARY                     |
| - - -                                                                                            | EXT. SURFACE                      |
| - - -                                                                                            | CEIL. ELEV. CHANGE                |
| - - -                                                                                            | LTD. COMM. ELEM.                  |
| - - -                                                                                            | FLOOR ELEV. CHANGE                |
| - - -                                                                                            | BRNG PART OR BEAM                 |
| □                                                                                                | MASONRY MASS                      |
| ▨                                                                                                | SLOPED CEIL. AREA                 |
| John T. Wilcox Jr. R.A.<br>ARCHITECT<br>37 Orchard Rd<br>Farmington, Conn. 06032<br>203 678-1945 | UNIT<br>C 73c                     |

0 INCHES 1 2 3 4 Condo # 103