

104


All elevations are referenced to top of slab in Basement of each unit (0'-0"). All other elevations are + (_ - ").

Certification


The undersigned does hereby certify that to the best of his knowledge and belief these plans contain all information required by Connecticut General Statutes Section 47-228 relating to plans.

David G. Helms


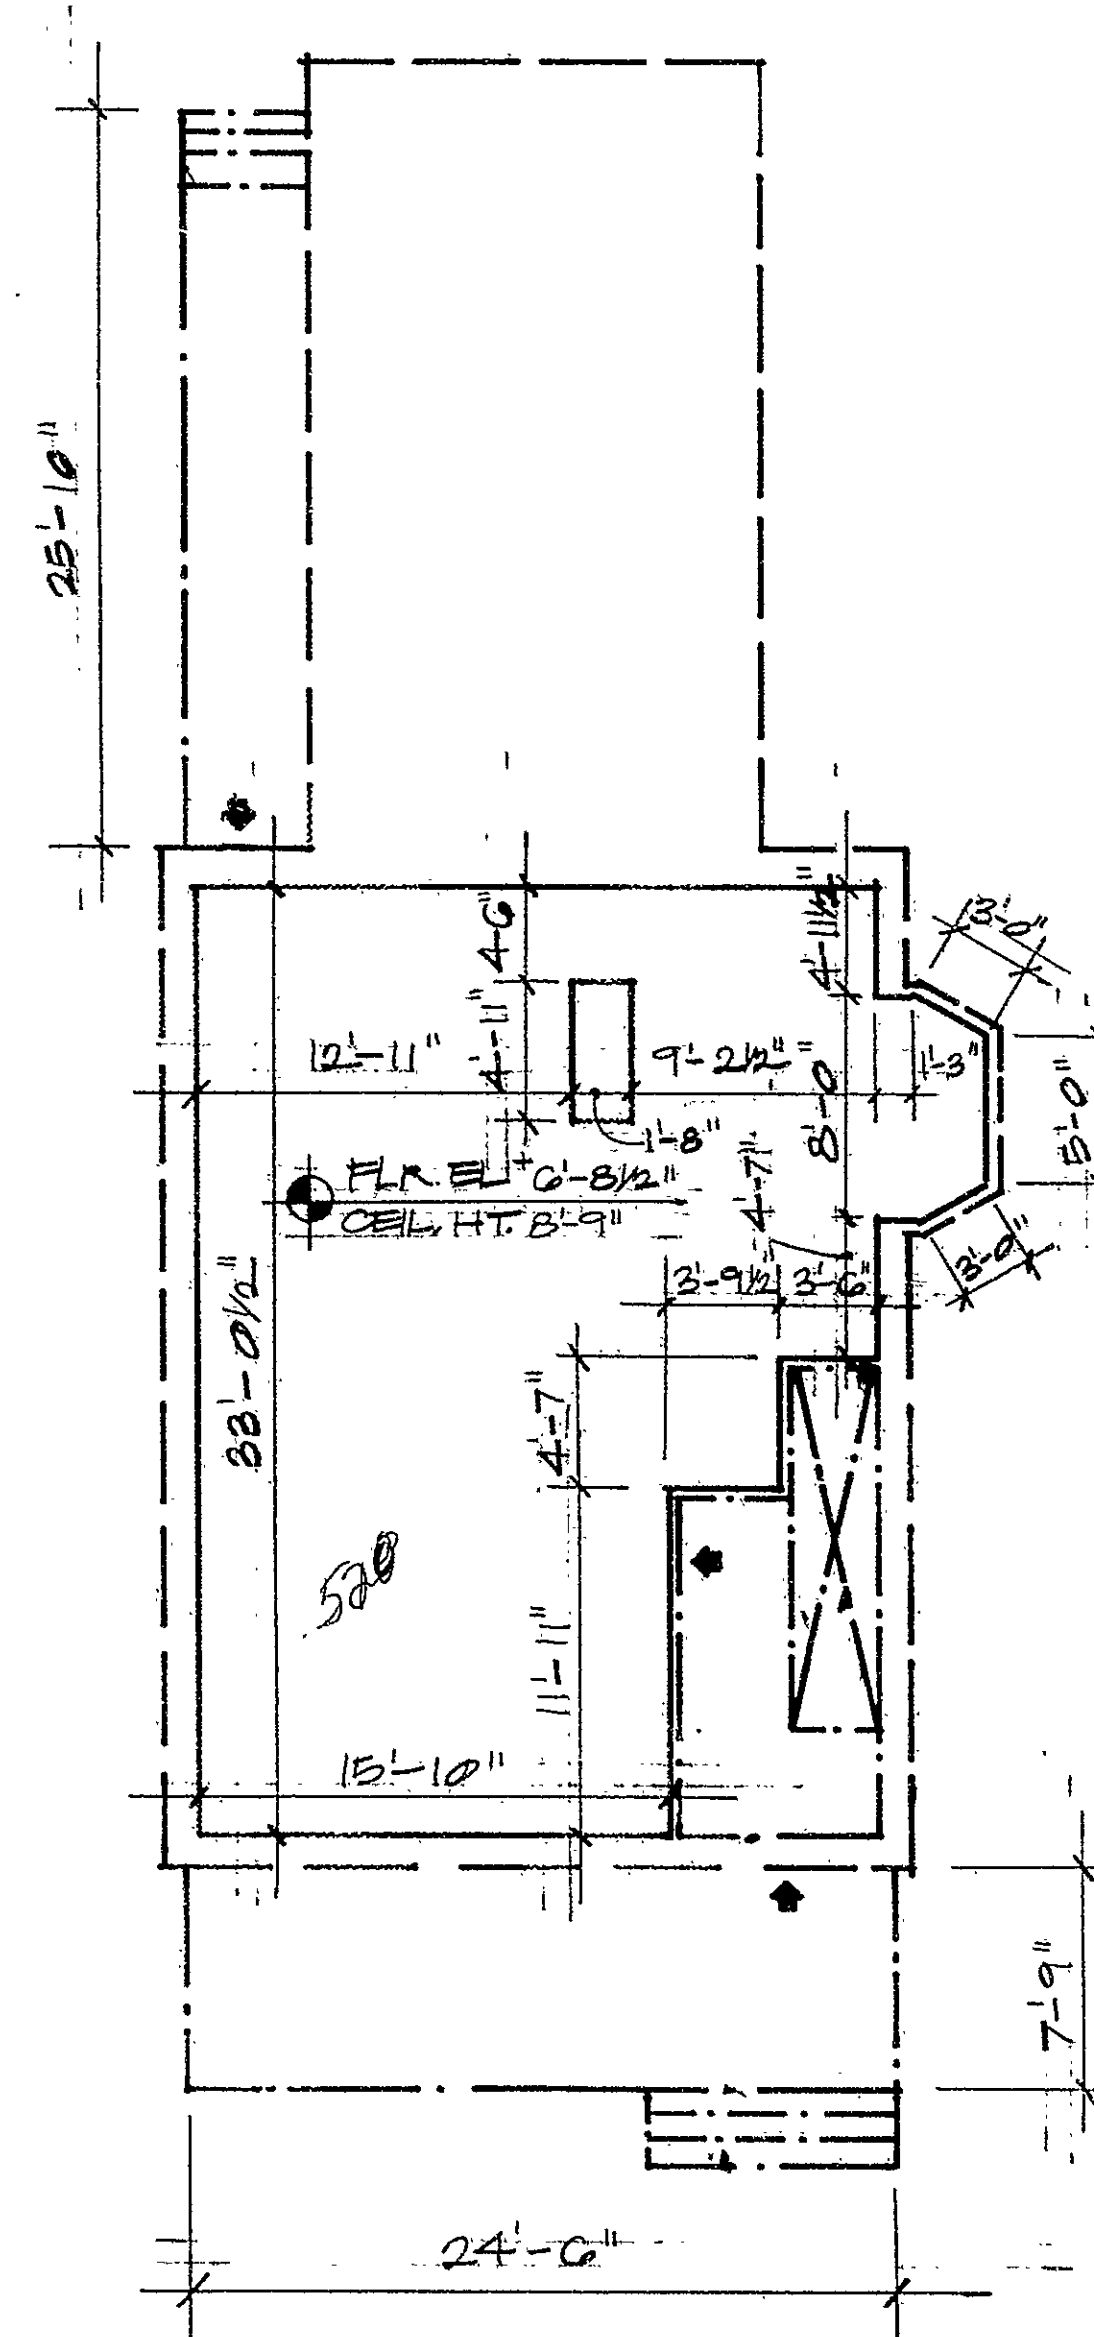

FIRST

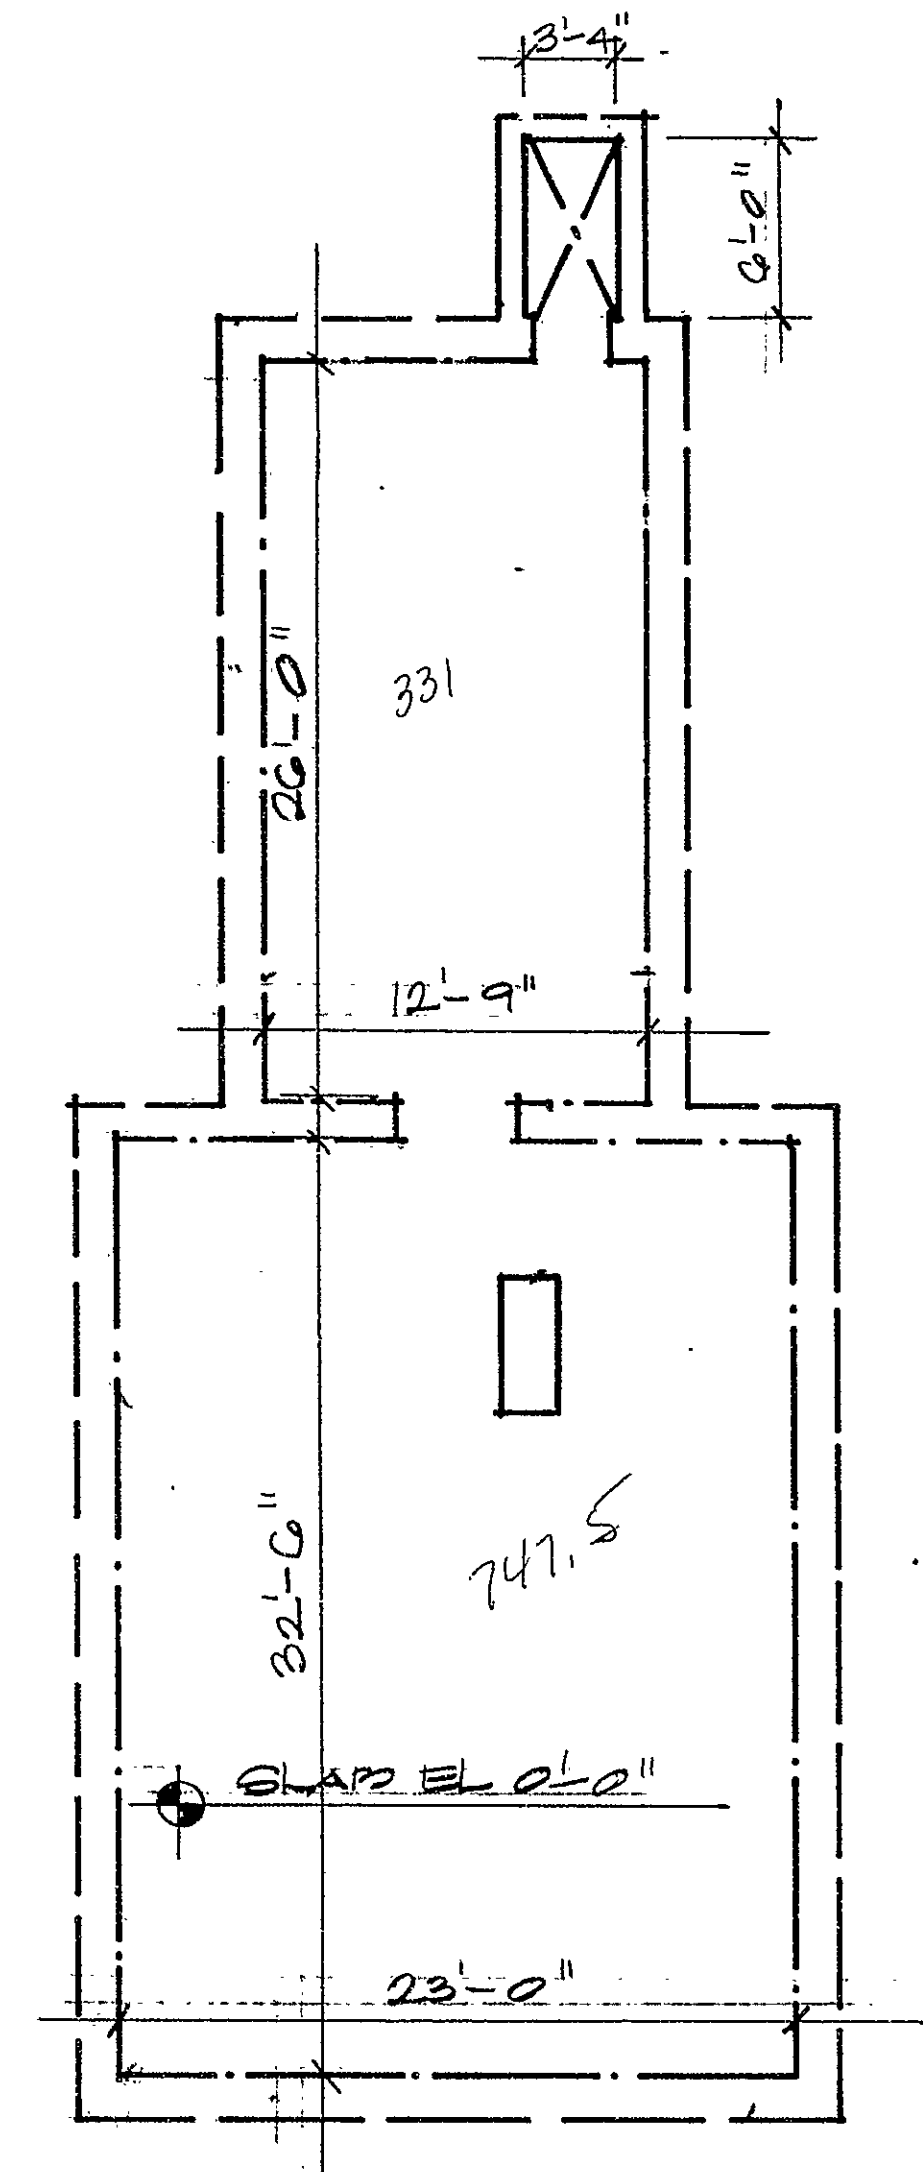

BASEMENT LIMITED COMMON ELEMENT



**CAPITAL
STUDIO**
architects

**Congress Street
Condominium, Ltd.**
Declarant

LEGEND

UNIT BOUNDARY

EXT. SURFACE

ELEV. CHANGE

LTD. COMM. ELE.

CEIL./HT. CHANGE

SLOPE CEIL.
ABOVE

UNIT
M-29

SHEET
1

0 2 4 8

north