

100 05/18/2010
100 11/13/10 13 mil
100 11/13/10 13 mil
100 11/13/10 13 mil
100 11/13/10 13 mil



All elevations are
referenced to top
of slab in Basement
of each unit (0'-0").
All other elevations
are +(-) "

Certification
The undersigned does hereby certify
that to the best of his knowledge
and belief these plans contain all
information required by Connecticut
General Statutes Section 47-228
relating to plans.
David G. Holman

CAPITAL
STUDIO
architects
PROFESSIONAL CORPORATION
100 BOCA BLVD. - HARTFORD, CONNECTICUT 06103

Congress Street
Condominium, Ltd.
Declarant

LEGEND


- UNIT BOUNDARY
- EXT. SURFACE
- ELEV. CHANGE
- LTD. COMM. ELEM.
- CEIL. HT. CHANGE
- SLOPE CEIL. ABOVE

UNIT
M-29b


SHEET
2

0 2 4 8
feet


north
↓

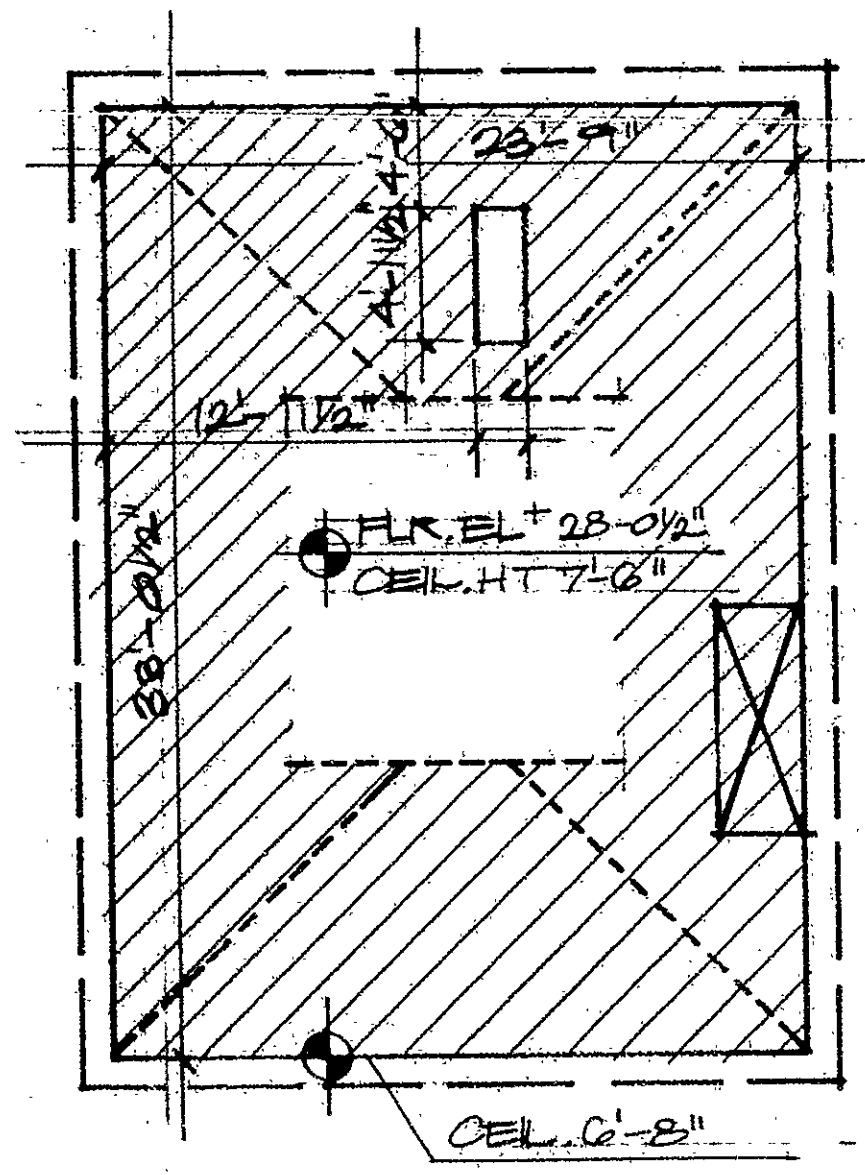

SECOND

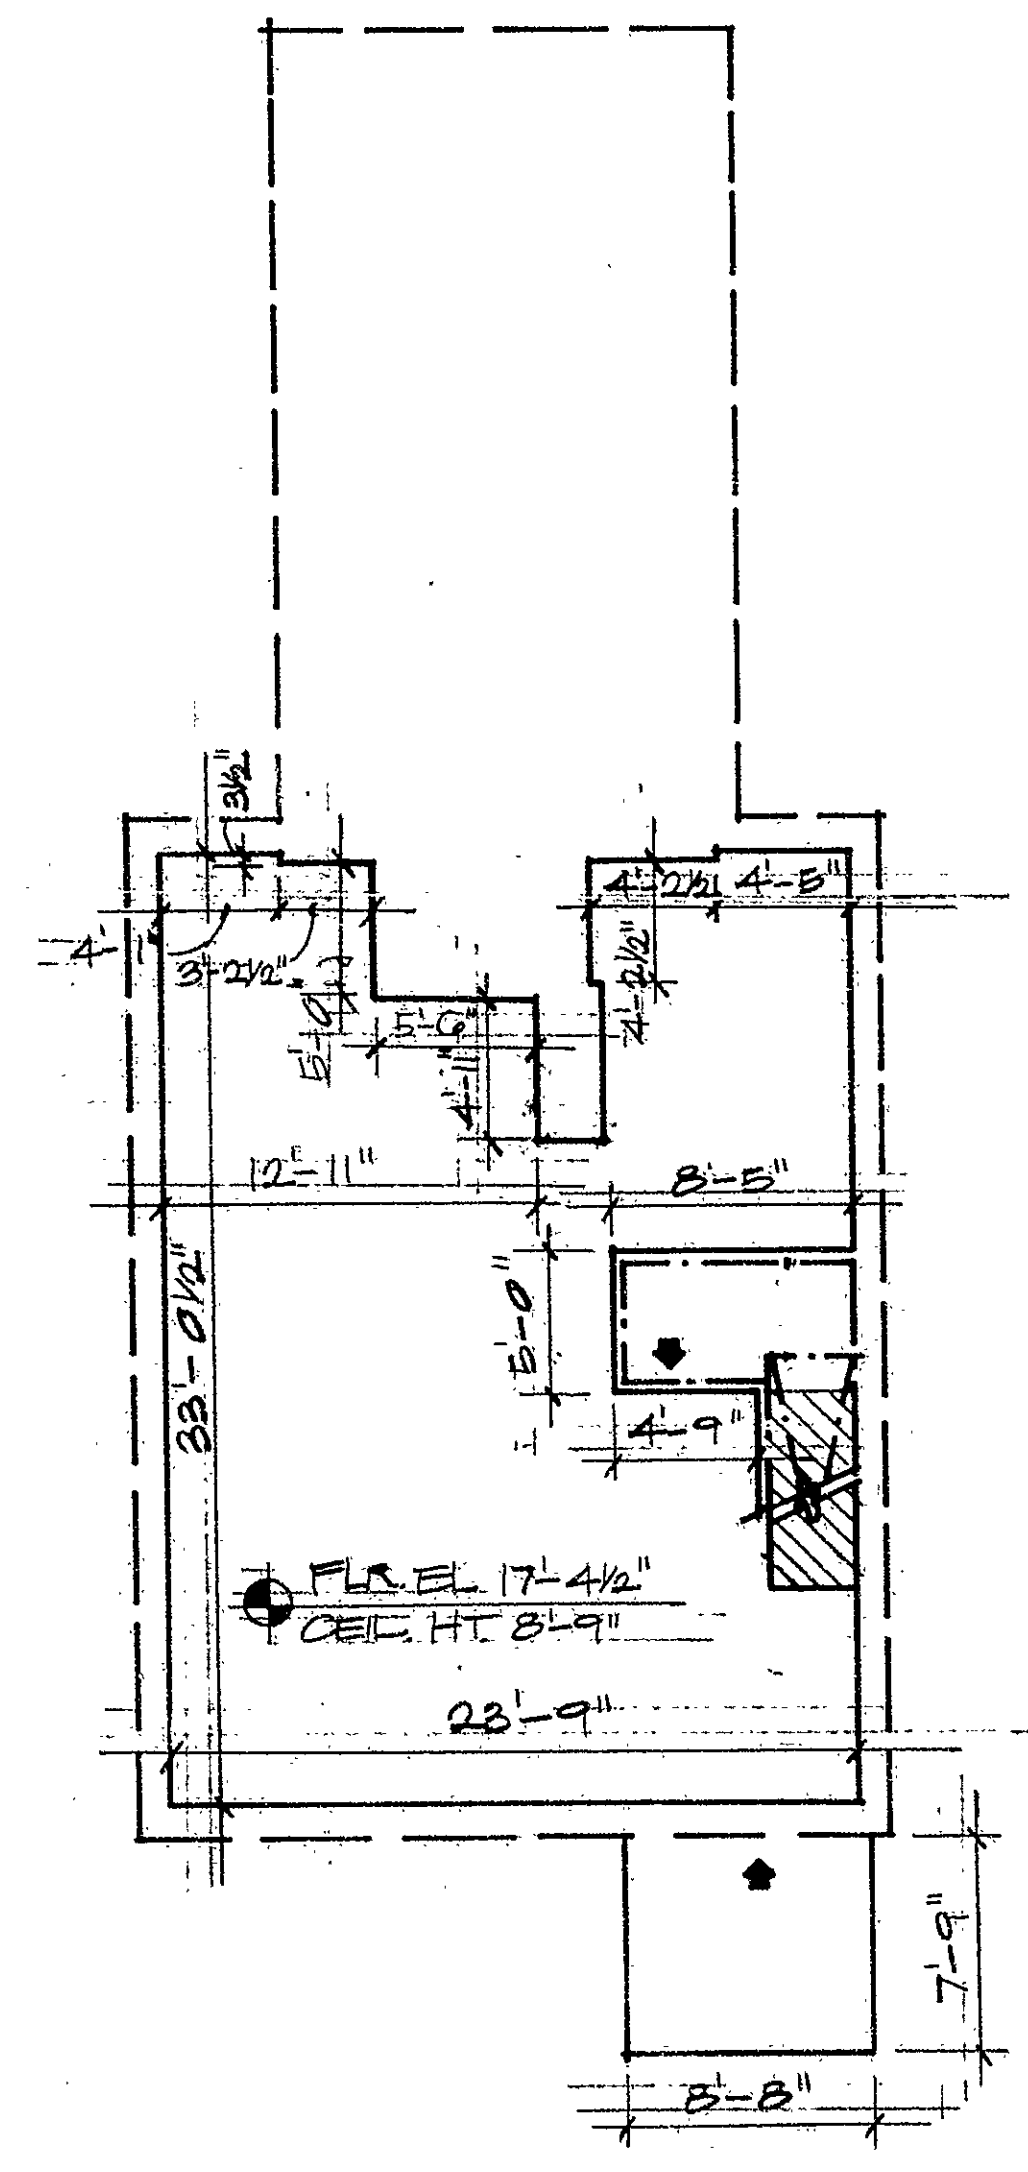

FIRST

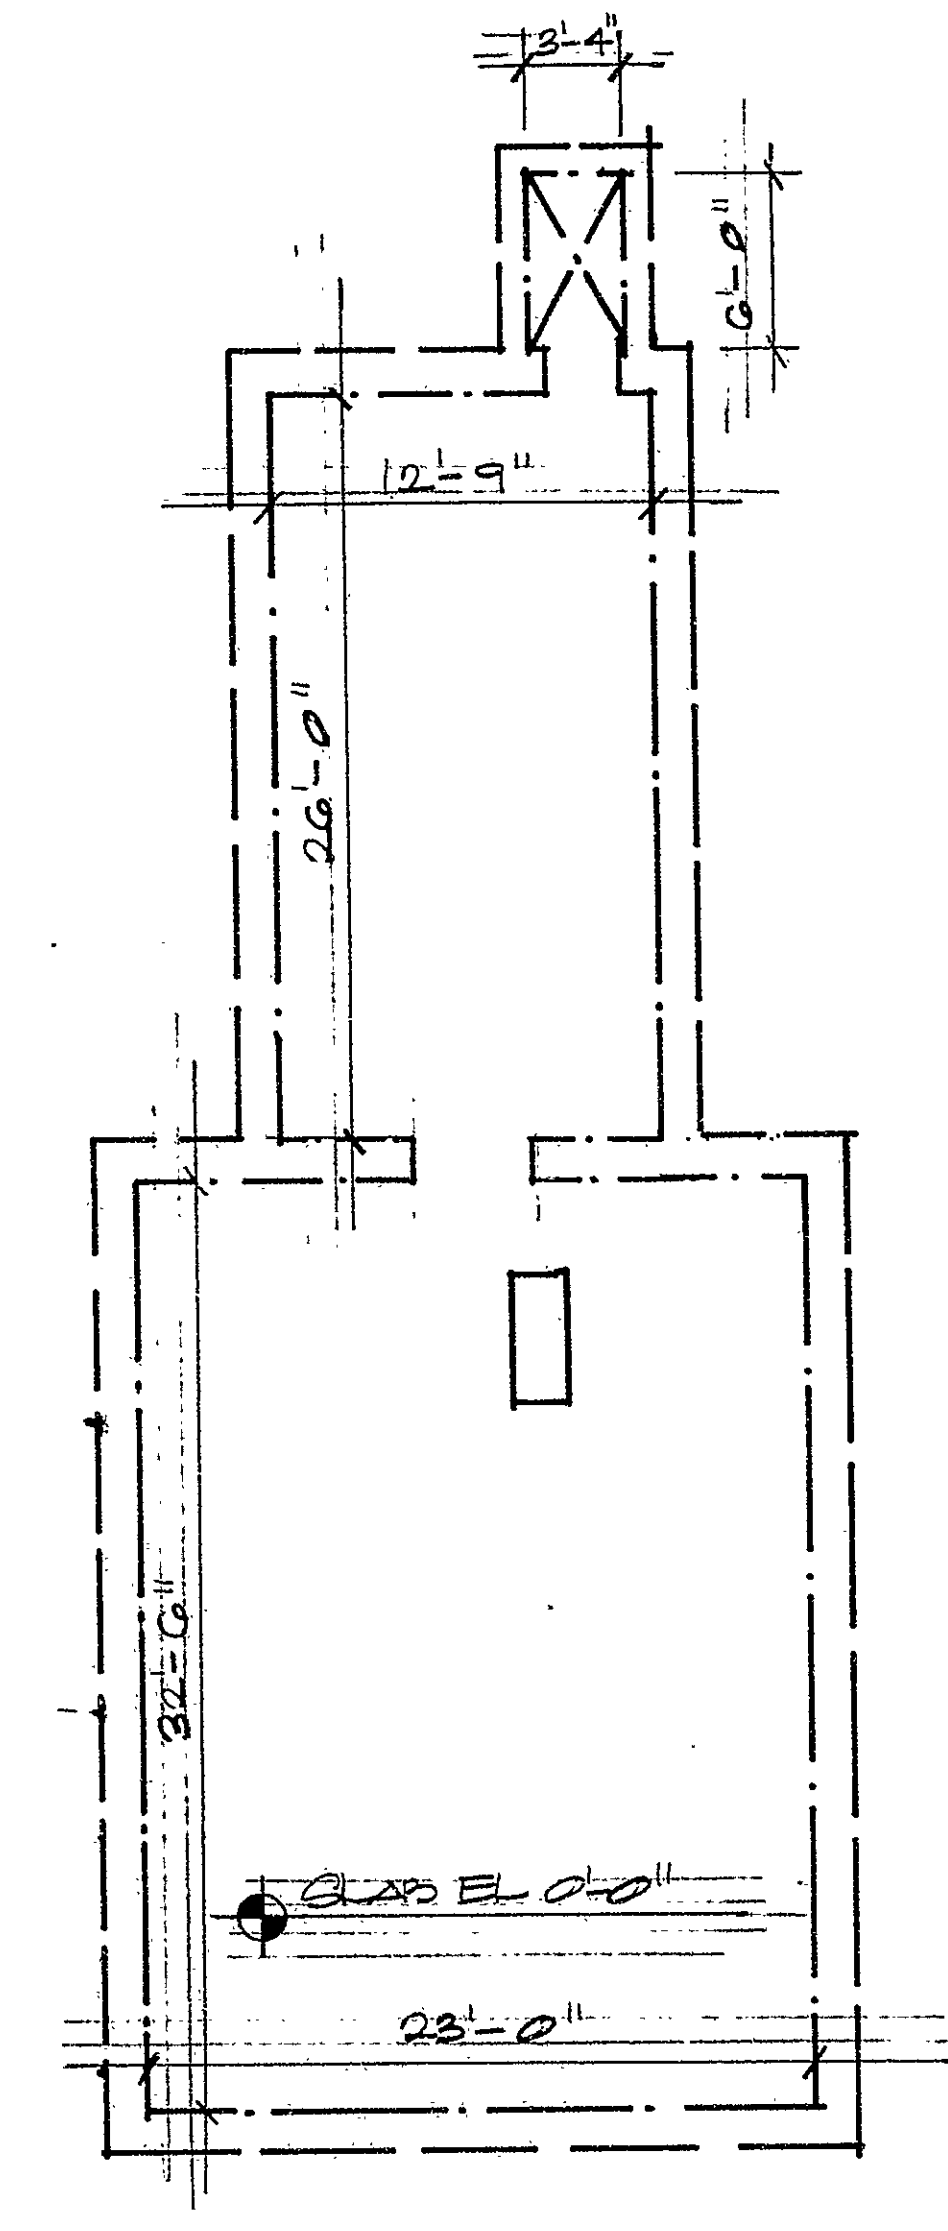

BASEMENT LIMITED COMMON ELEMENT

