


All elevations are referenced to top of slab in Basement of each unit (0'-0"). All other elevations are as noted.



Certification
The undersigned does hereby certify that to the best of his knowledge and belief these plans contain all information required by Connecticut General Statutes Section 47-228 relating to plans.

David G. Heller

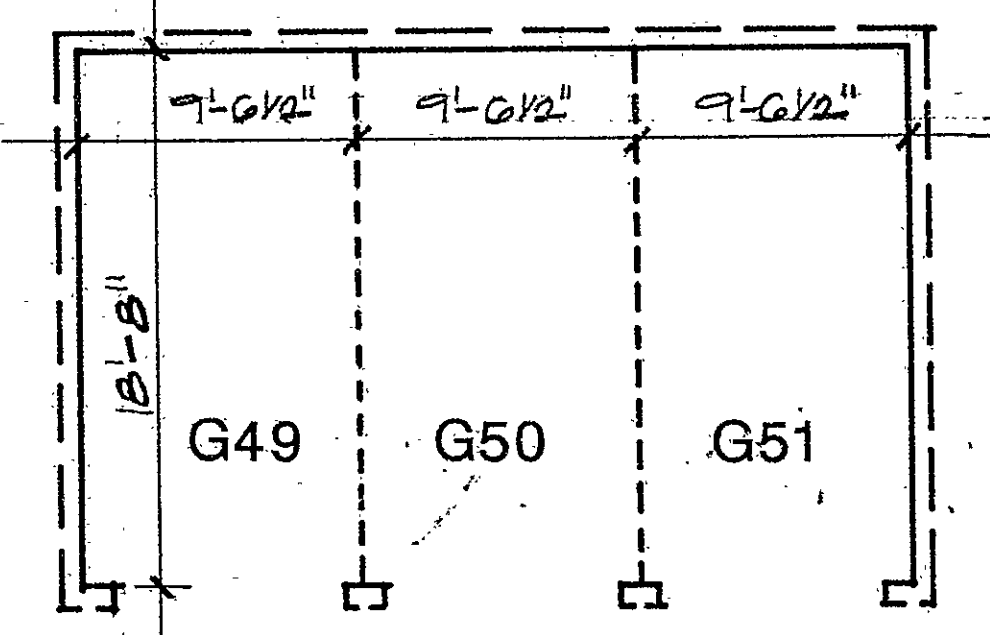

GARAGE


NOT TO SCALE
DATE: 12/15/2010
BY: J. S. M.
CHECKED BY: J. S. M.

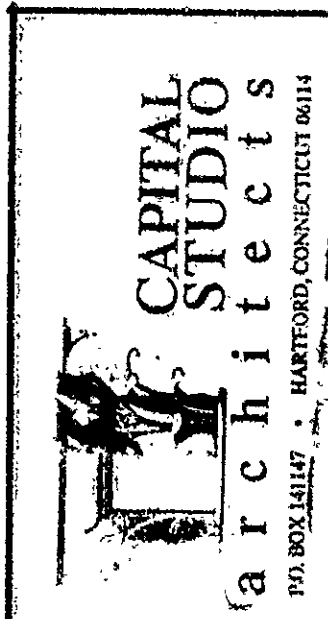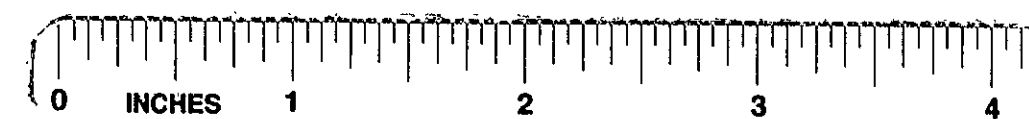

Congress Street
Condominium, Ltd.
Declarant


LEGEND

- UNIT BOUNDARY
- EXT. SURFACE
- ELEV. CHANGE
- LTD. COMM. ELEM.
- CEIL. HT. CHANGE

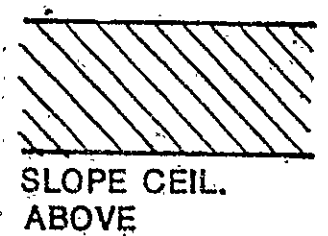

UNIT M29
GARAGES

SHEET
4

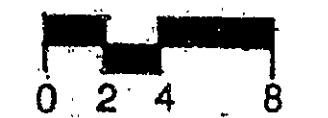

north.