


12-03-1987
02-11-1987 S. L.S. M.M.
2017-12-11-1987
JOY

CASI FILE CORP. IRVINE, CA EPH 34
104 5

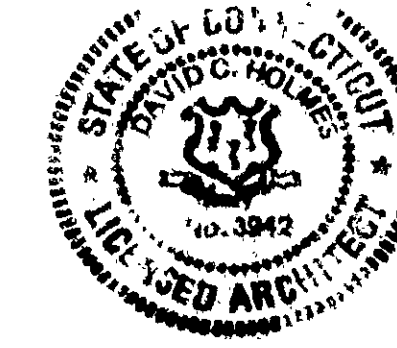


All elevations are referenced to top of slab in Basement of each unit (0'-0"). All other elevations are +(-) ".


Certification

The undersigned does hereby certify that to the best of his knowledge and belief these plans contain all information required by Connecticut General Statutes Section 47-228 relating to plans.



David J. Hines

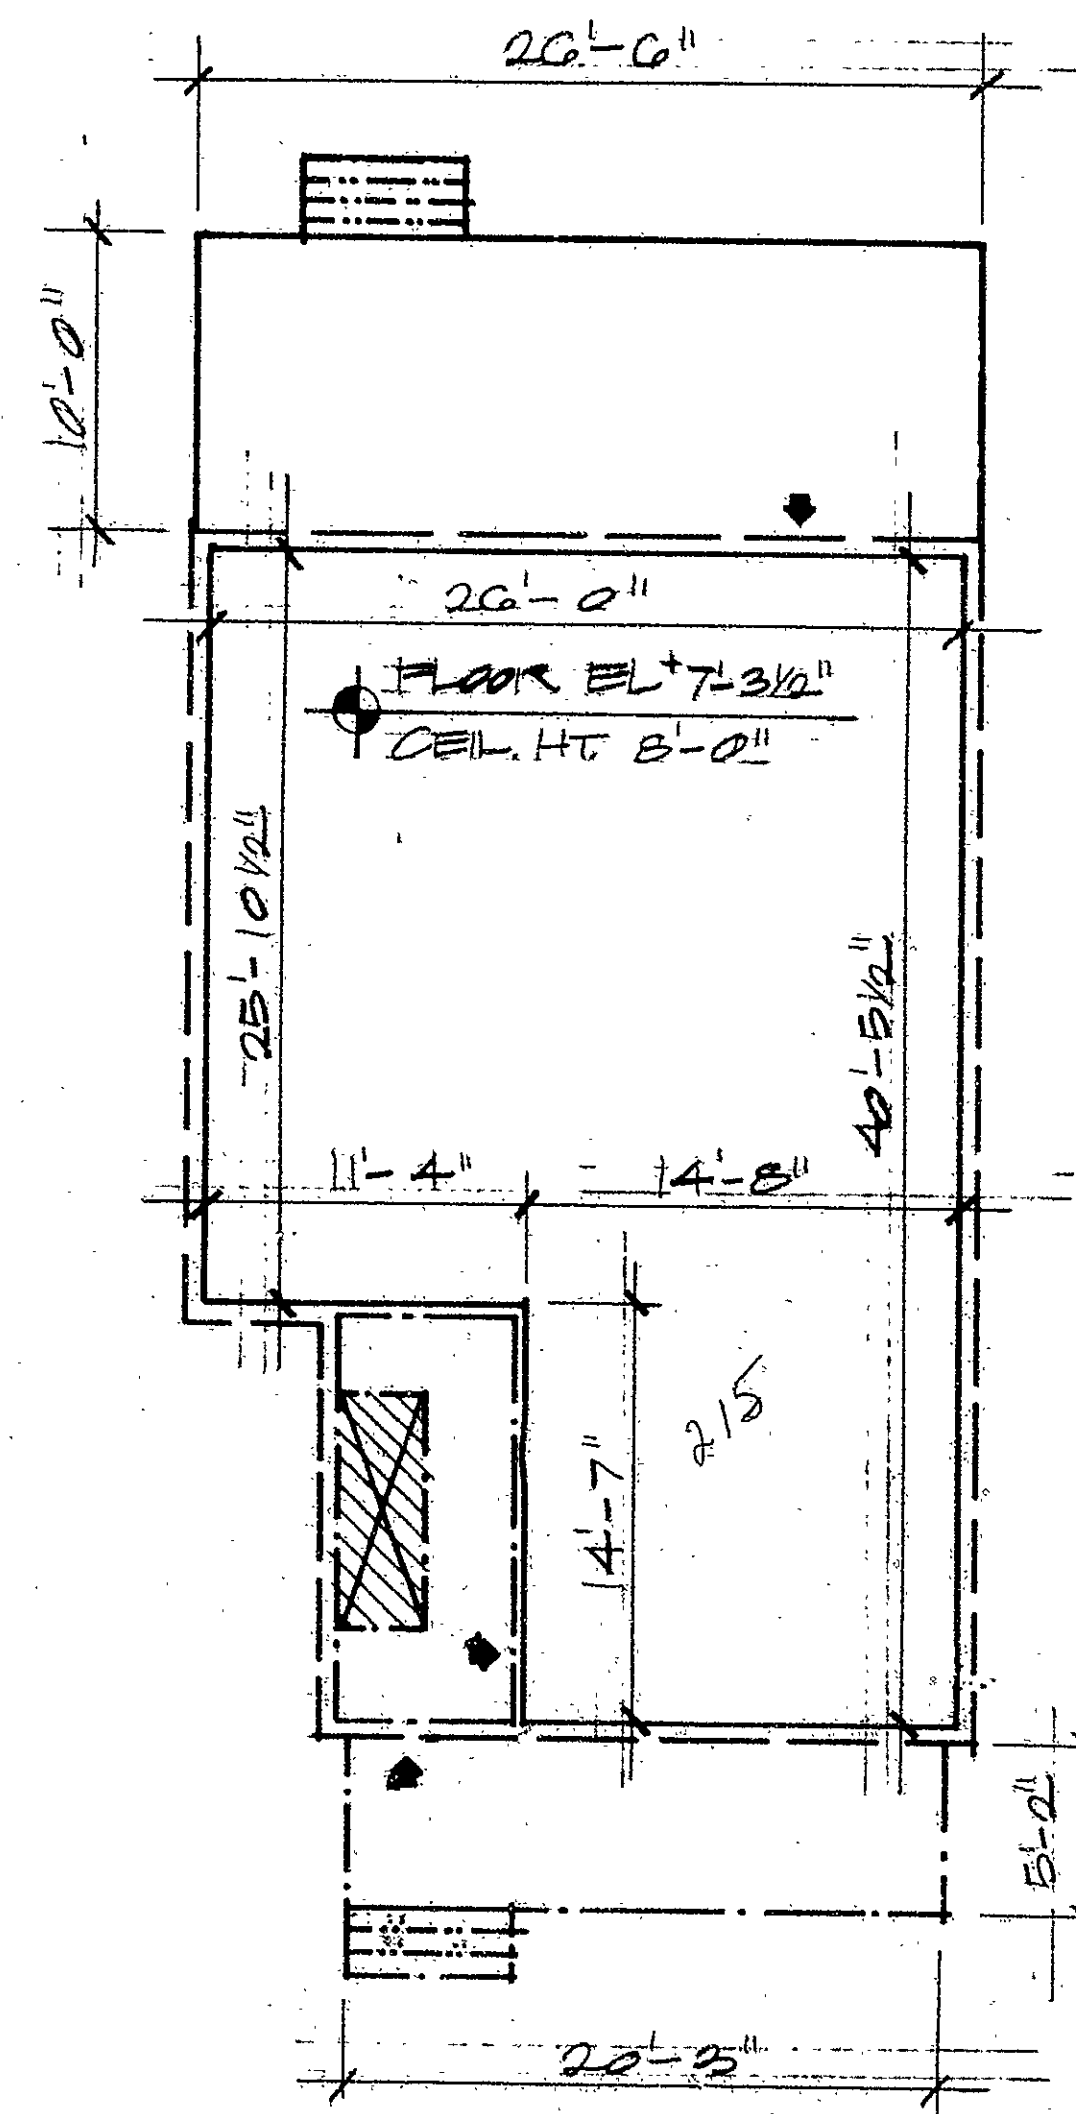

FIRST

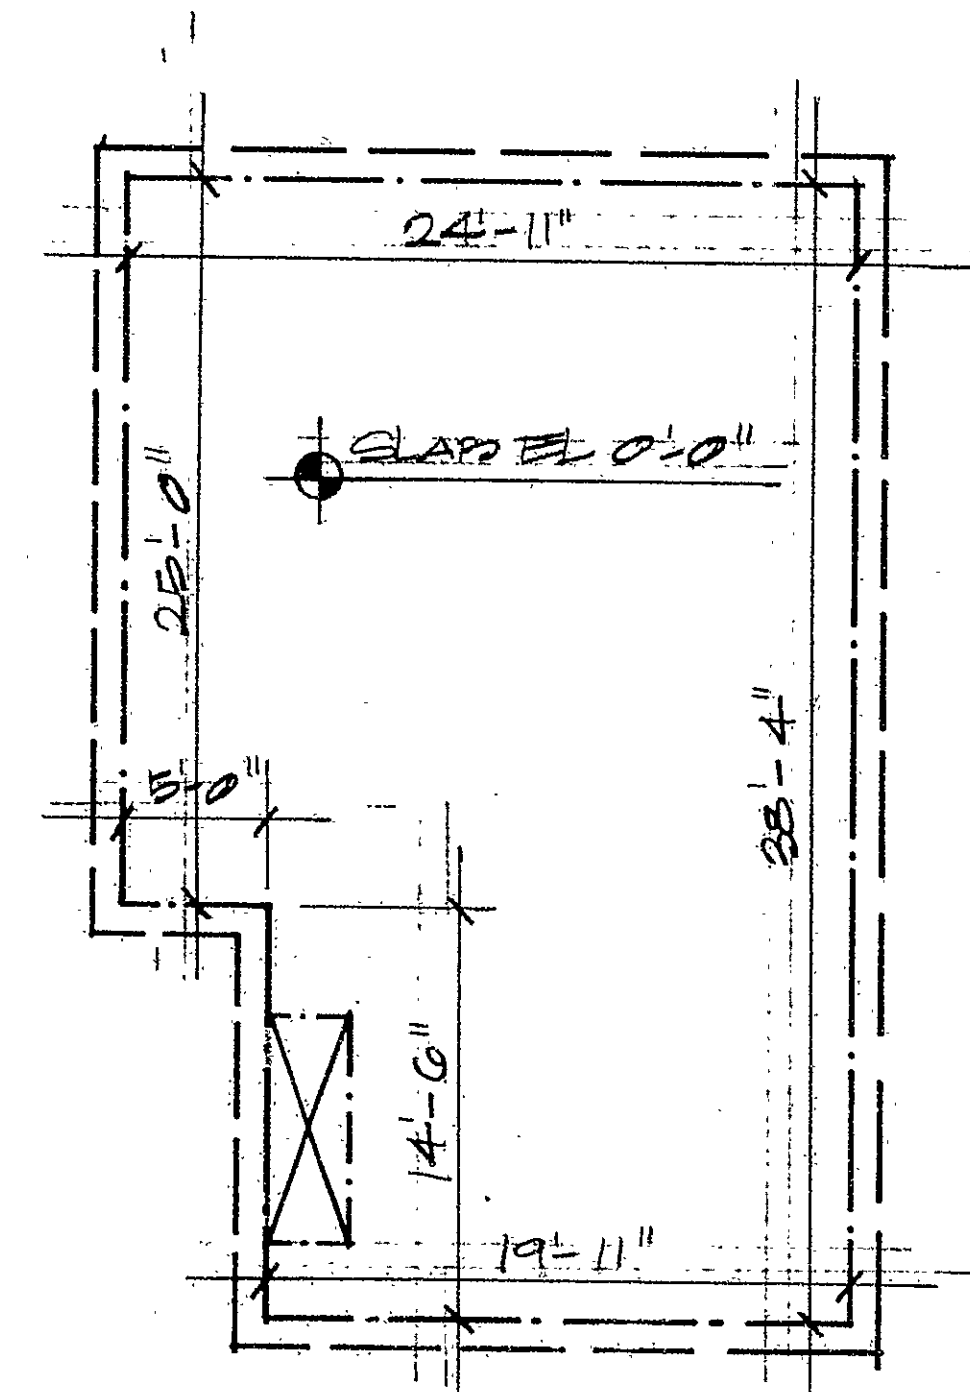


BASEMENT LIMITED COMMON ELEMENT

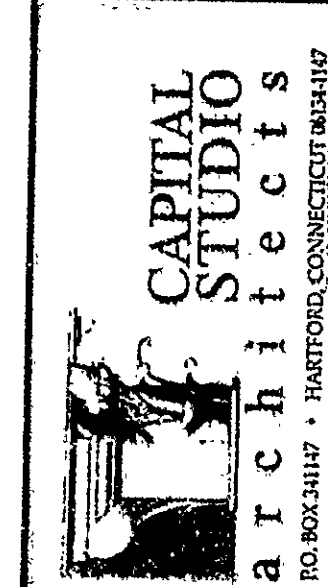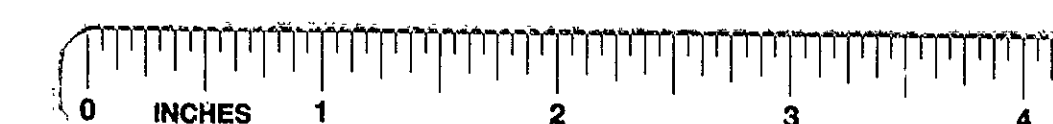

Congress Street
Condominium, Ltd.
Declarant


LEGEND

UNIT BOUNDARY
EXT. SURFACE
ELEV. CHANGE
LTD. COMM. ELEM.
CEIL. HT. CHANGE

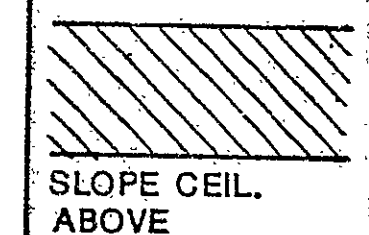

UNIT
M-33a

SHEET
5

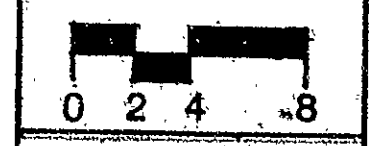

0 2 4 8
north