




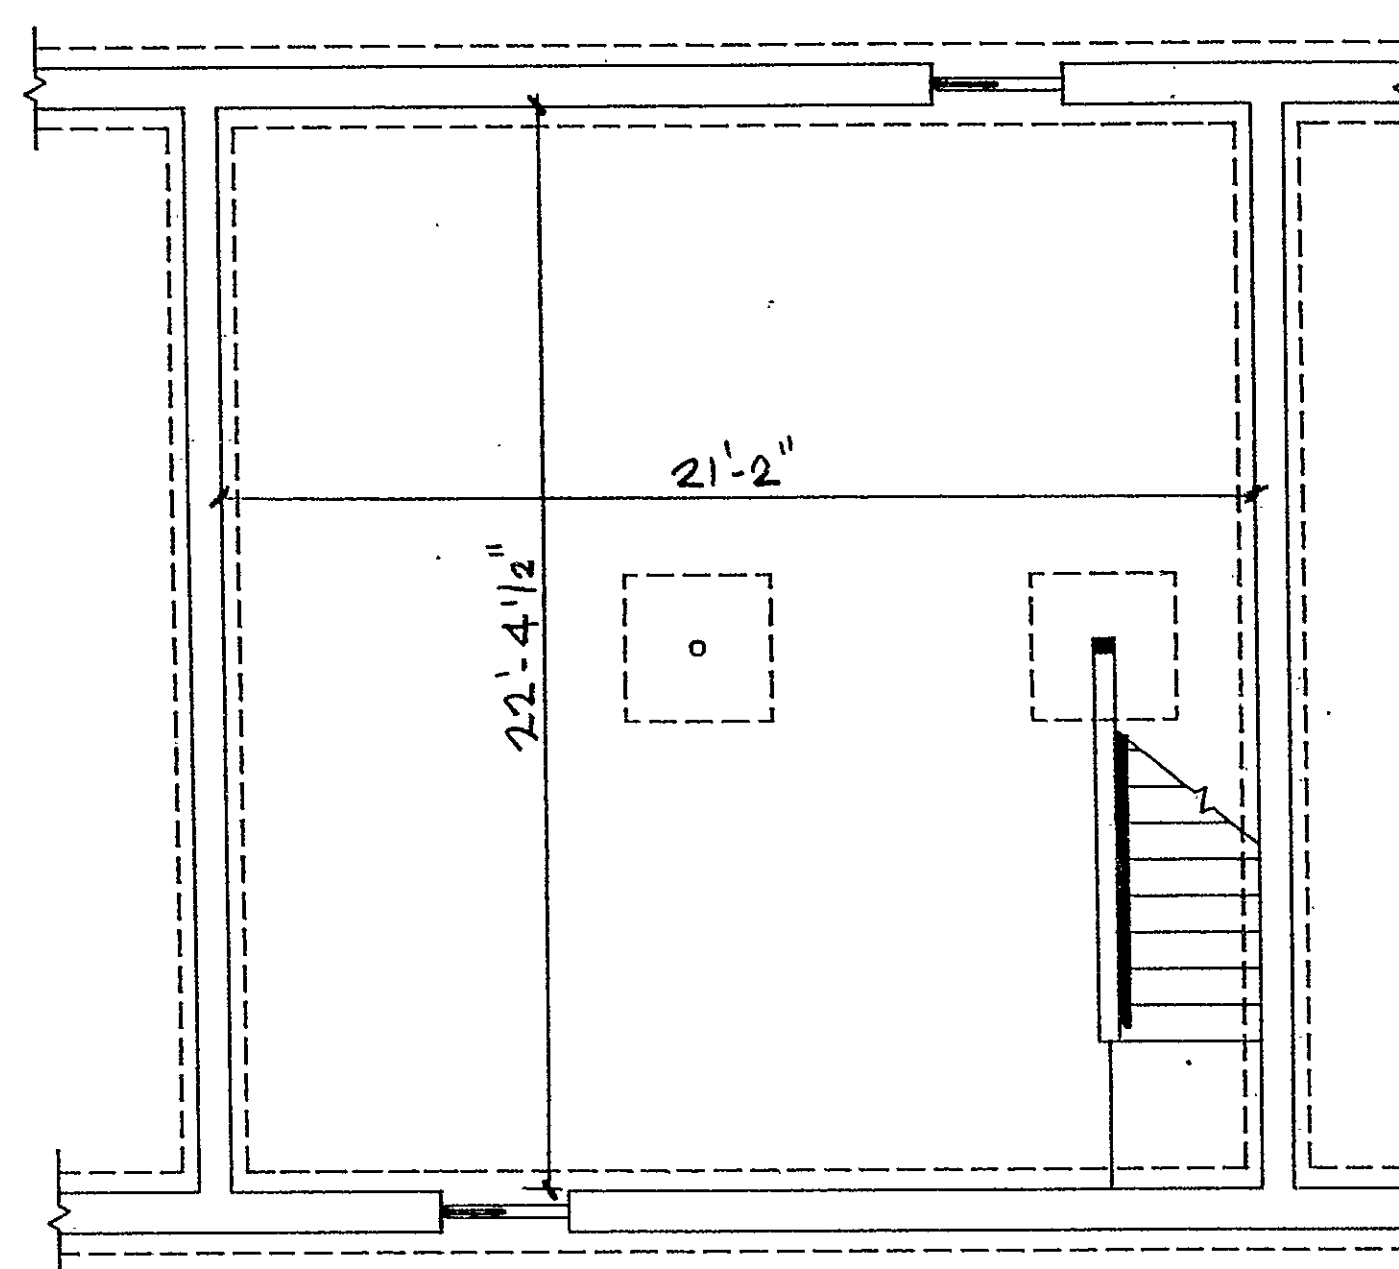


BASEMENT

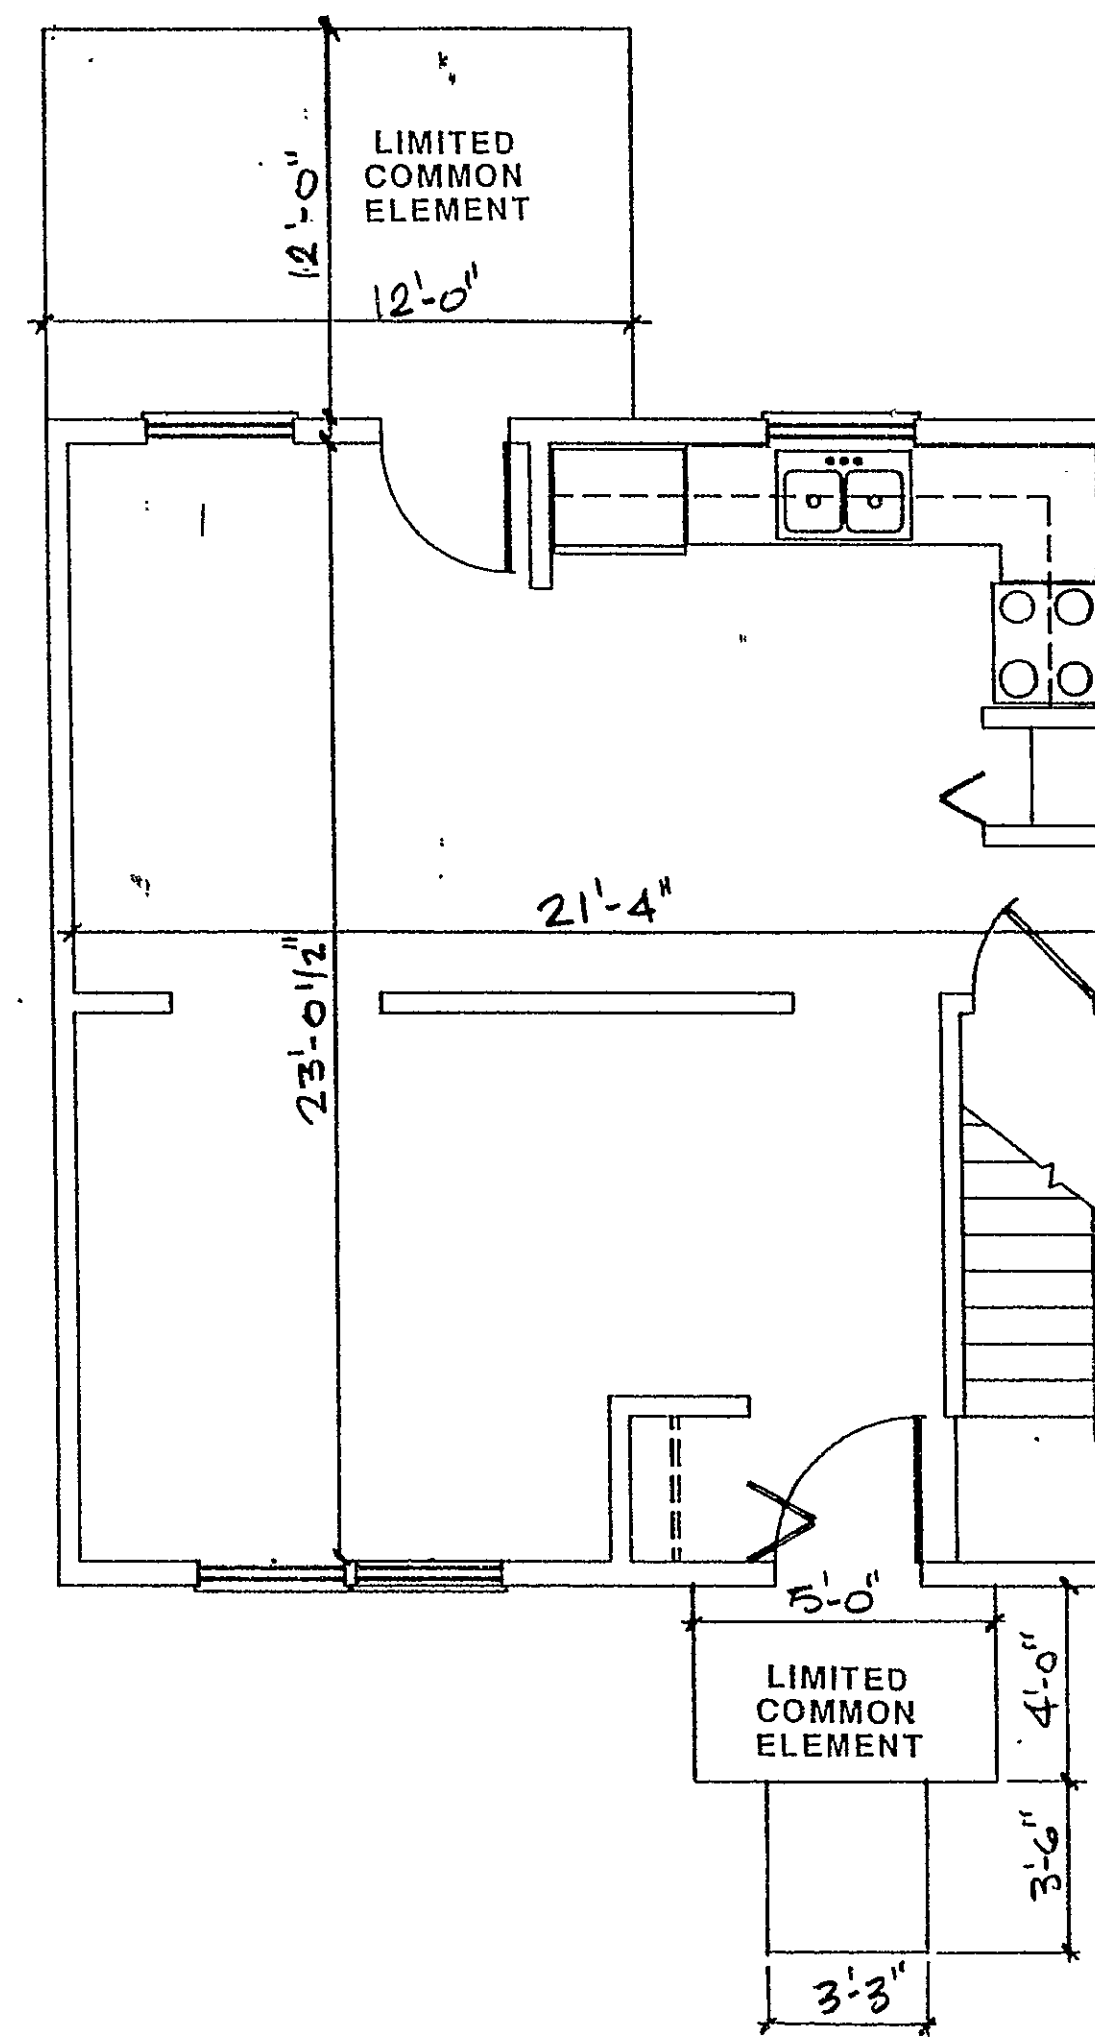

1st FLOOR

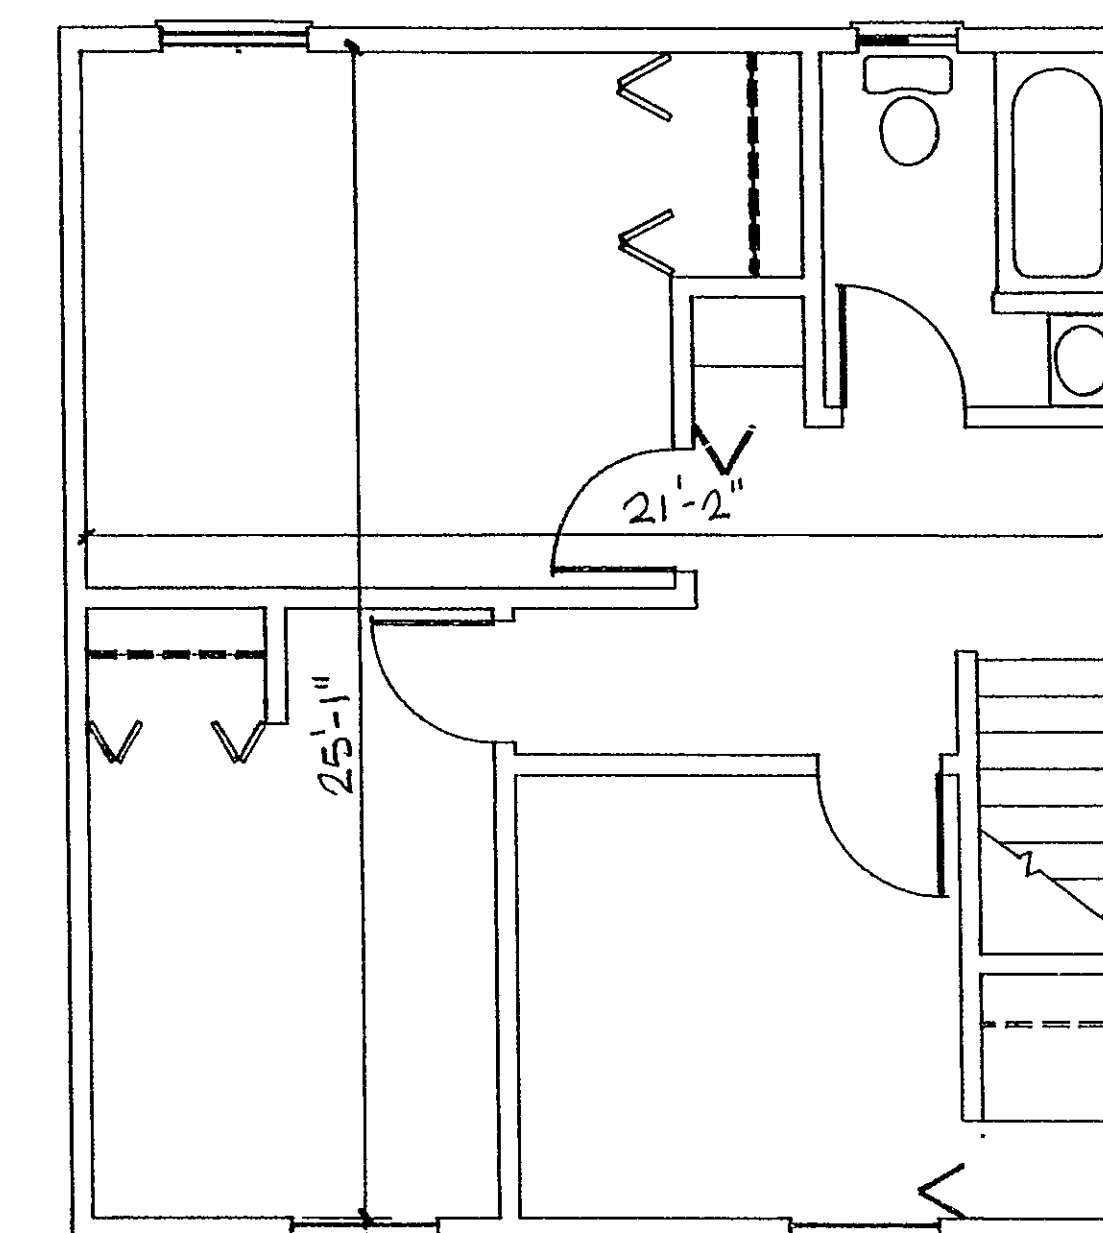

2nd FLOOR

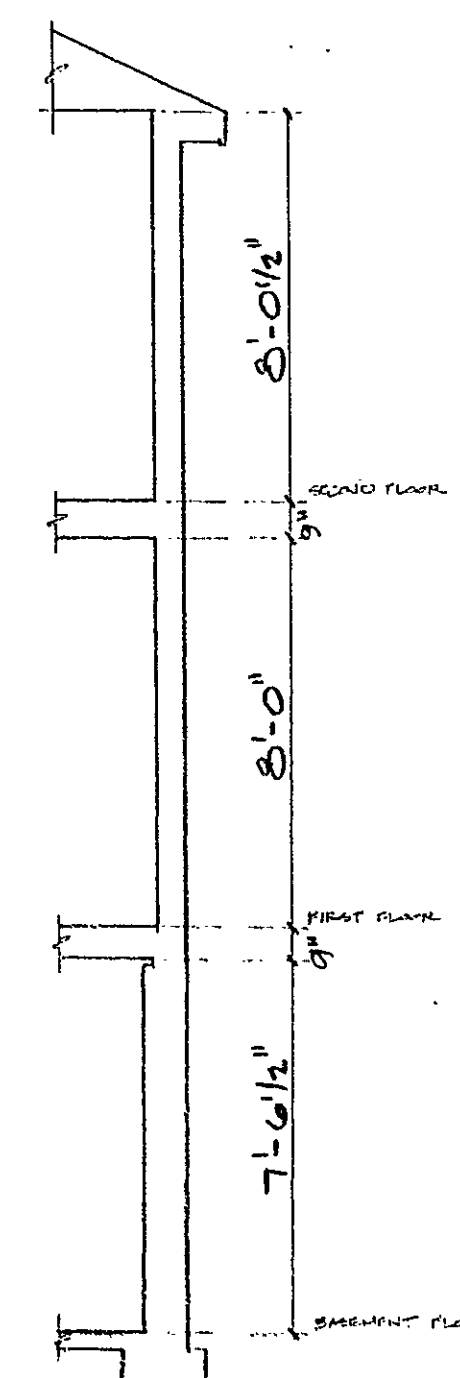

TYPICAL SECTION



CERTIFICATE

This Certificate is given with regard to the Plans entitled **HOPE CONDOMINIUM**. I hereby certify that the above plans contain all of the information required in accordance with Connecticut General Statutes 47-228(d) of the Uniform Interest Ownership Act.

Paul T. Franze License No. **6652**

The word certify is an expression of professional opinion which is based on his best knowledge, information and belief, and as such it constitutes neither a guarantee nor a warranty expressed or implied.

UNIT # 2

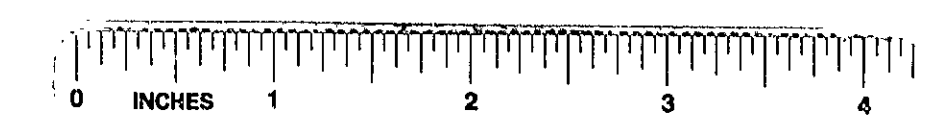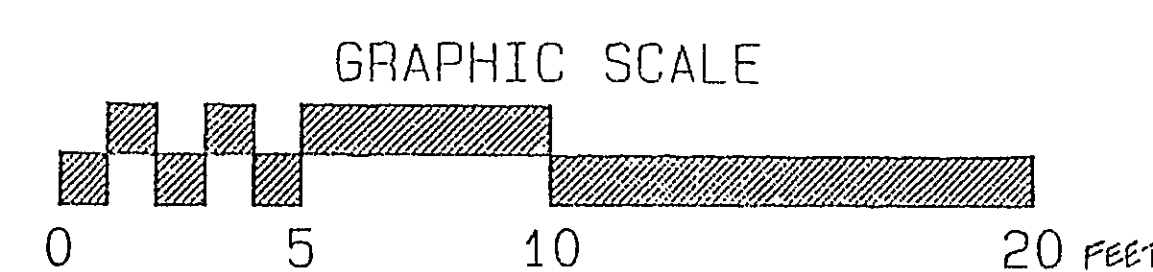

COX
FRANZA
WASZKELWICZ
ARCHITECTS, INC.

ARCHITECTURE
STRUCTURAL
MECHANICAL
ELECTRICAL
PLUMBING

HOPE CONDOMINIUM
PREPARED FOR
HARTFORD AREA HABITAT
FOR HUMANITY, INC.
HARTFORD, CONN.

REVISIONS		
NO.	DATE	REMARKS

EXHIBIT 4

Condo #106