




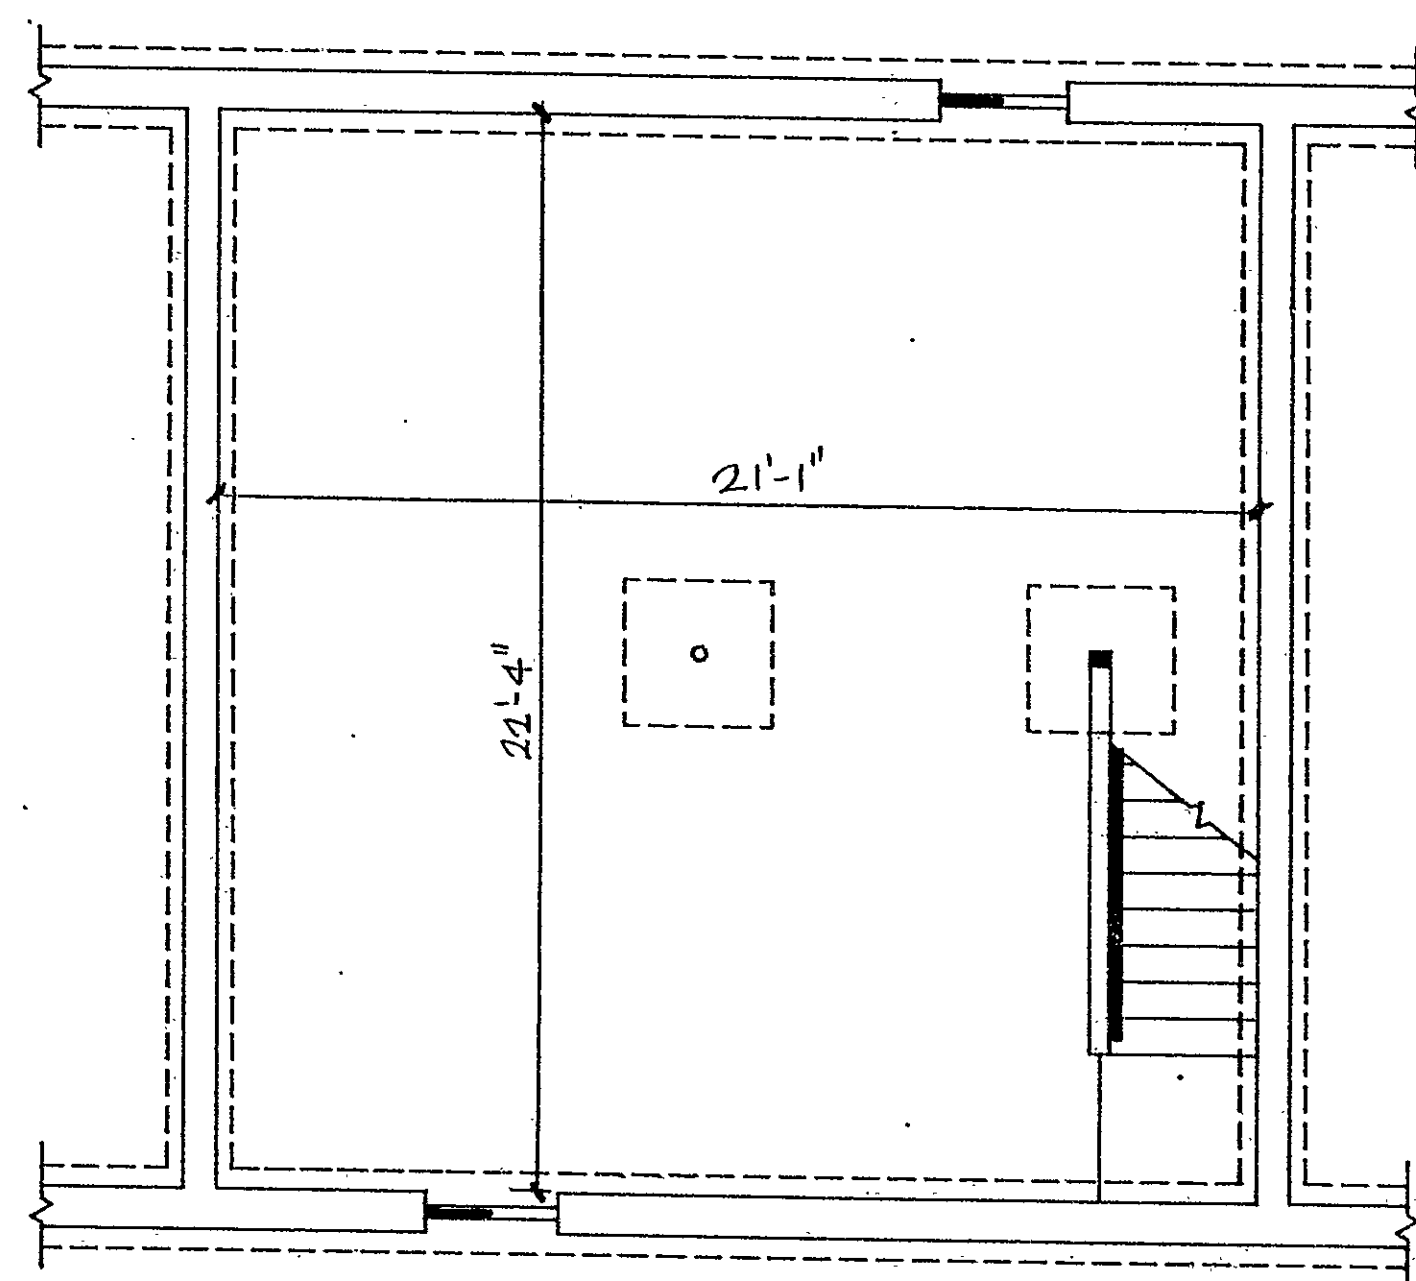


BASEMENT

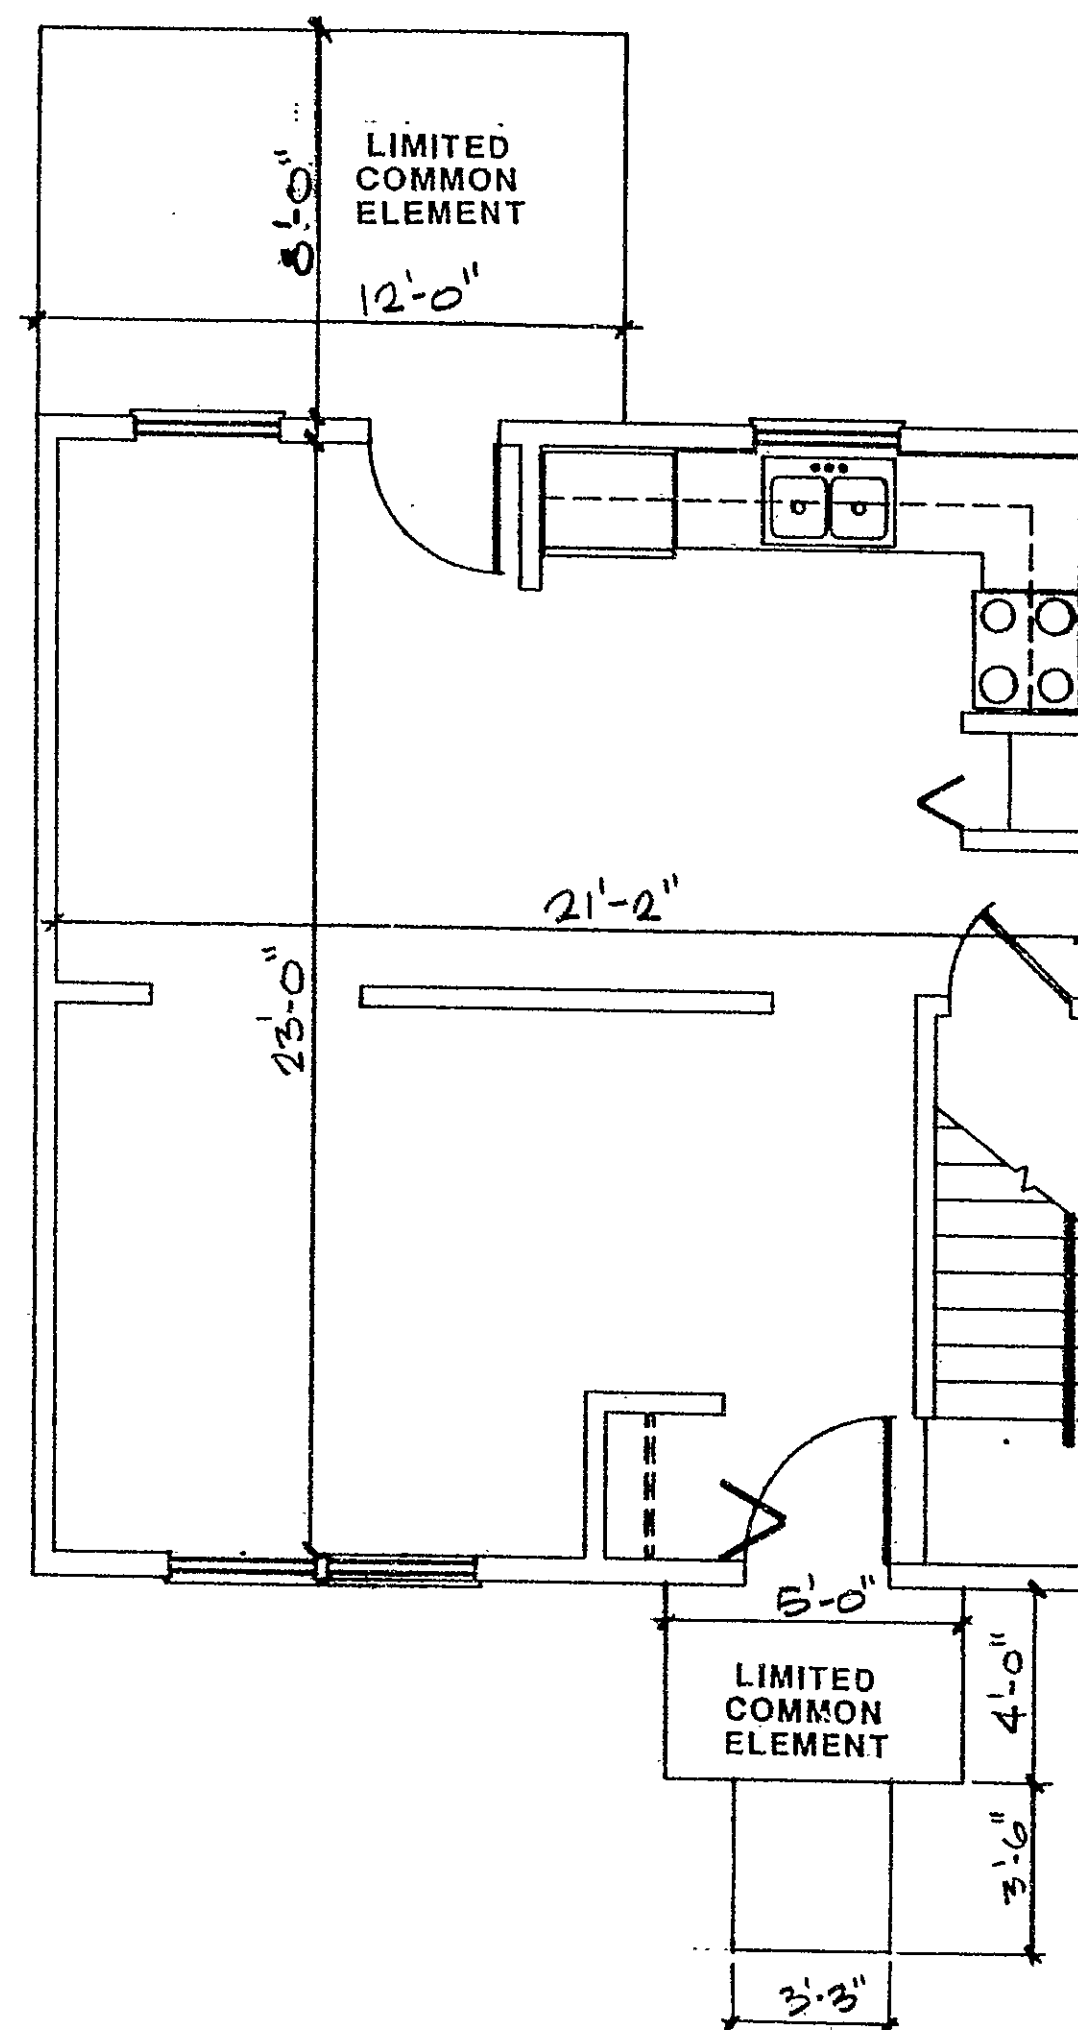

1st FLOOR

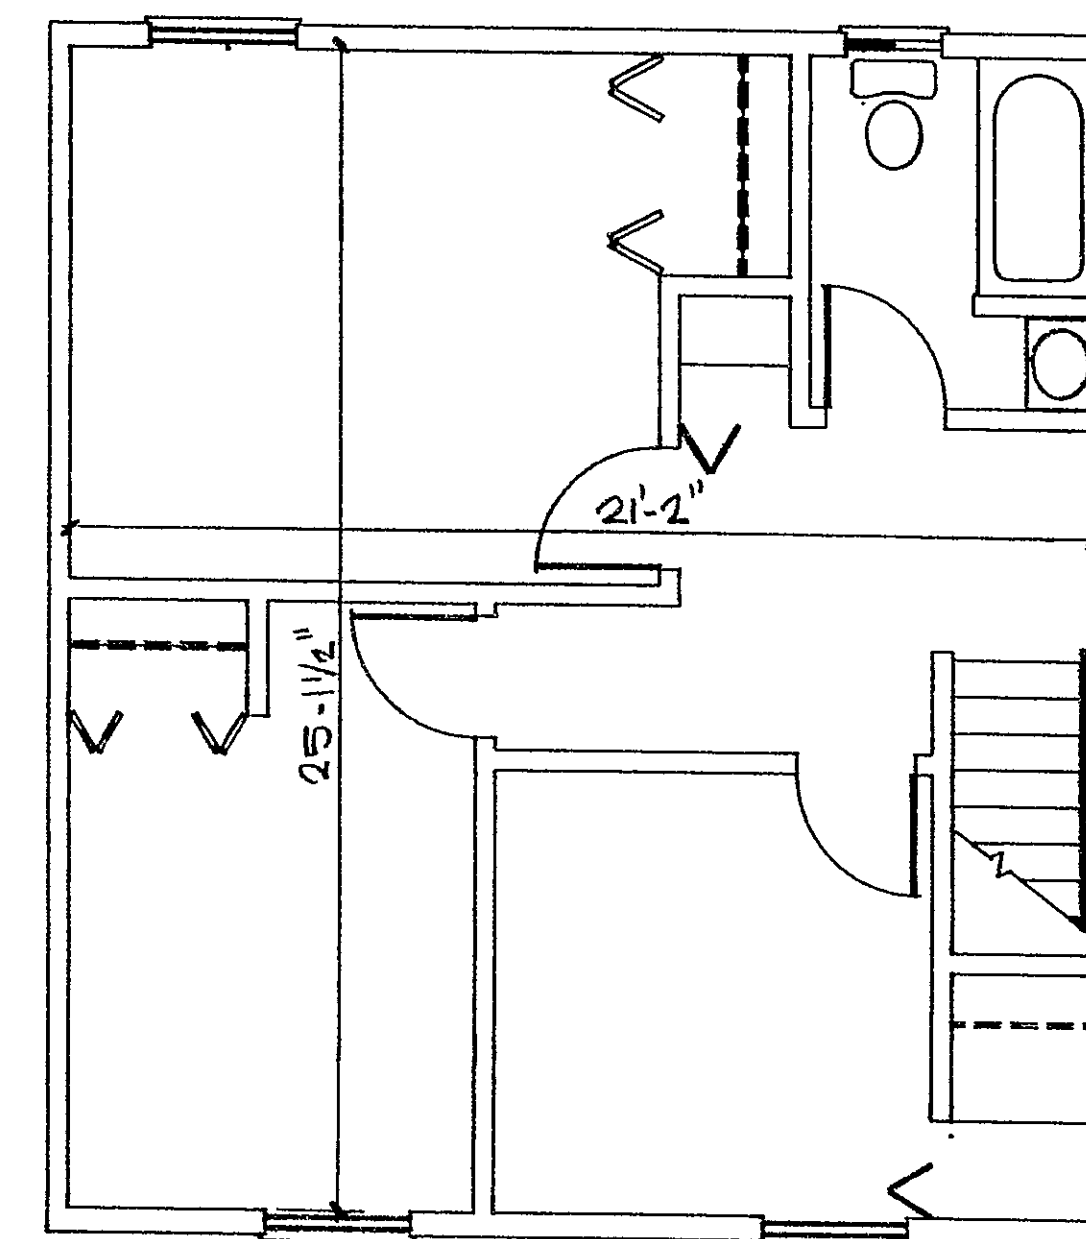

2nd FLOOR

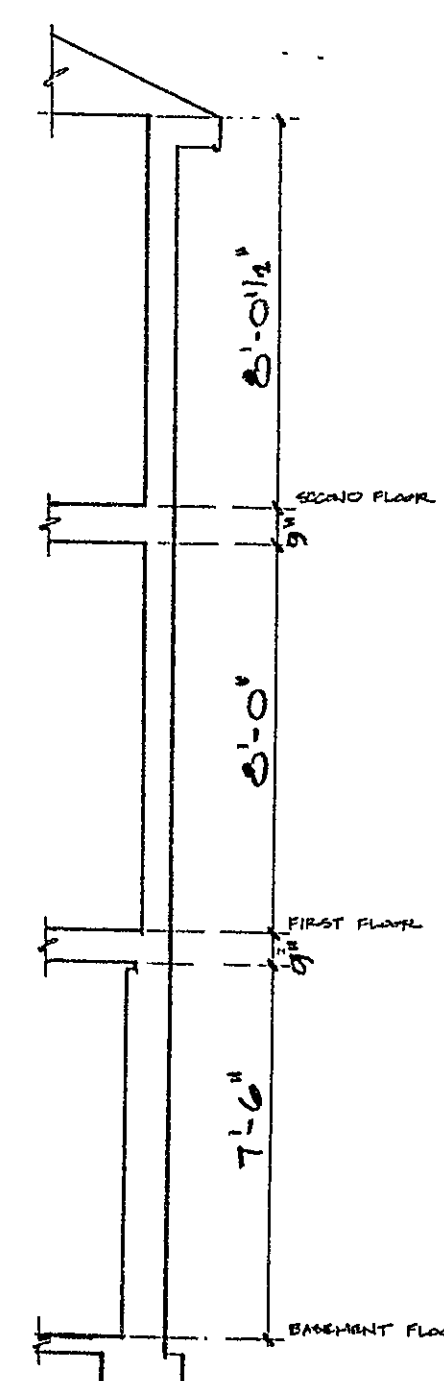

TYPICAL SECTION

CERTIFICATE


This Certificate is given with regard to the Plans entitled **HOPE CONDOMINIUM**. I hereby certify that the above plans contain all of the information required in accordance with Connecticut General Statutes 47-226(D) of the Common Interest Ownership Act.

Paul T. Franze License No. 6652

The word certify is an expression of professional opinion which is based on his best knowledge, information and belief, and as such it constitutes neither a guarantee nor a warranty expressed or implied.

UNIT # 3

GRAPHIC SCALE

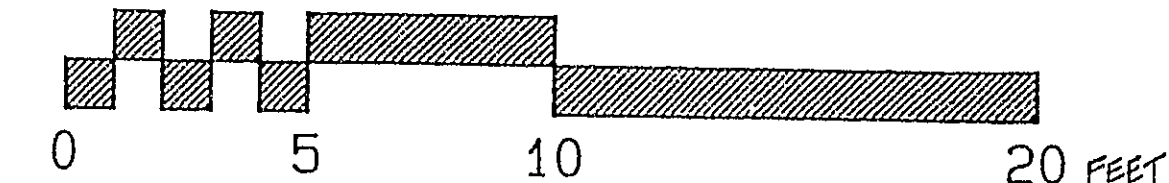

**COX
FRANZE
WASZKELWICZ
ARCHITECTS, INC.**

PROJECT NO.

DATE

REVISIONS

**"HOPE CONDOMINIUM"
PREPARED FOR
HARTFORD AREA HABITAT
FOR HUMANITY, INC.
HARTFORD, CONNECTICUT**

DATE
10-12-90

NO.	DATE	REMARKS

EXHIBIT 4

Carroll # 106

901

0 INCHES 1 2 3 4