




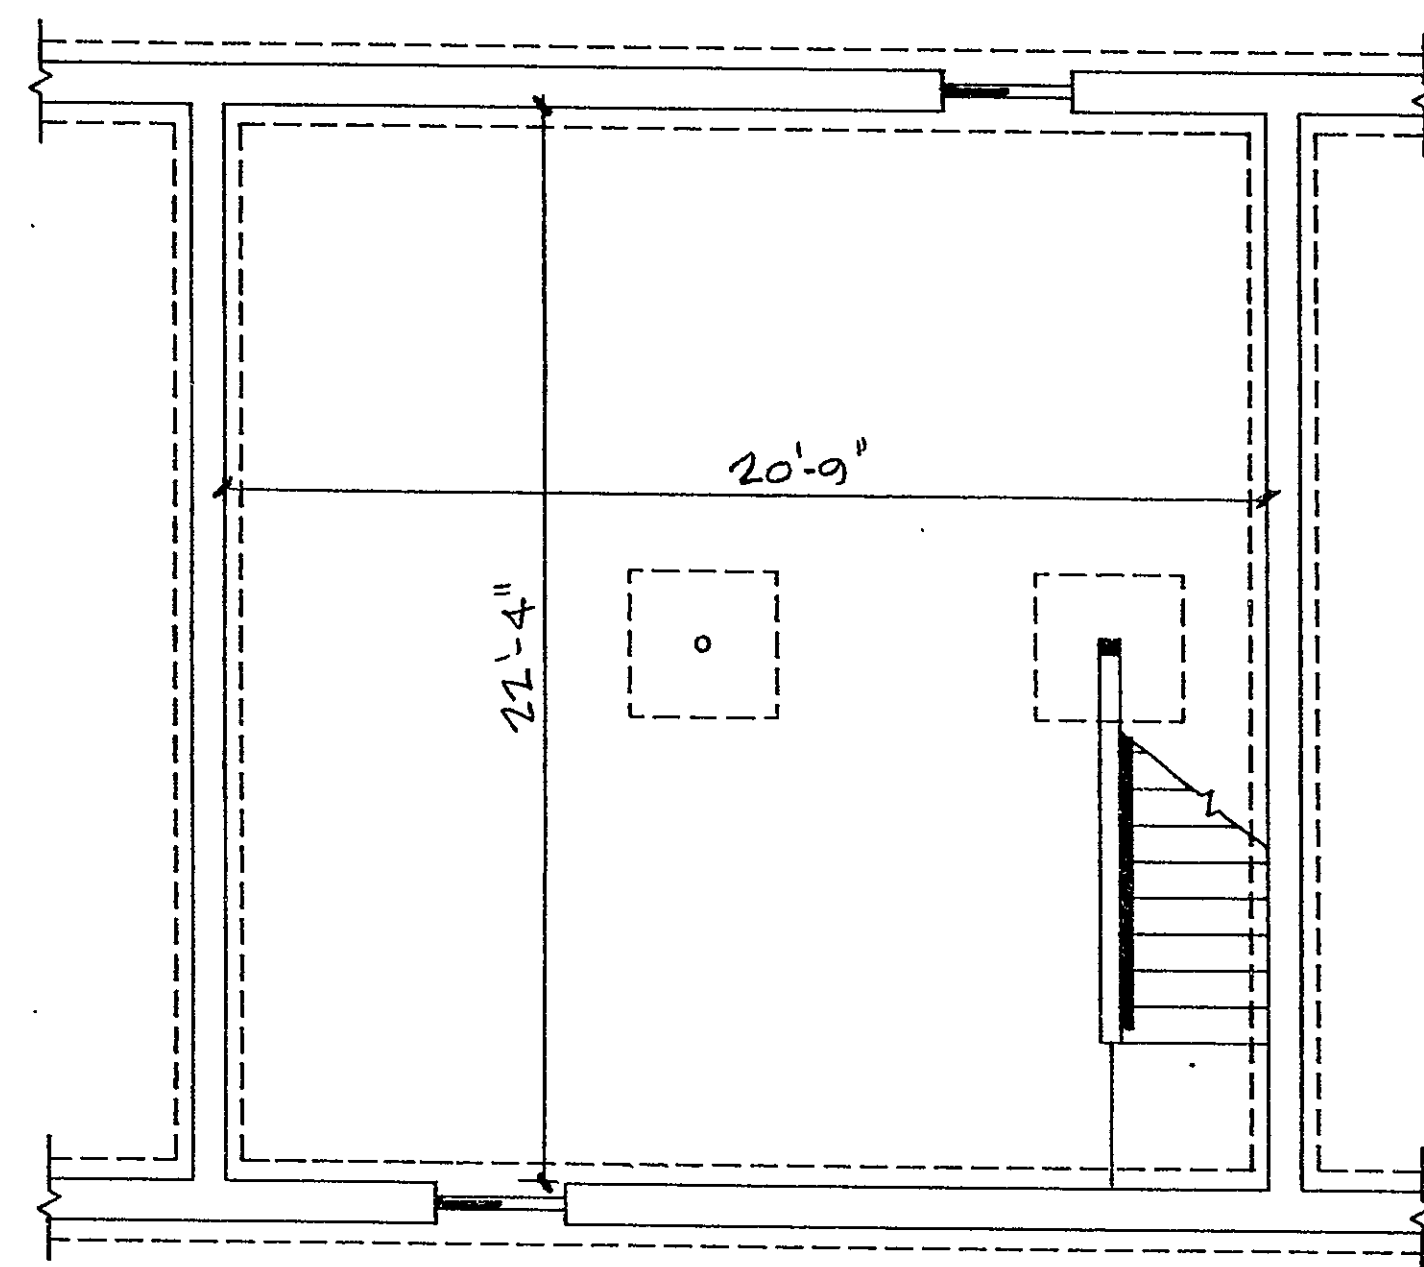


BASEMENT

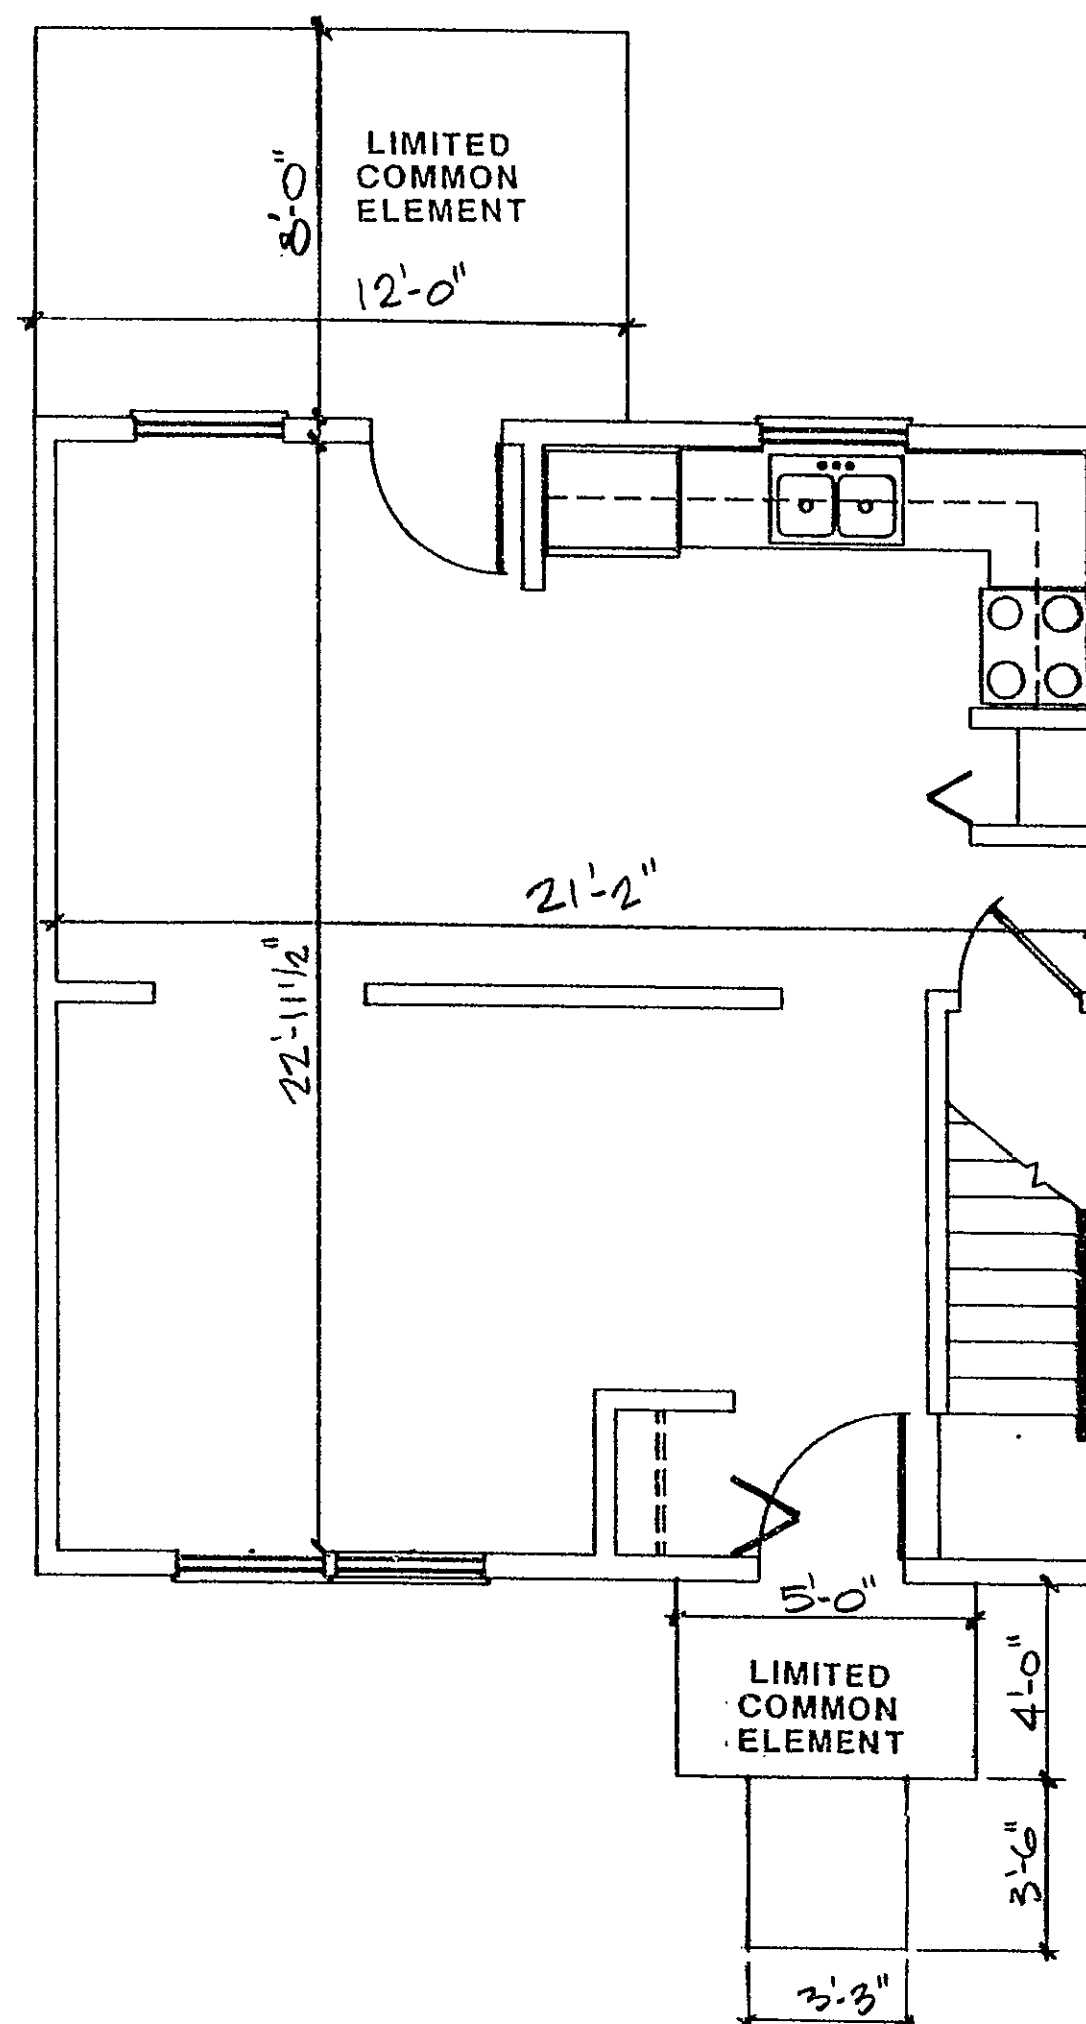

1st FLOOR

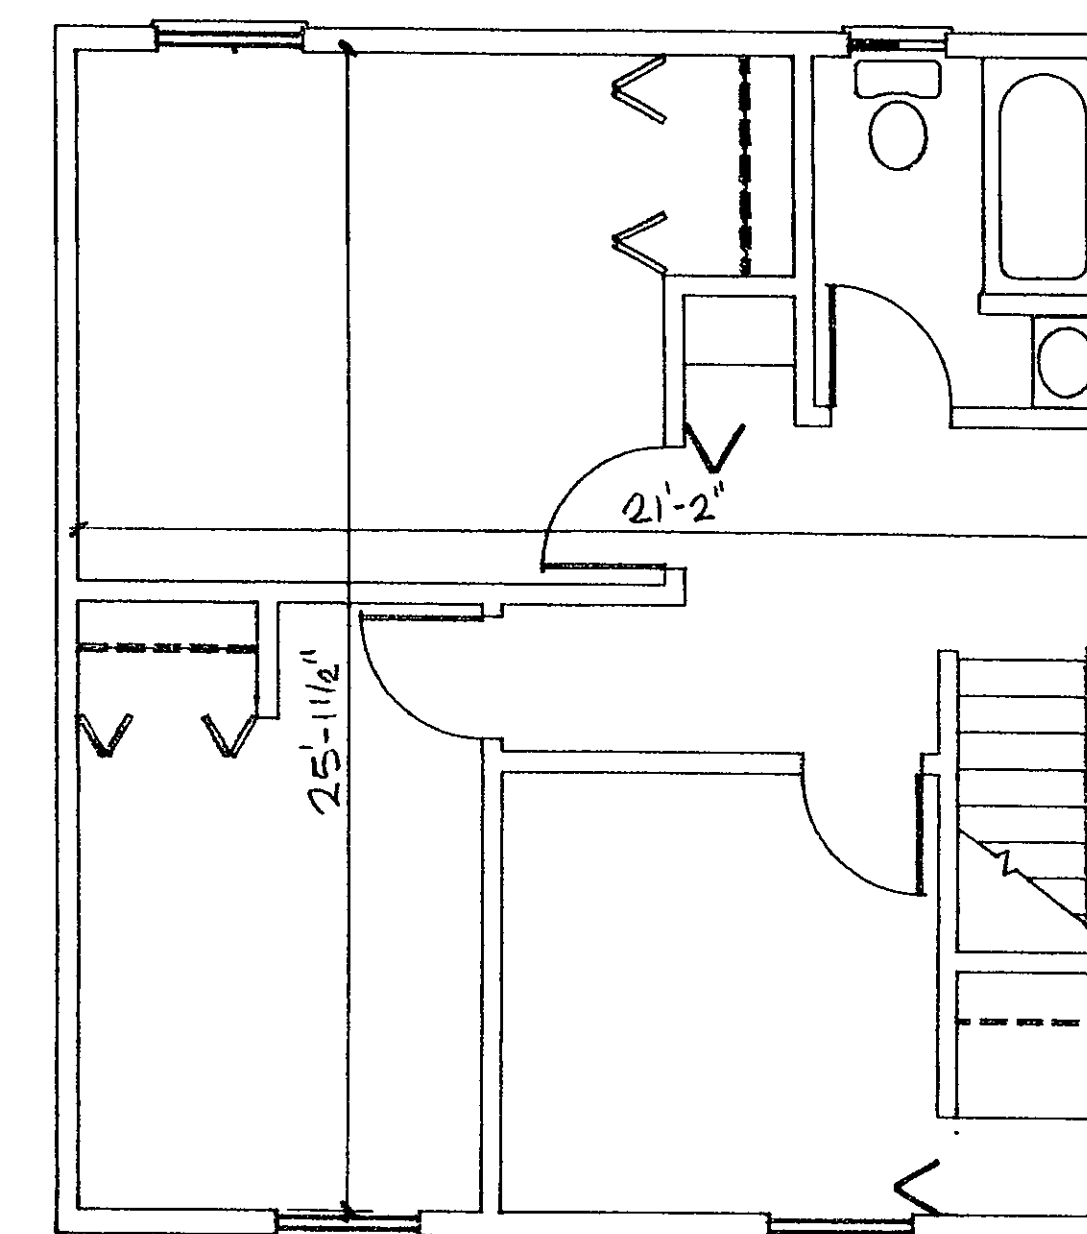


2nd FLOOR

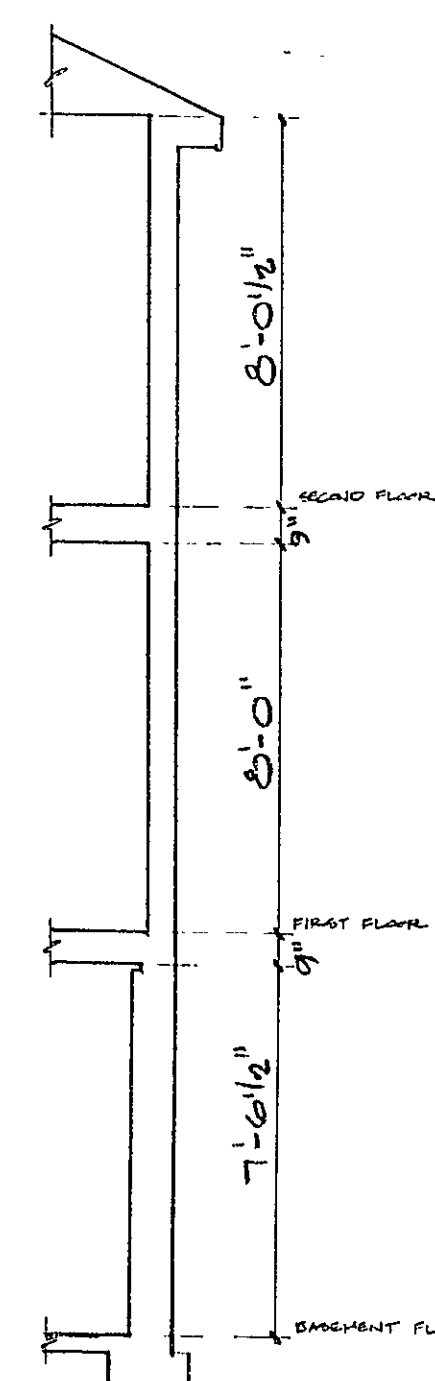

TYPICAL SECTION

CERTIFICATE
This Certificate is given with regard to the Plans entitled **HOPE CONDOMINIUM**. I hereby certify that the above plans contain all of the information required in accordance with Connecticut General Statutes 47-228(D) of the Common Interest Ownership Act.
Paul T. Frenza License No. 6652
The word certify is an expression of professional opinion which is based on his best knowledge, information and belief, and as such it constitutes neither a guarantee nor a warranty expressed or implied.

UNIT # 4

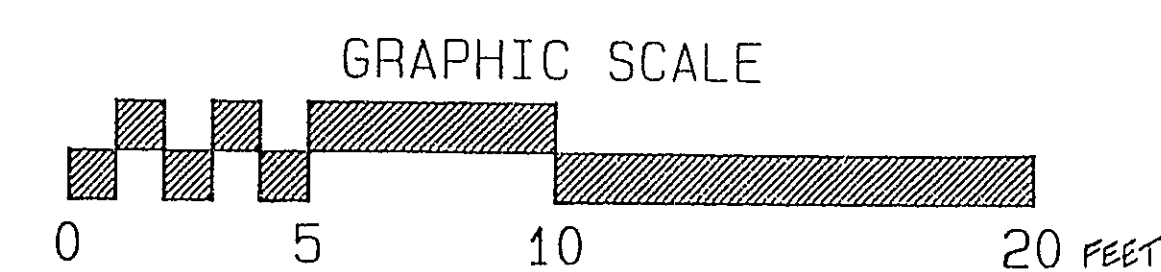

COX
FRANZA
WATKINS
ARCHITECTS, INC.

ARCHITECT
DATE: 10-12-90

PROJECT NO.
CHECKED:

REVISIONS

NO.	DATE	REMARKS

"HOPE CONDOMINIUM"
PREPARED FOR
HARTFORD AREA HABITAT
FOR HUMANITY, INC.
HARTFORD, CONN.

EXHIBIT 4

Copy 2 of 106

901
10 THUMB AND THE KEY

0 INCHES 1 2 3 4