
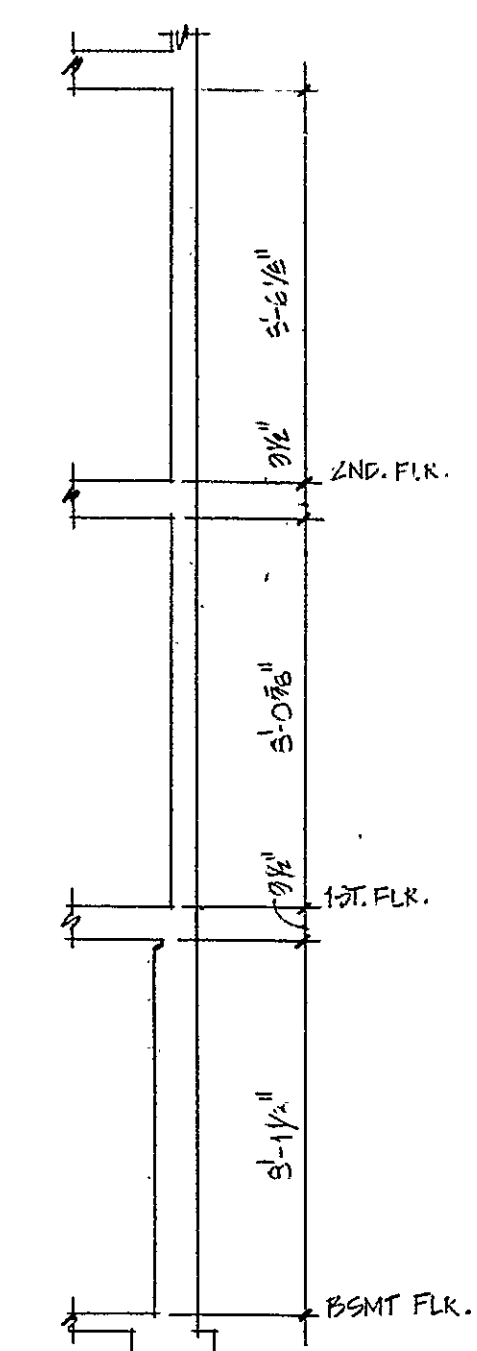


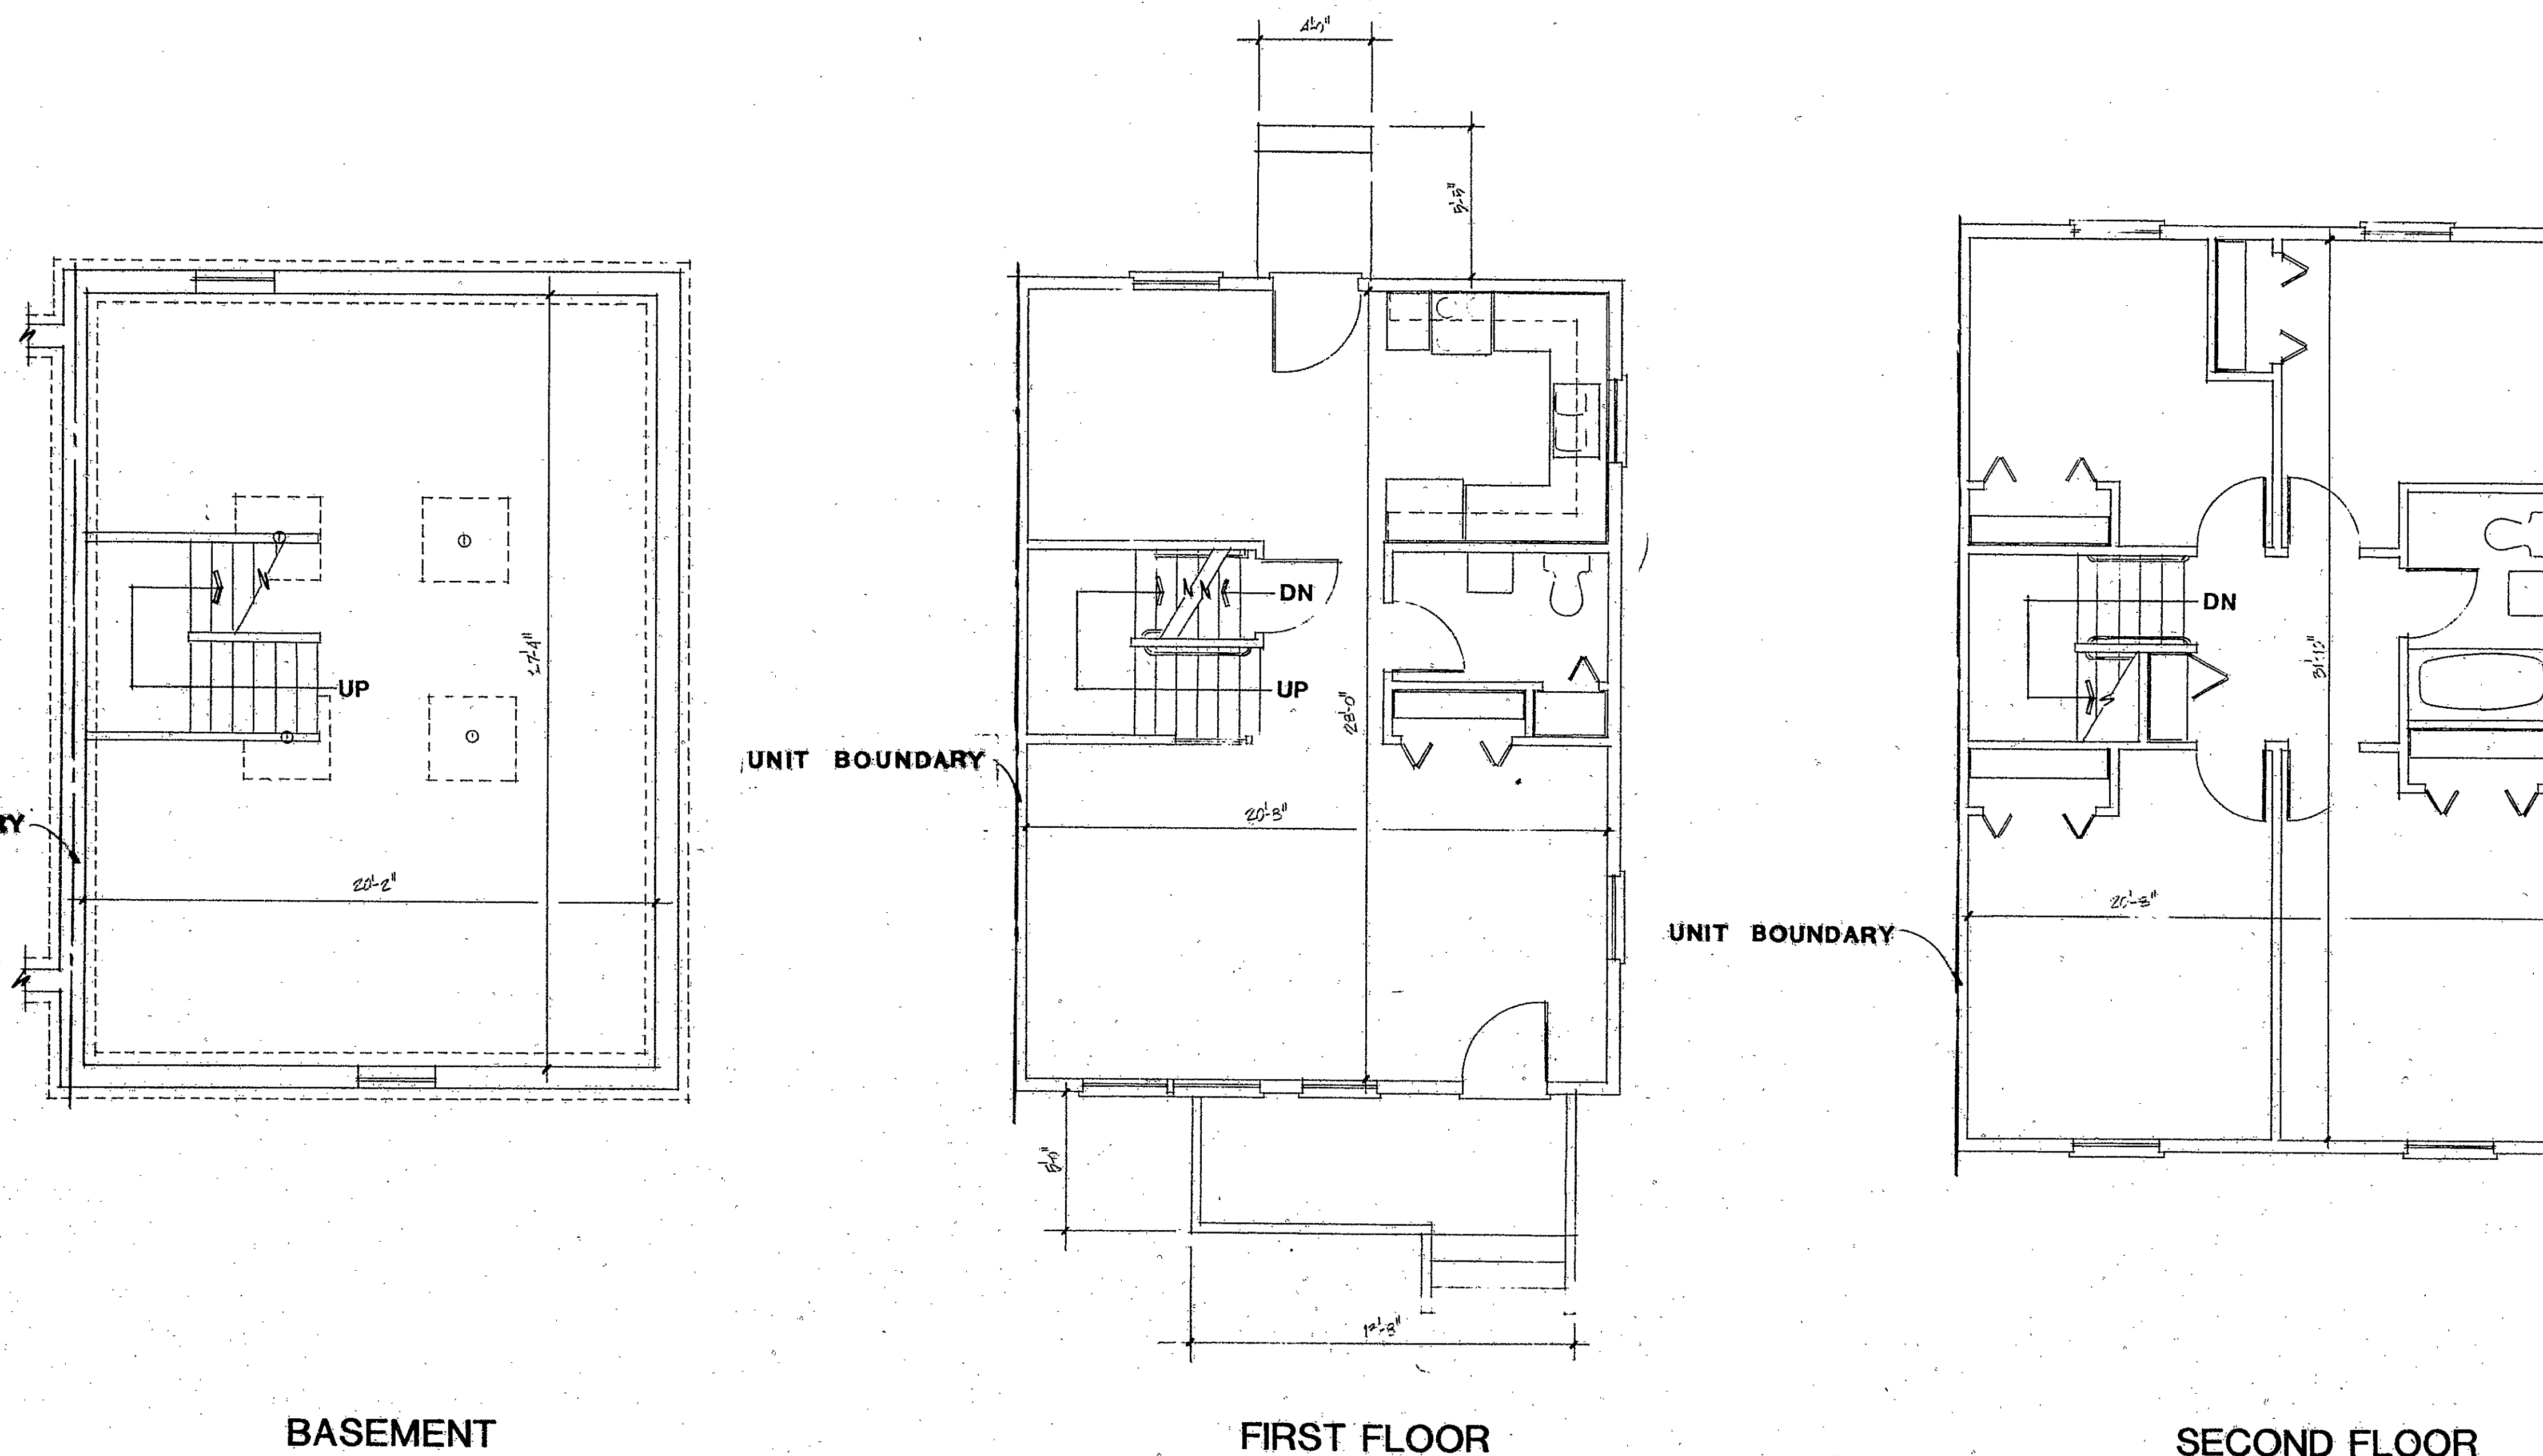


TYPICAL SECTION

ROYAL GARDENS CONDOMINIUMS
573 GARDEN STREET, HARTFORD, CT
UNIT TYPE 'E' FLOOR PLANS

SCALE: 1/4" = 1'-0"

REFER TO OTHER EXHIBITS OF THE
CONDOMINIUM DOCUMENTS FOR OTHER
MEASUREMENTS AND INFORMATION.

Certificate is given with regard to the
entitled _____
I hereby certify that the above plans contain
all of the information required in accordance
with Connecticut General Statutes 47-228(D)
of the Common Interest Ownership Act.
John C. Clark, III

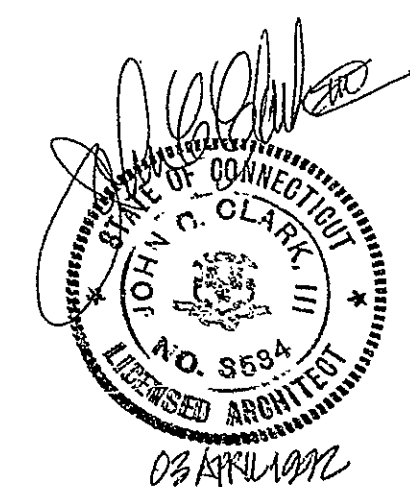

The word certify is an expression of professional
opinion which is based on his best knowledge,
information and belief, and as such it constitutes
neither a guarantee nor a warranty expressed or
implied.

JOHN C. CLARK AND ASSOCIATES
ARCHITECTS/PLANNERS
30 ASHFORD STREET
HARTFORD, CT. 06120 (203) 247-7577

SCHEDULE A, PAGE 5

Condo # 110

