



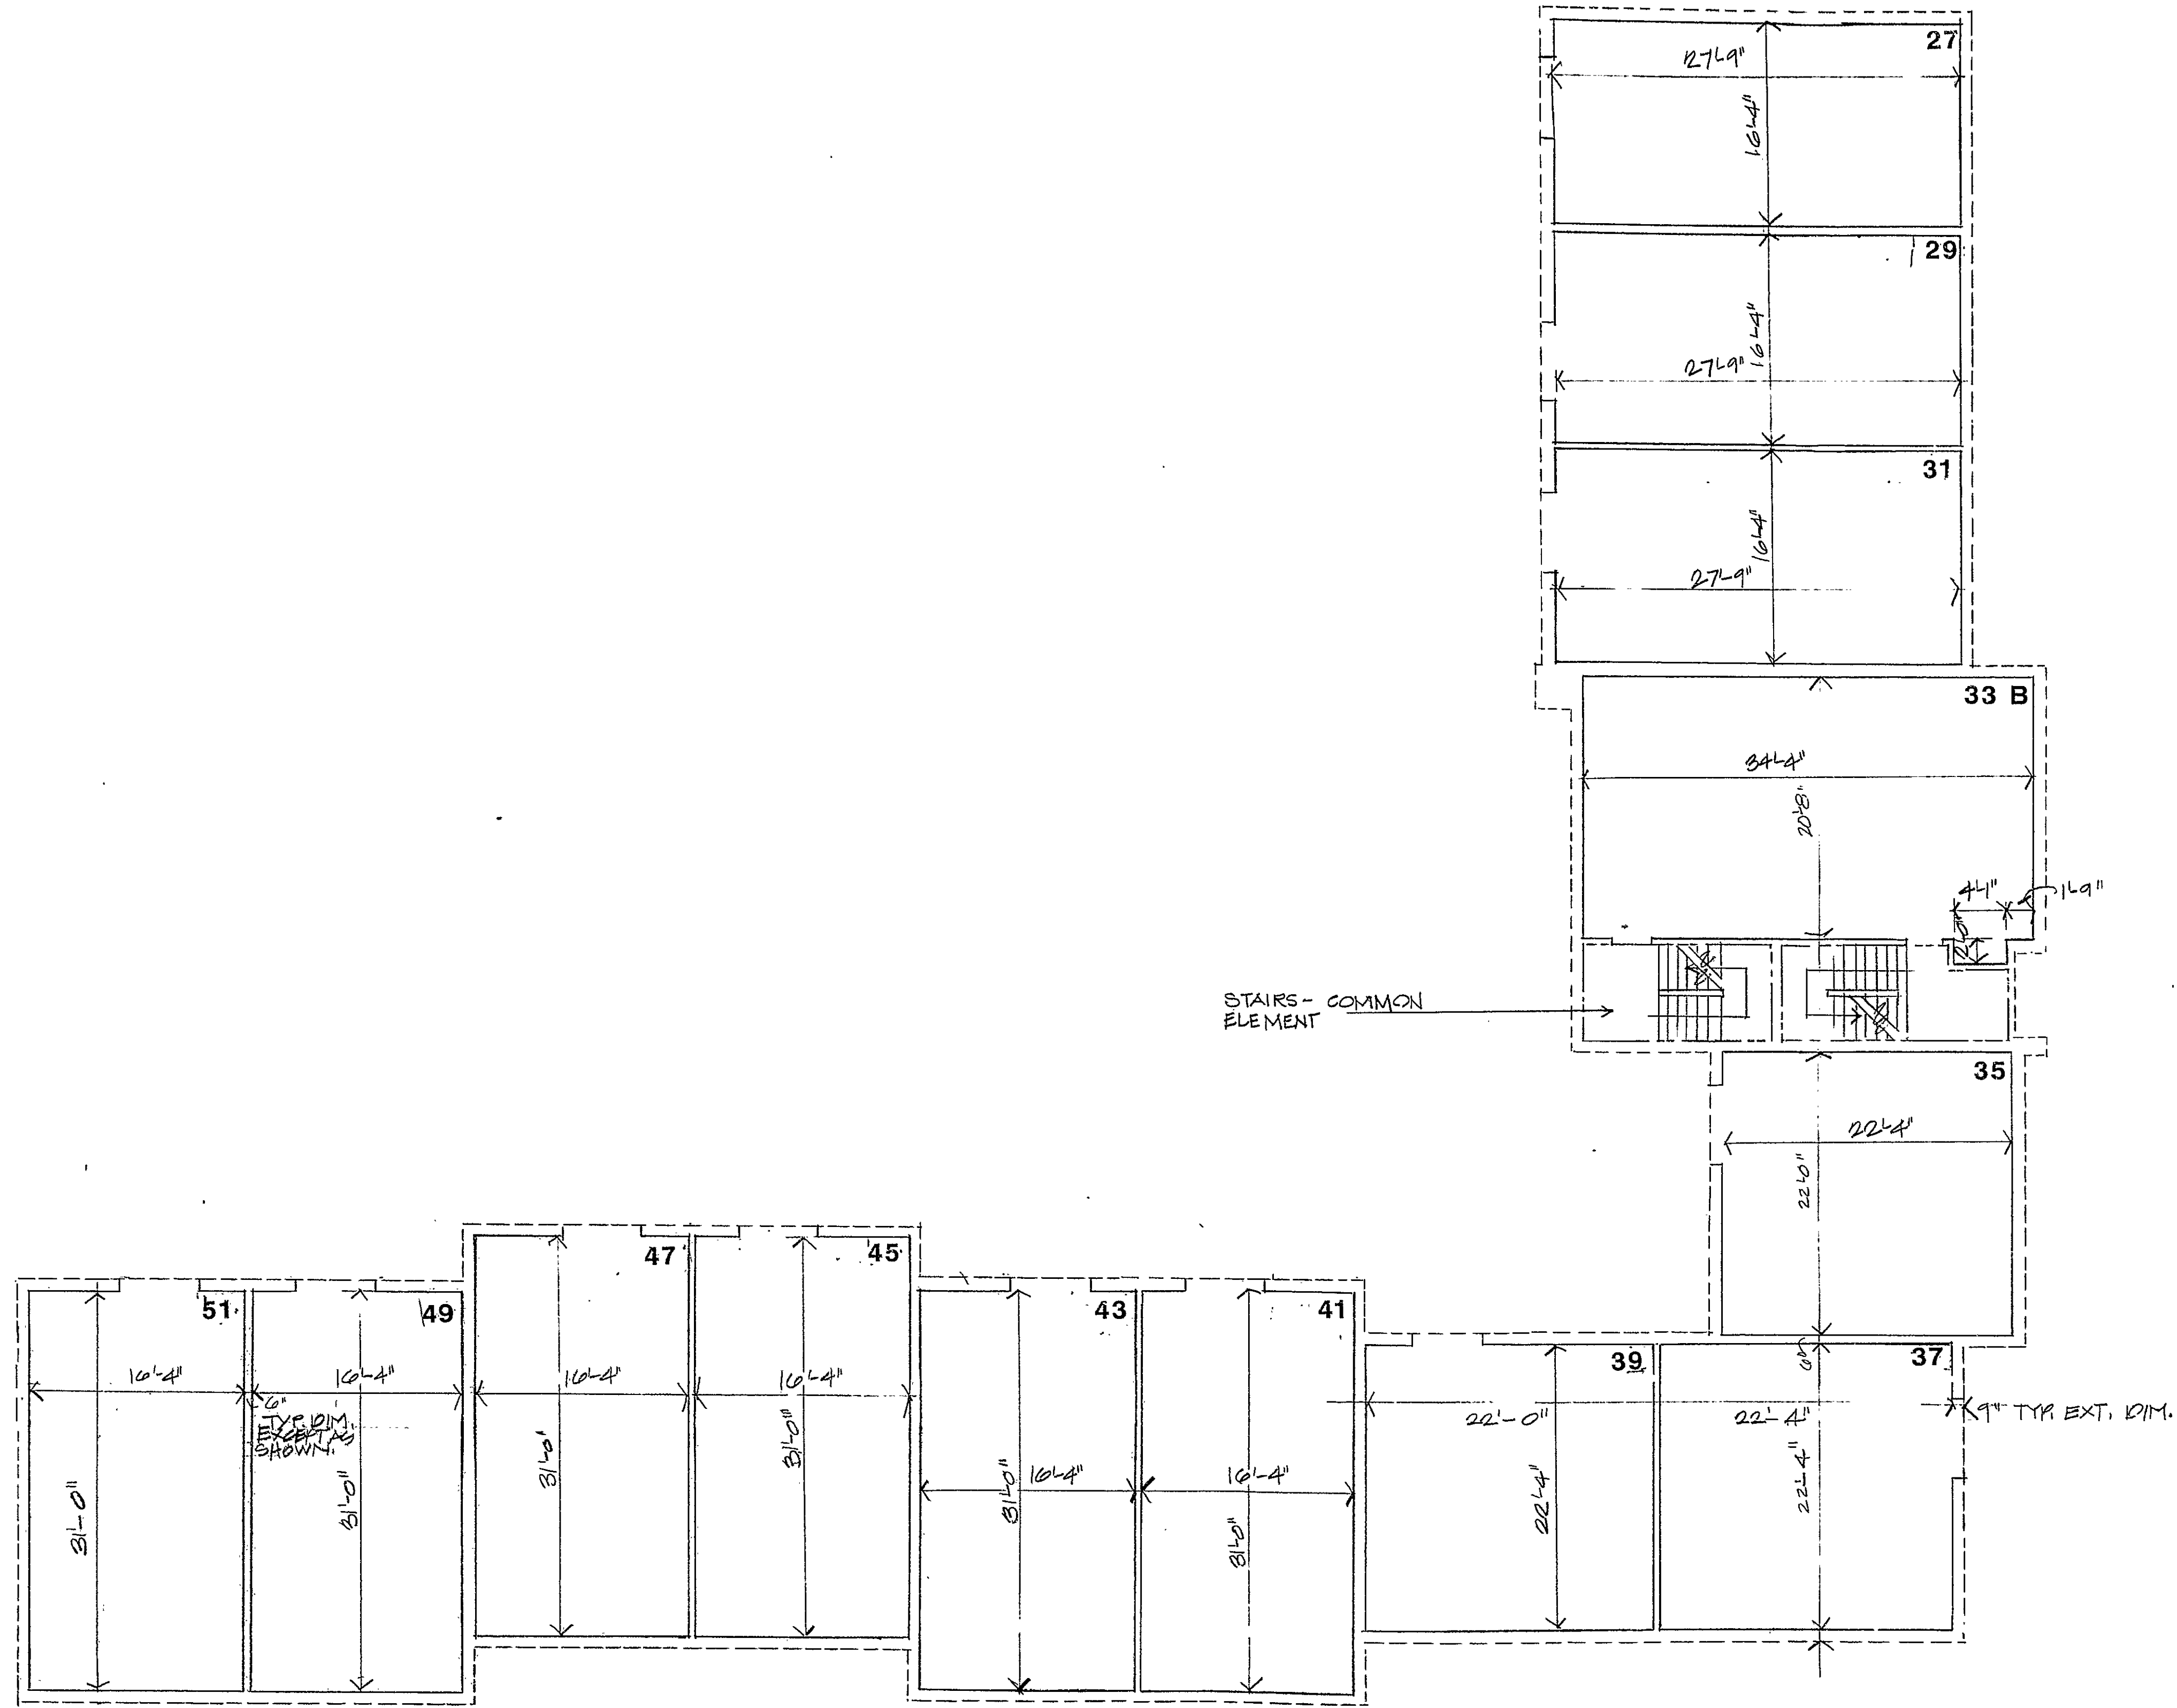


BUILDING #4 SECOND FLOOR
GRAFTON STREET

OLIVERI CORPORATION
FIXED LINE PHOTOGRAPHIC

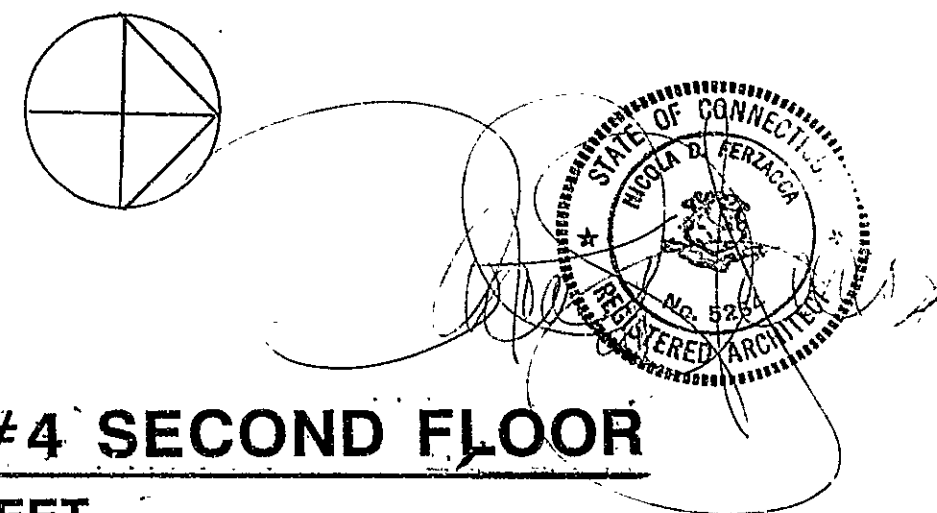


DESIGN GROUP ONE ARCHITECTS SCHEDULE A-3 OF THE DECLARATION
HARTFORD, CT. • (203) 549-5890 **BROADVIEW TERRACE CONDOMINIUMS**
HARTFORD, CONNECTICUT

Phase 1
3 of 4

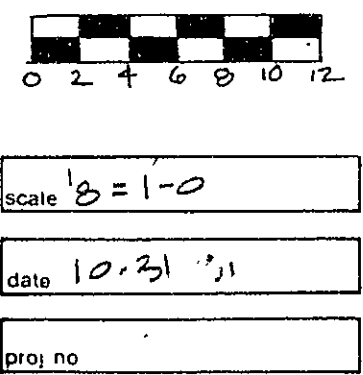

Scale: 1/8" = 1'-0"
Proj. No.

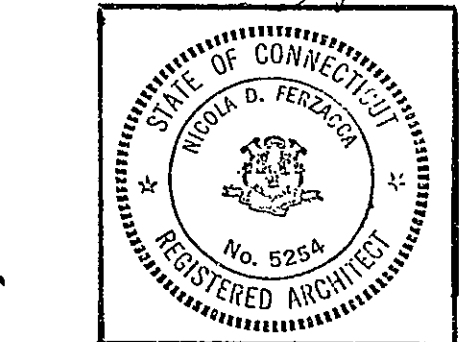


CERTIFICATION
The undersigned does hereby certify that these plans contain
all the information required by the Common Interest
Ownership Act, relating to the
Signature: [Signature]
NO. 5254
R.A. License No.

The word "certify" is understood to be an expression of
professional opinion by the Architect which is based on
the information provided to the Architect. As such,
it does not constitute a warranty, express or implied,
or otherwise, for a warranty expressed
or implied.

LEGEND :
UNIT BOUNDARY
EXTERIOR SURFACE
BORDER OF
COMMON ELEMENT
BORDER OF LIMITED
COMMON ELEMENT

Condo # 111

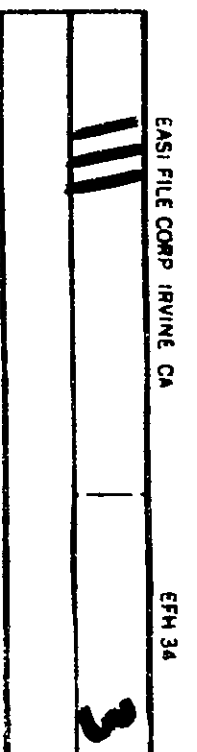

0 INCHES 1 2 3 4