


113	5
-----	---

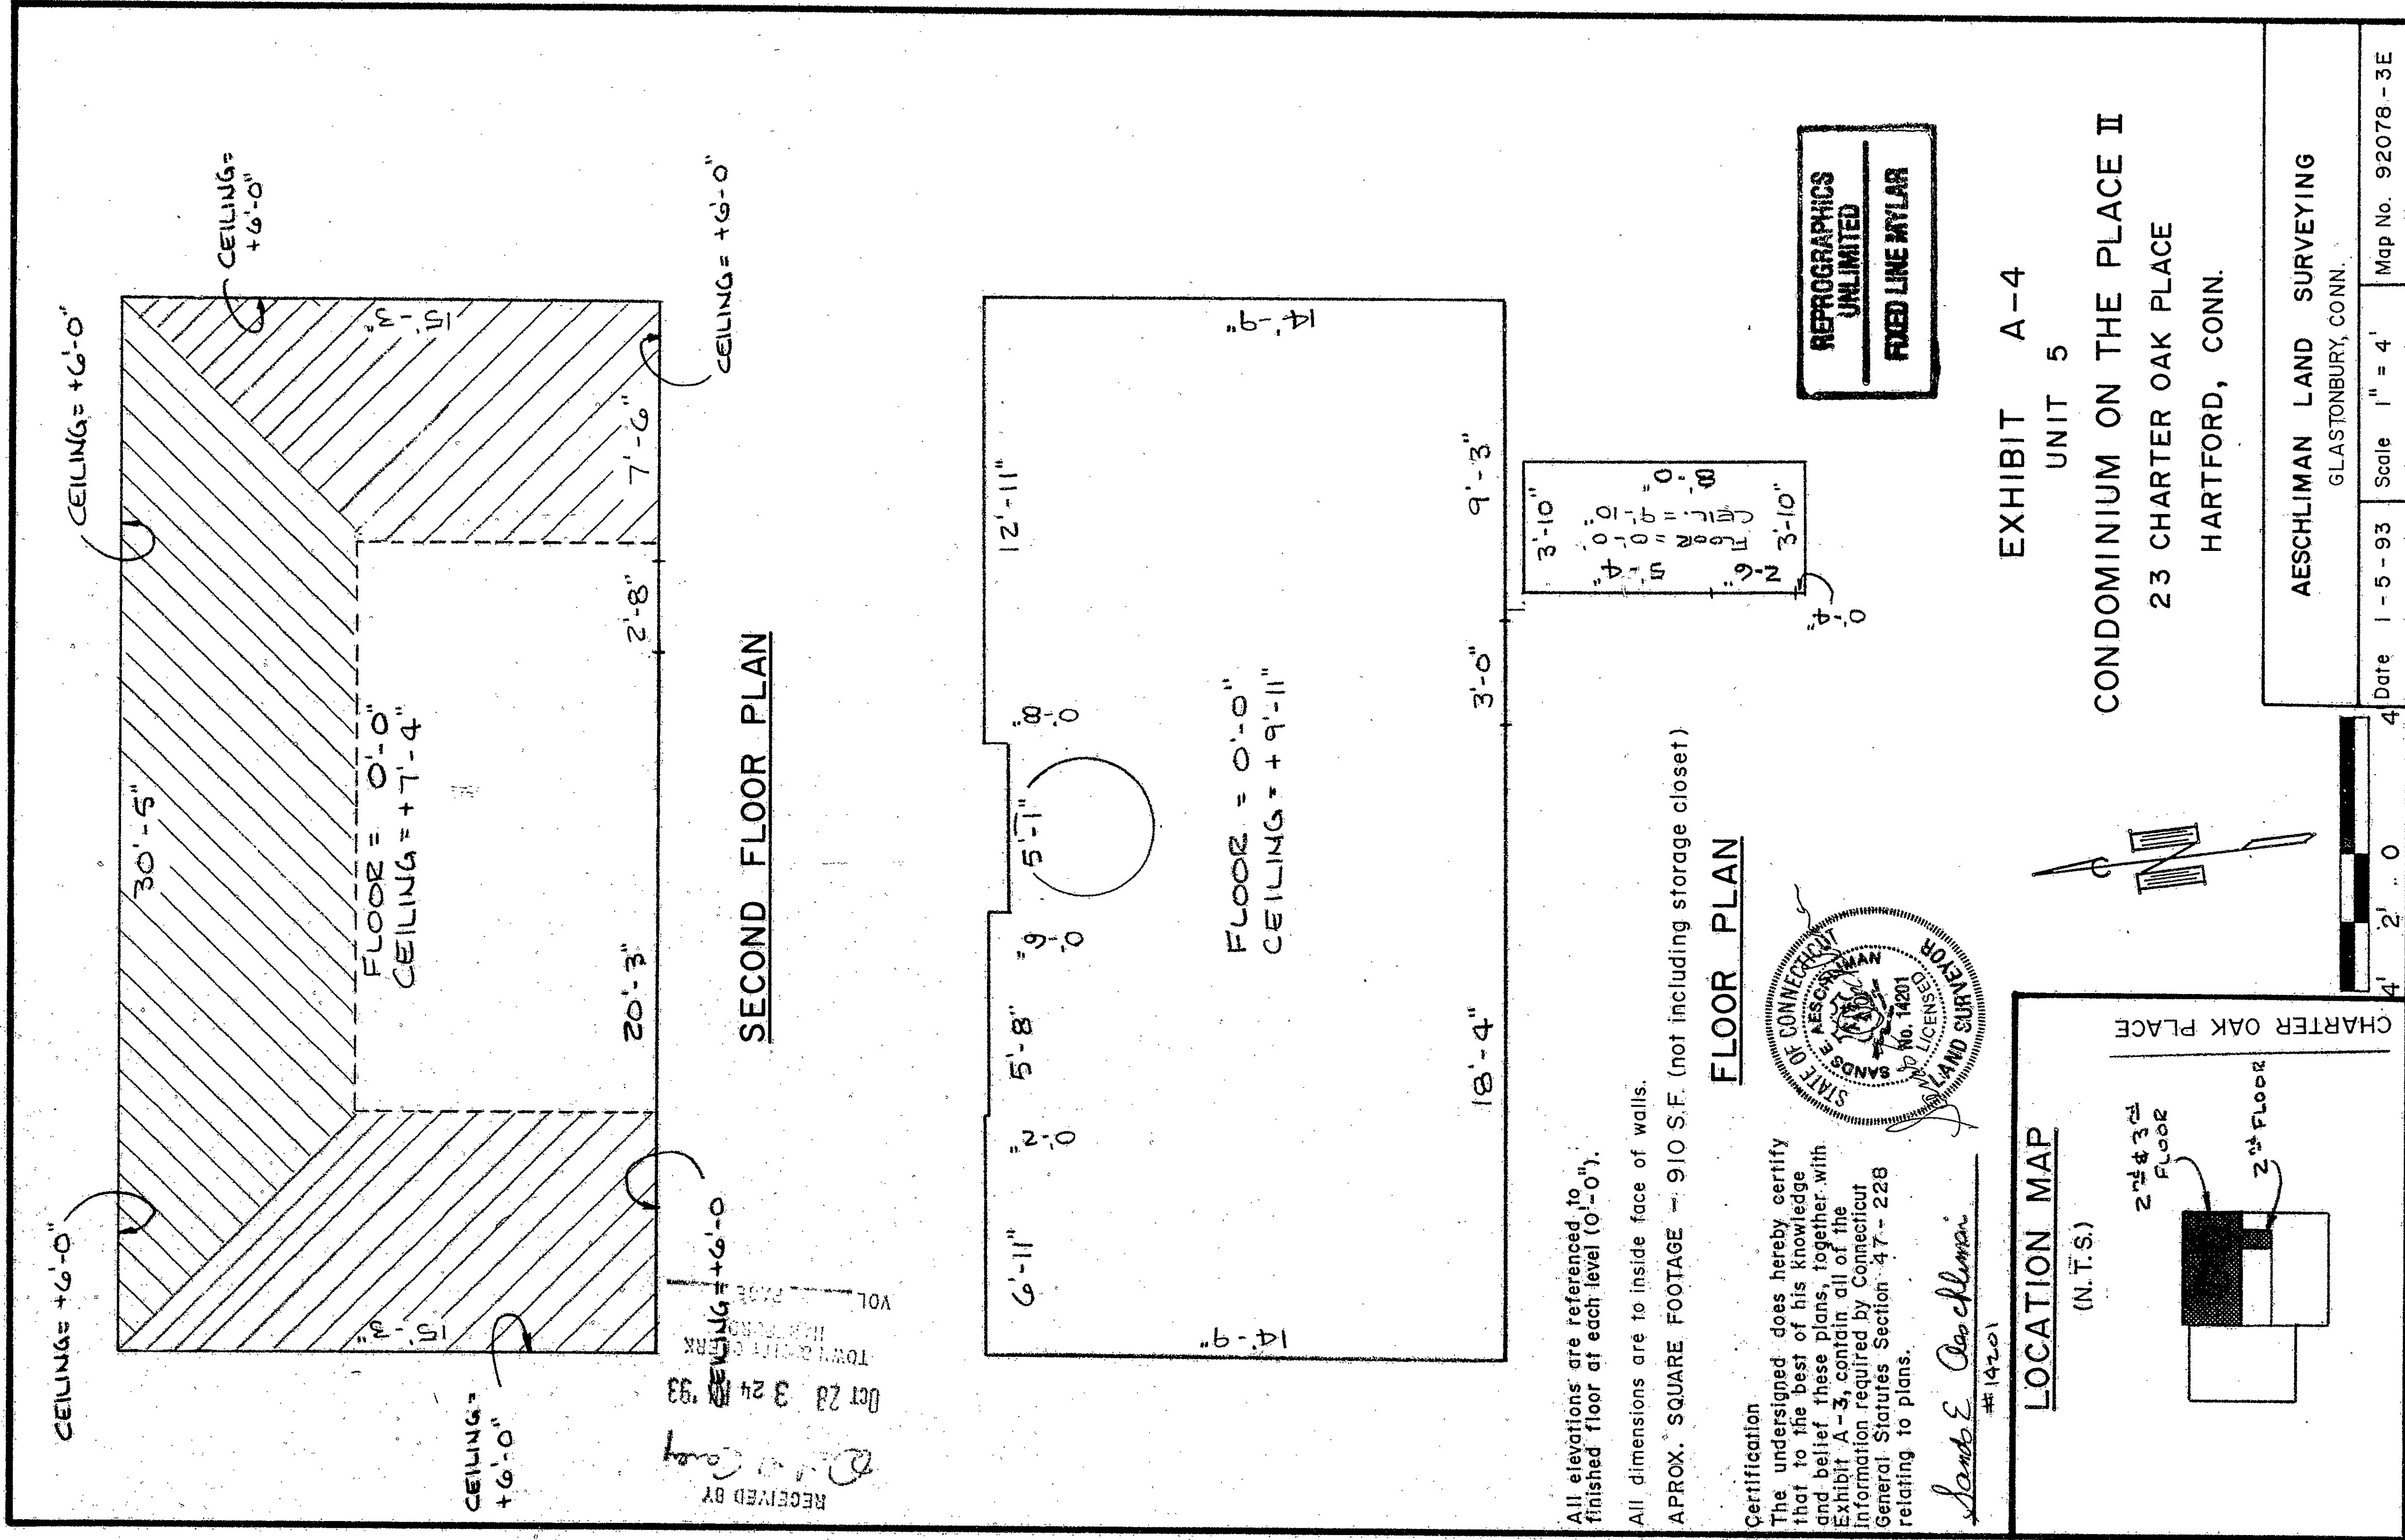

#113