


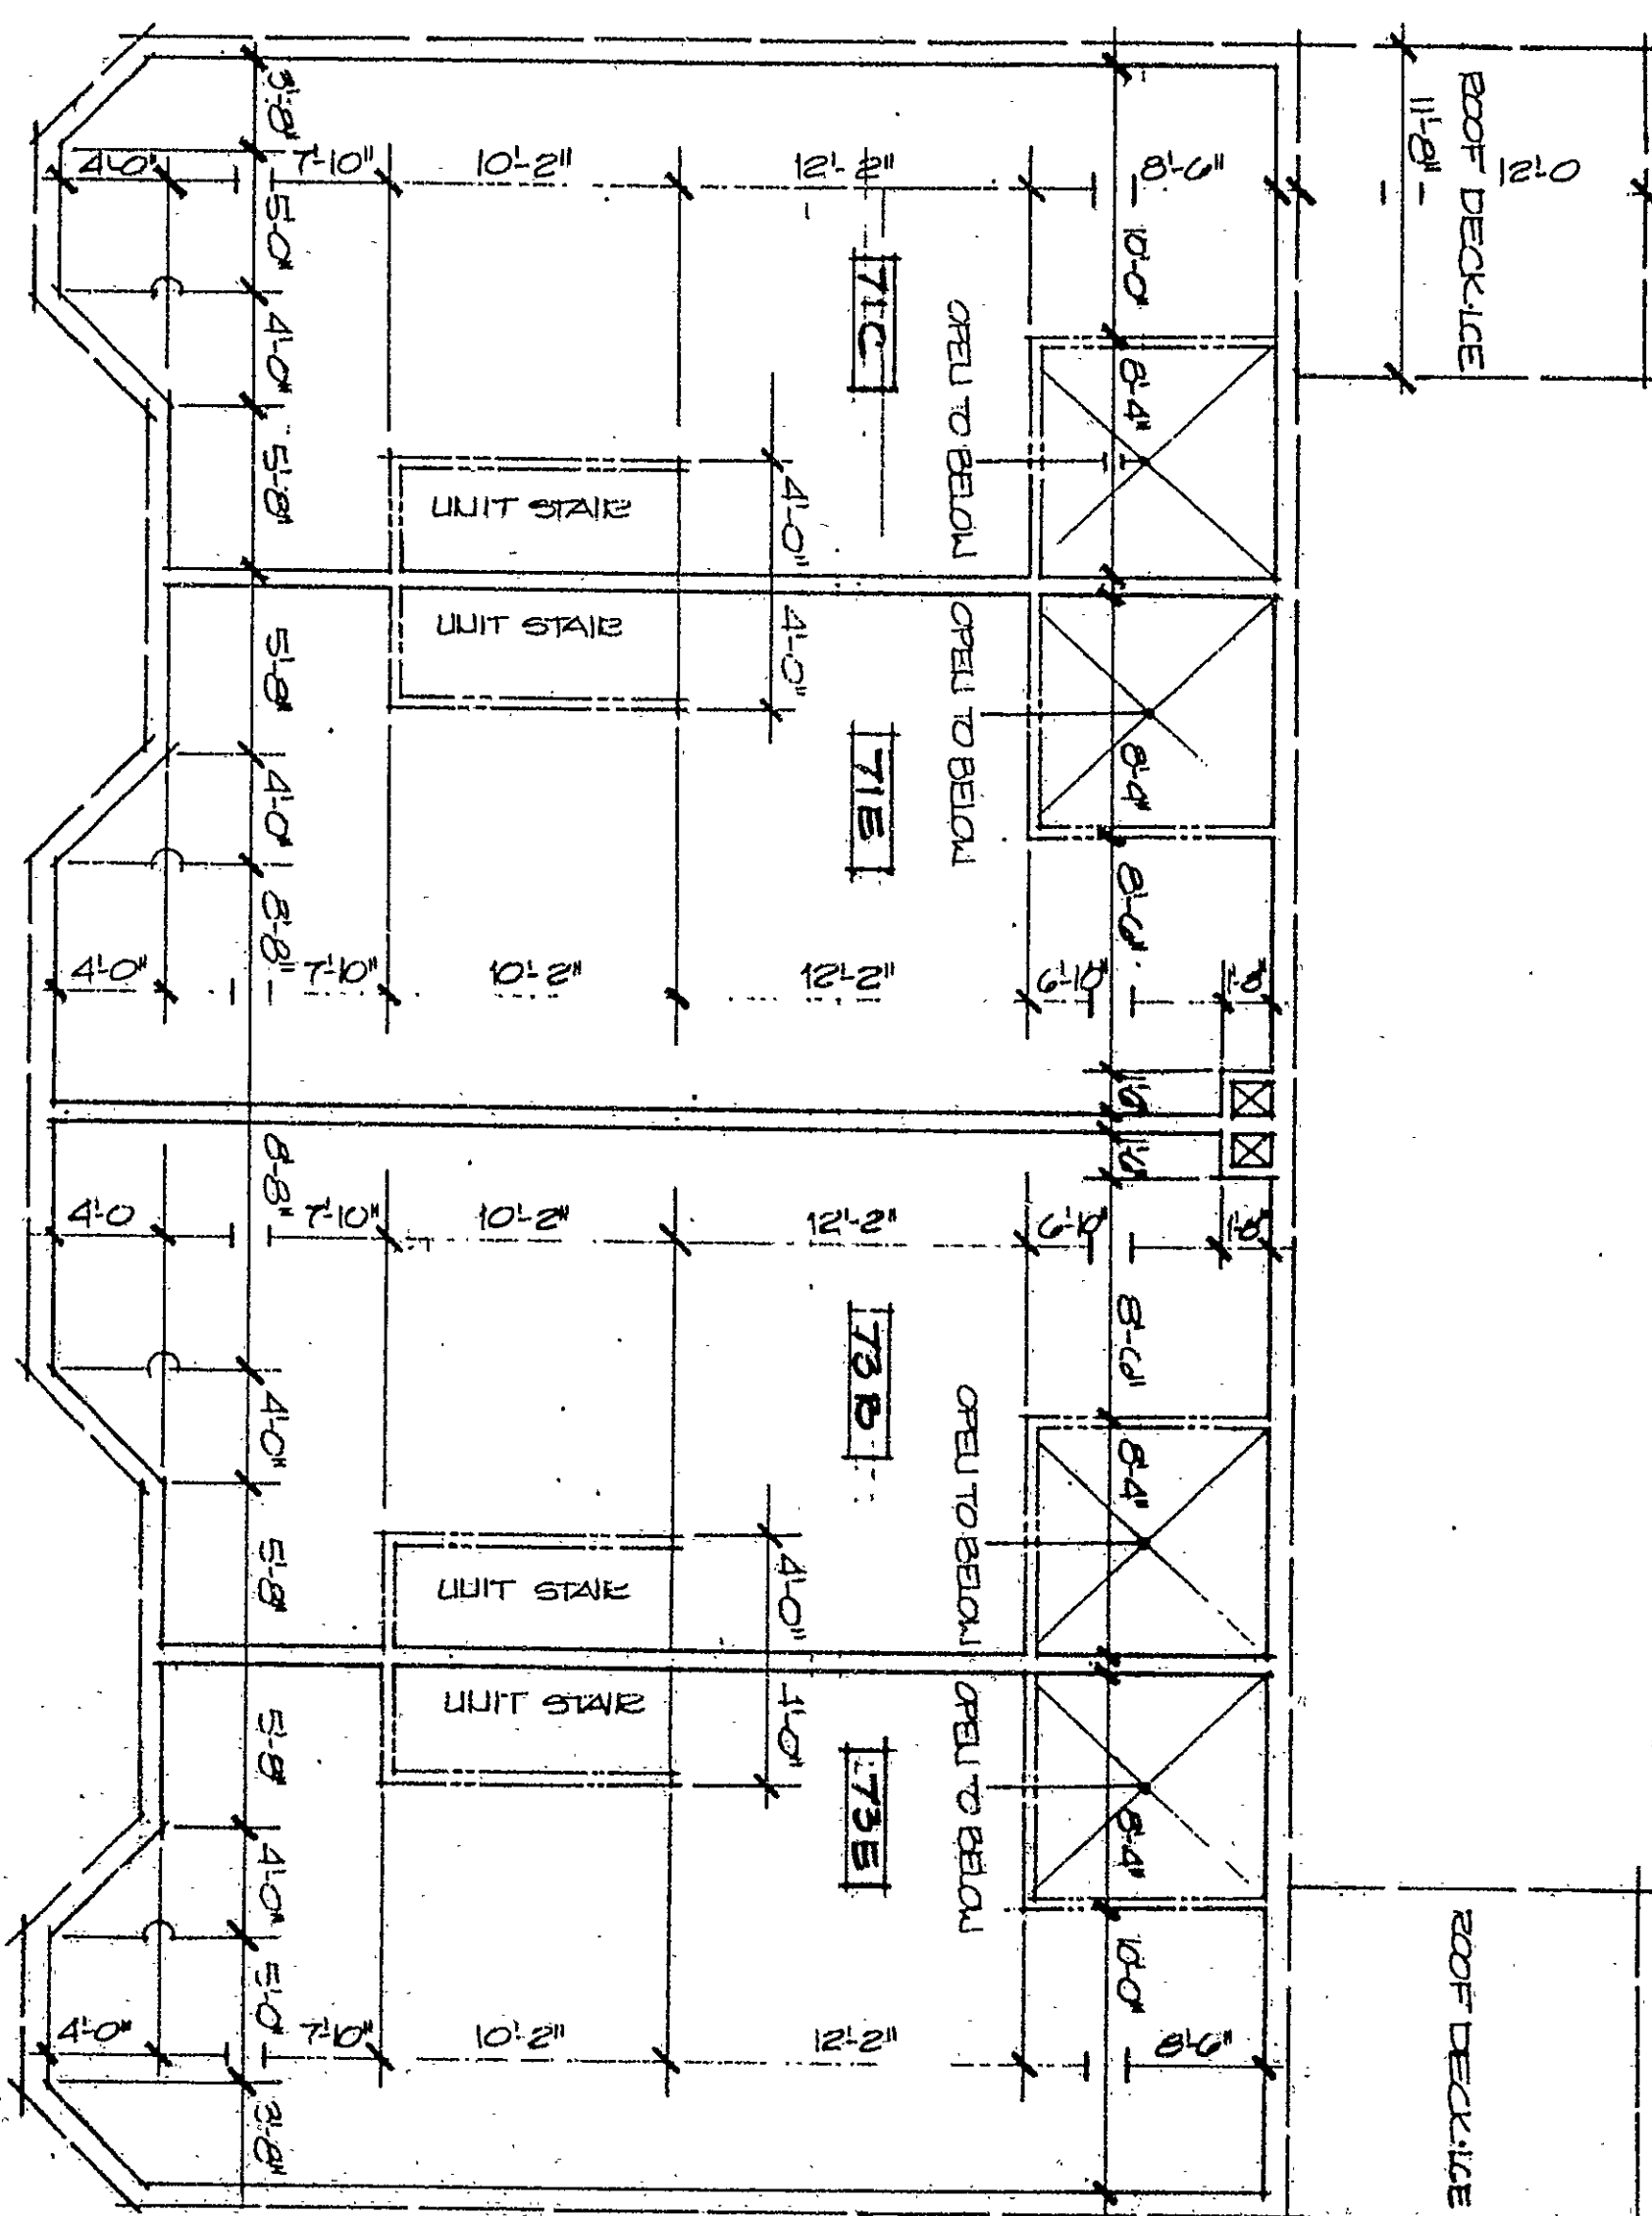

D. J. C. C. C.

Jun 1 2 31 PM '95

VOL. 11

1 THIRD FLOOR PLAN - UNIT BOUNDARIES

T/FDL = (SEE SURVEY
T/FLR. TO B/DG = 8'-0"
ELEVATIONS

T/FDU = (SEE SURVEY
T/FILE TO B/AG = 8-0)

AREA UNIT 71C, 73E
± 667.84 SQ.FT. (THIS LEVEL)
± 621.84 SQ.FT. (LOWER LEVEL)
1428.32 SQ.FT. (TOTAL UNIT AREA)
UNIT 71E, 73D
± 678.84 SQ.FT. (THIS LEVEL)
± 621.84 SQ.FT. (LOWER LEVEL)
1300.68 SQ.FT. (TOTAL UNIT AREA)

0124	8	16	24
------	---	----	----

CREST REPROGRAPHICS
FIXED LINE MYLAR

THIRD FLOOR PLAN - UNIT BOUNDARIES

SCALE: $\frac{1}{8}'' = 1'-0''$
DATE: 17 JANUARY 1995

CERTIFICATION:

THE UNDERSIGNED DOES HEREBY CERTIFY
THAT THESE PLANS CONTAIN INFORMATION REQUIRED
BY SECTION 47-22B (29) OF THE COMMON INTEREST
OWNERSHIP ACT RELATIVE TO PLANS.

Shawn J. Lind 2046
GRADUATE R.A. LICENSE #

SIGNATURE

R.A. LICENSE #

THE WORD CERTIFY IS AN
EXPRESSION OF PROFESSIONAL
OPINION WHICH IS BASED ON
HIS BEST KNOWLEDGE,
INFORMATION AND BELIEF, AND
AS SUCH IT CONSTITUTES
NEITHER A GUARANTEE NOR
WARRANTY EXPRESSED OR IMPLIED

LEGEND:
UNIT BOUND

UNIT FOUR

NOTE:
some be

INTERIOR PARTITION WALL
.....
EXTERIOR SURFACE

*GUTTERS MAY EVENTUALLY NOT BE SKINNED.
ALL DIMENSIONS AND AREAS
ARE PLUS OR MINUS ("±").


C4

76-1187-102

all contractors shall verify all existing conditions, materials, and dimensions before completing pricing, ordering, fabricating and/or assembling any & all parts of the work.

VILLA COQUI P.O.S. DOCUMENTS
71-73 CHESTNUT STREET
HARTFORD, CT
ROBERT B. MURD AIA ARCHITECT

the architects

