


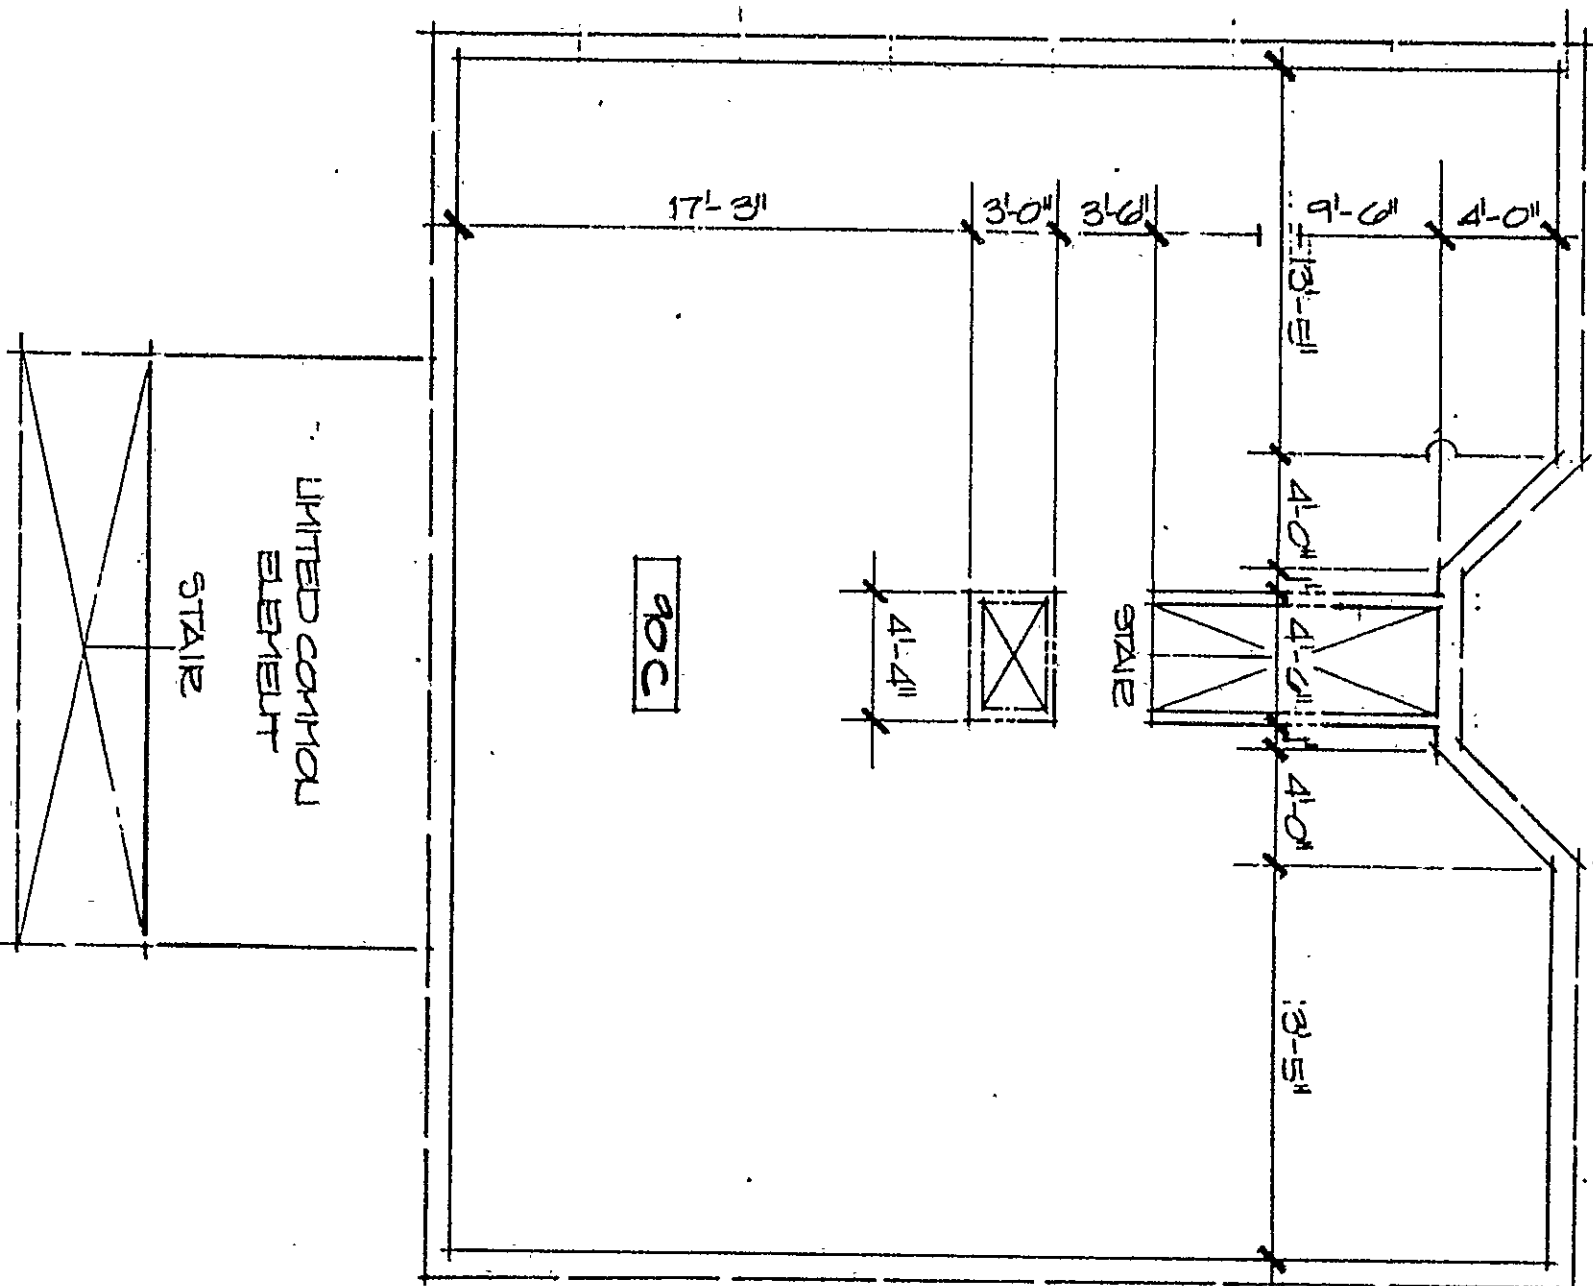

ELEVATIONS 1/16" = 1'-0" SURVEY
1/16" = 1'-0" SURVEY

AREA 1/16" = 1'-0" SURVEY
1/16" = 1'-0" SURVEY

1 SECOND FLOOR RAIL-UNIT BOUNDARY
SCALE: 1/16" = 1'-0"

0 12 4 8 16 24

RECEIVED BY
D. J. J. J. J.
JUN 1 2 31 PM '95
TWO...
VOL...

CERTIFICATION:
THE UNDERSIGNED, ROBERT B. HURD, CERTIFY THAT THESE PLANS, SPECIFICATIONS, AND OTHER DOCUMENTS REQUIRED BY SECTION 47-228 (29) OF THE COMMON INTEREST OWNERSHIP ACT RELATING TO PLANS, SPECIFICATIONS, AND OTHER DOCUMENTS REQUIRED BY SECTION 47-228 (29) OF THE COMMON INTEREST OWNERSHIP ACT, WERE PREPARED BY ME OR UNDER MY CLOSE PERSONAL SUPERVISION AND TO THE BEST OF MY KNOWLEDGE, INFORMATION AND 

SIGNATURE: *Robert B. Hurd* RA LICENSE # 12446


LEGEND:
UNIT BOUNDARY

NOTE:
SOME BEARING WALLS, GROUND, WALLS, AND OTHER STRUCTURES SHALL BE SHOWN.
ALL DIMENSIONS AND AREAS ARE PLANS OR VOLUMES ("2").

CHEST REPROGRAPHICS
EXERCISE LINE MYLAR

SECOND FLOOR RAIL-UNIT BOUNDARIES
SCALE: 1/16" = 1'-0"
DATE: 17 JANUARY 1993

all contractors shall verify all existing conditions, materials, and dimensions before completing pricing, ordering, fabricating and/or assembling any & all parts of the work.
VILLA COGNI P.O.S. DOCUMENTS
90 EDWARDS STREET
HARTFORD, CT.
ROBERT B. HURD AIA ARCHITECT

0 INCHES 1 2 3 4

Floor Plan #115