
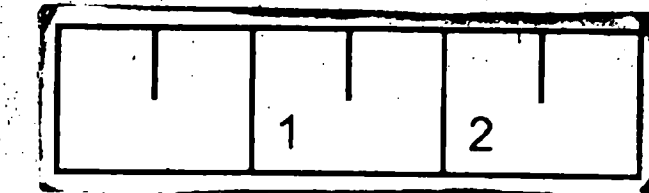
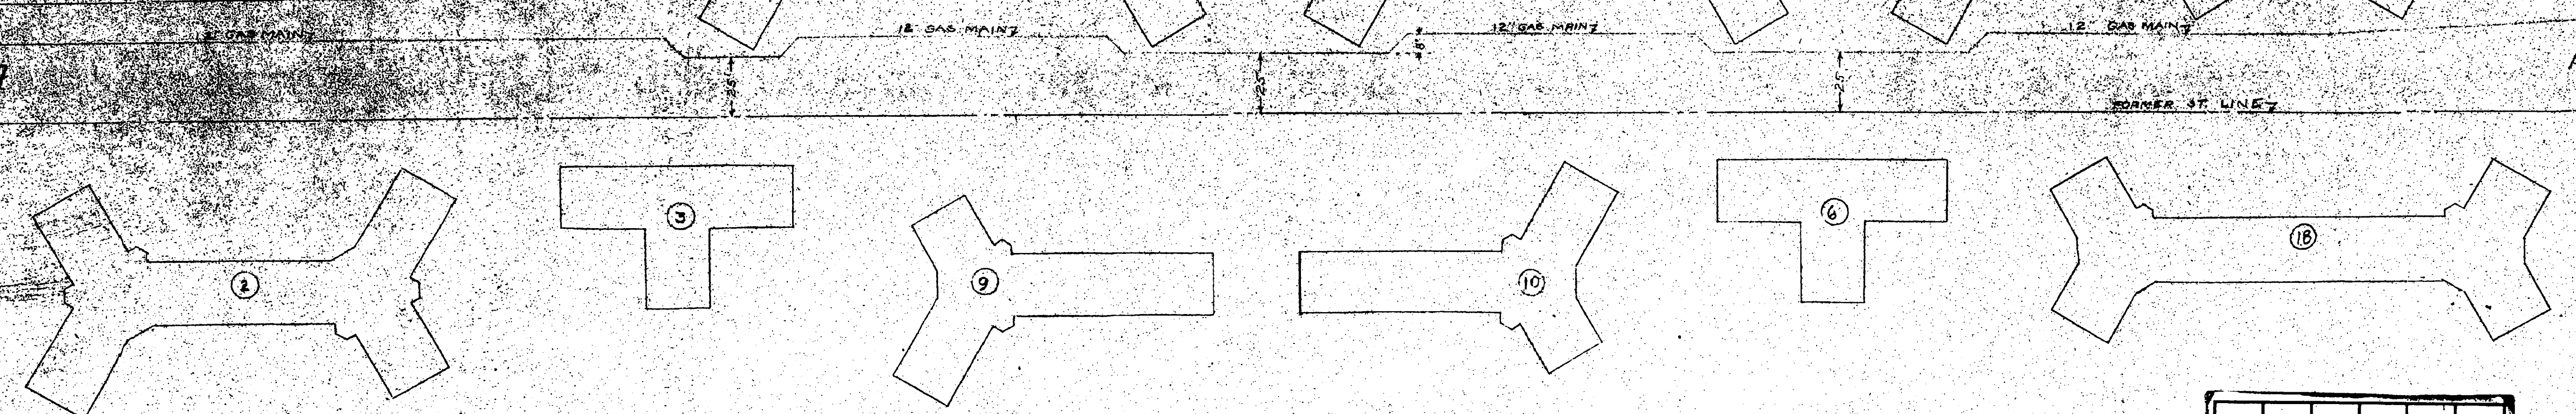


LOCATION OF 12" GAS MAIN
ON
HOUSING AUTHORITY
OF THE
CITY OF HARTFORD PROPERTY
AT
BELLEVUE SQUARE
SCALE 1"=40'

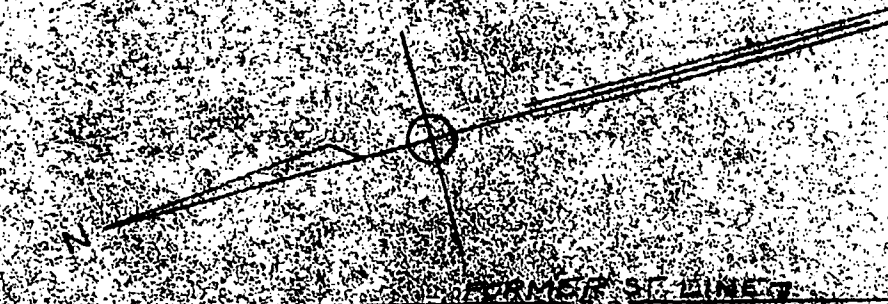

12 VALVE 16 1/2\"/>

ST

CANTON