


The Woodland Park Corporation

Moryette D. Cox

William B. Goodwin et al, Trustees

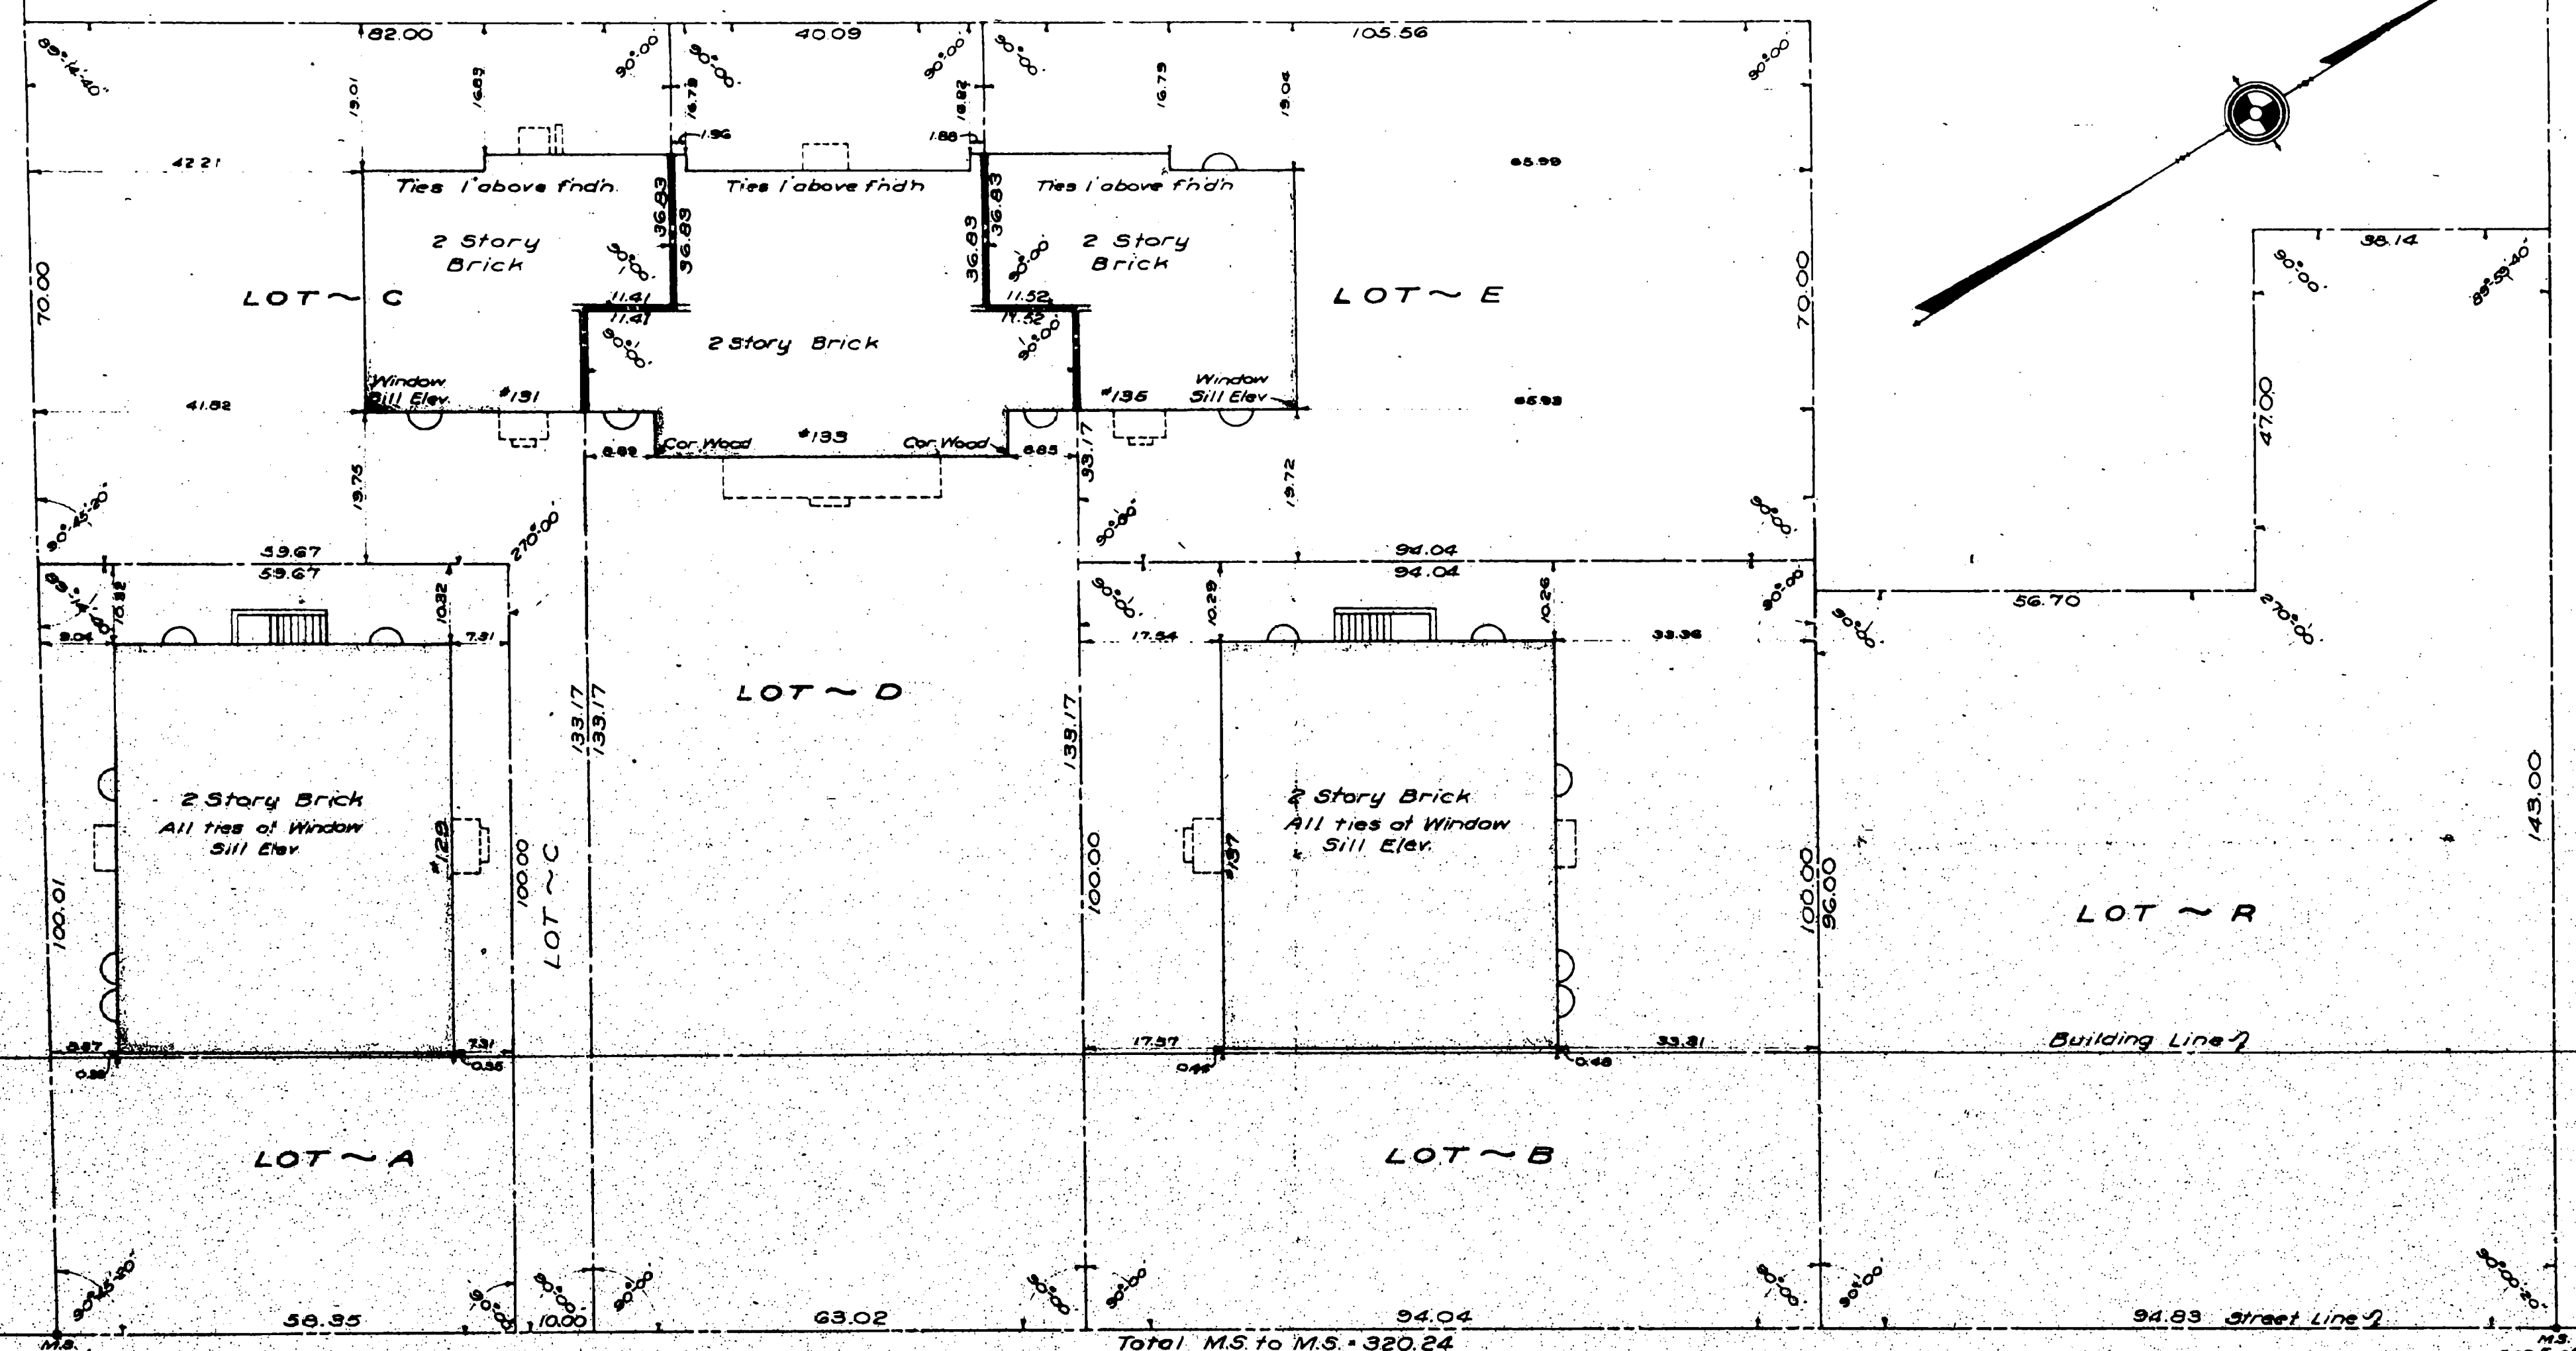


WOODLAND STREET

TOTAL AREA = 49,407.5 SQ. FT.
 PROPERTY OF
THE WOODLAND PARK CORPORATION
 HARTFORD, CONNECTICUT
 Scale 1" = 20' June 16, 1941

Certified substantially correct.

J. F. Neuhaus
 Civil Engineer

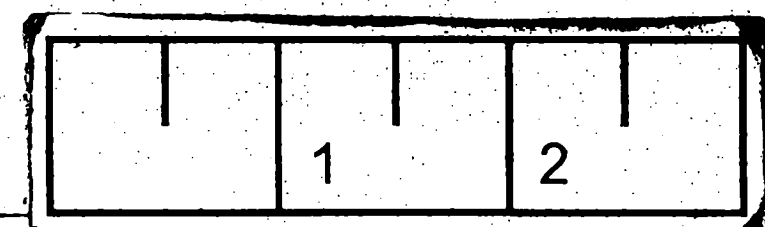

THEODORE F. NEUHAUS
 CIVIL ENGINEER
 WINDSOR, CONNECTICUT
 COMMISSION NO. 233