


LAWRENCE STREET
50' ST

RUSS STREET
50' ST

BROAD STREET
50' ST

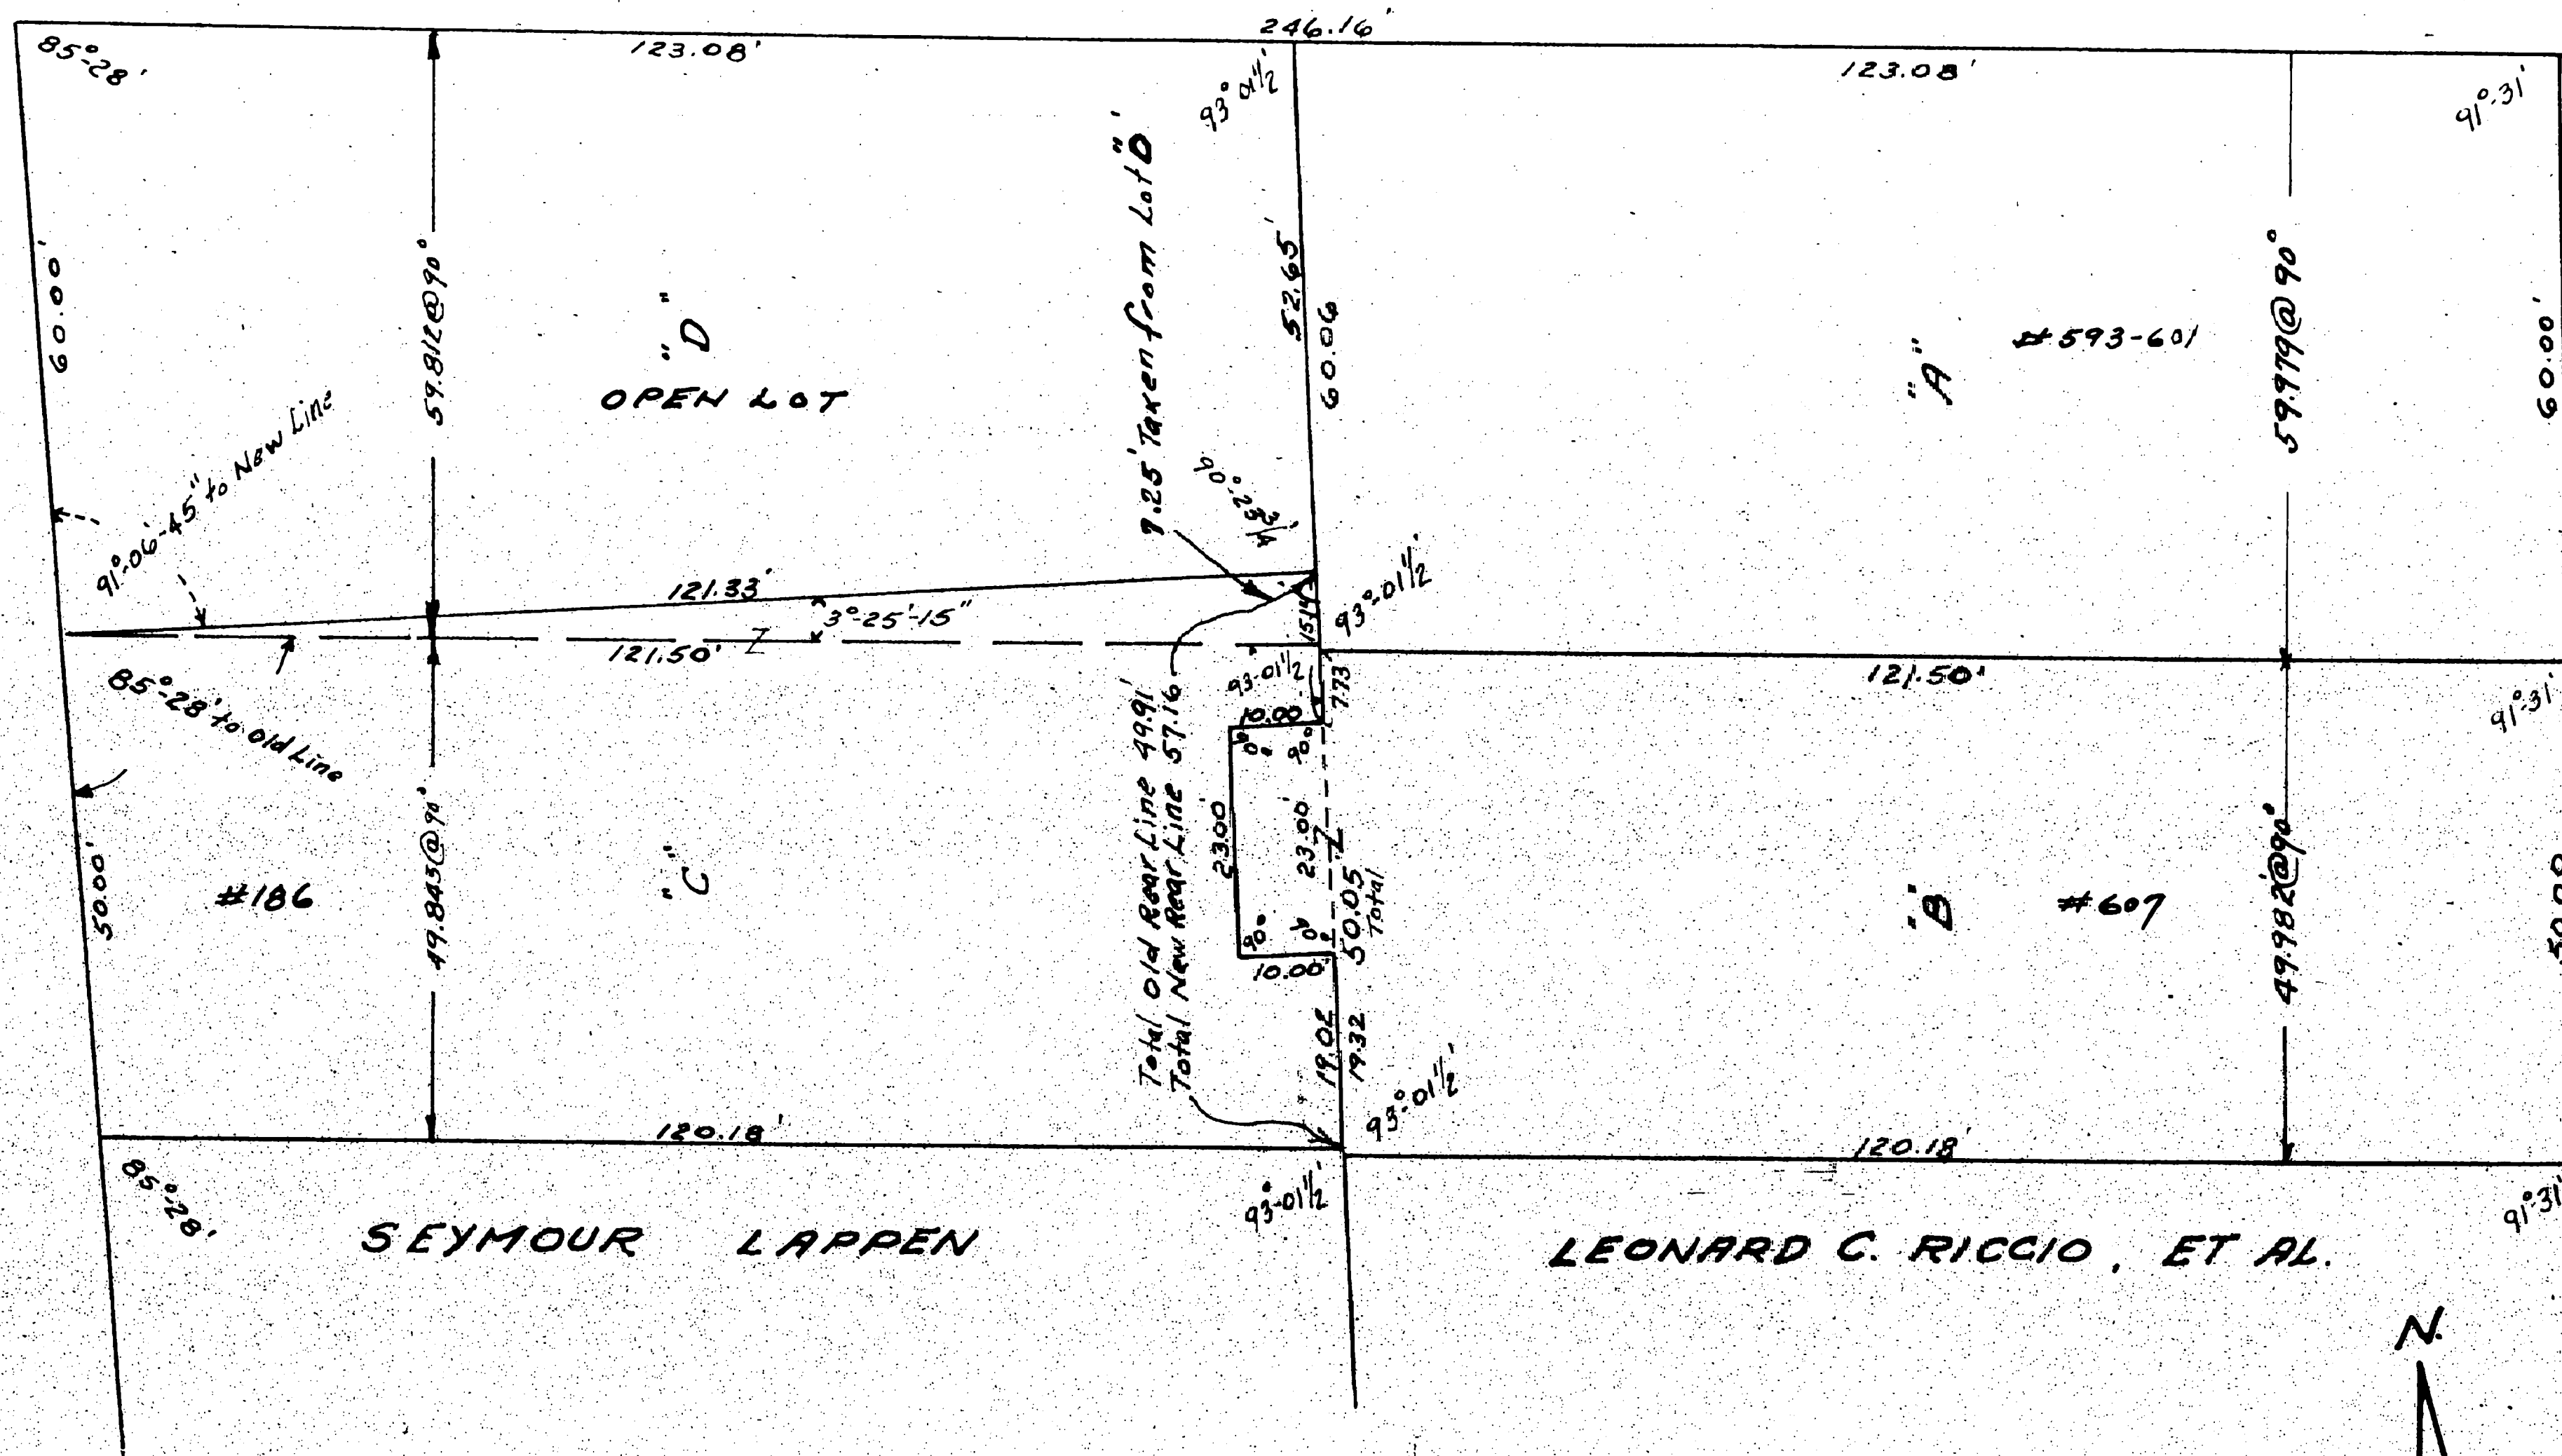

REVISED PLAN OF LOTS
being Property of
CHRISTIAN H. OLESEN
Located on
Nos. 593-607 BROAD and 186 LAWRENCE STREETS
HARTFORD, CONN.
SCALE 1" = 20'
SEPT. 22, 1941
I hereby Certify that this Plan is Substantially Correct

Philip J. LaCava
Surveyor



		1		2					