208-1

I hereby certify that this is substantially correct.

Civil Engineer
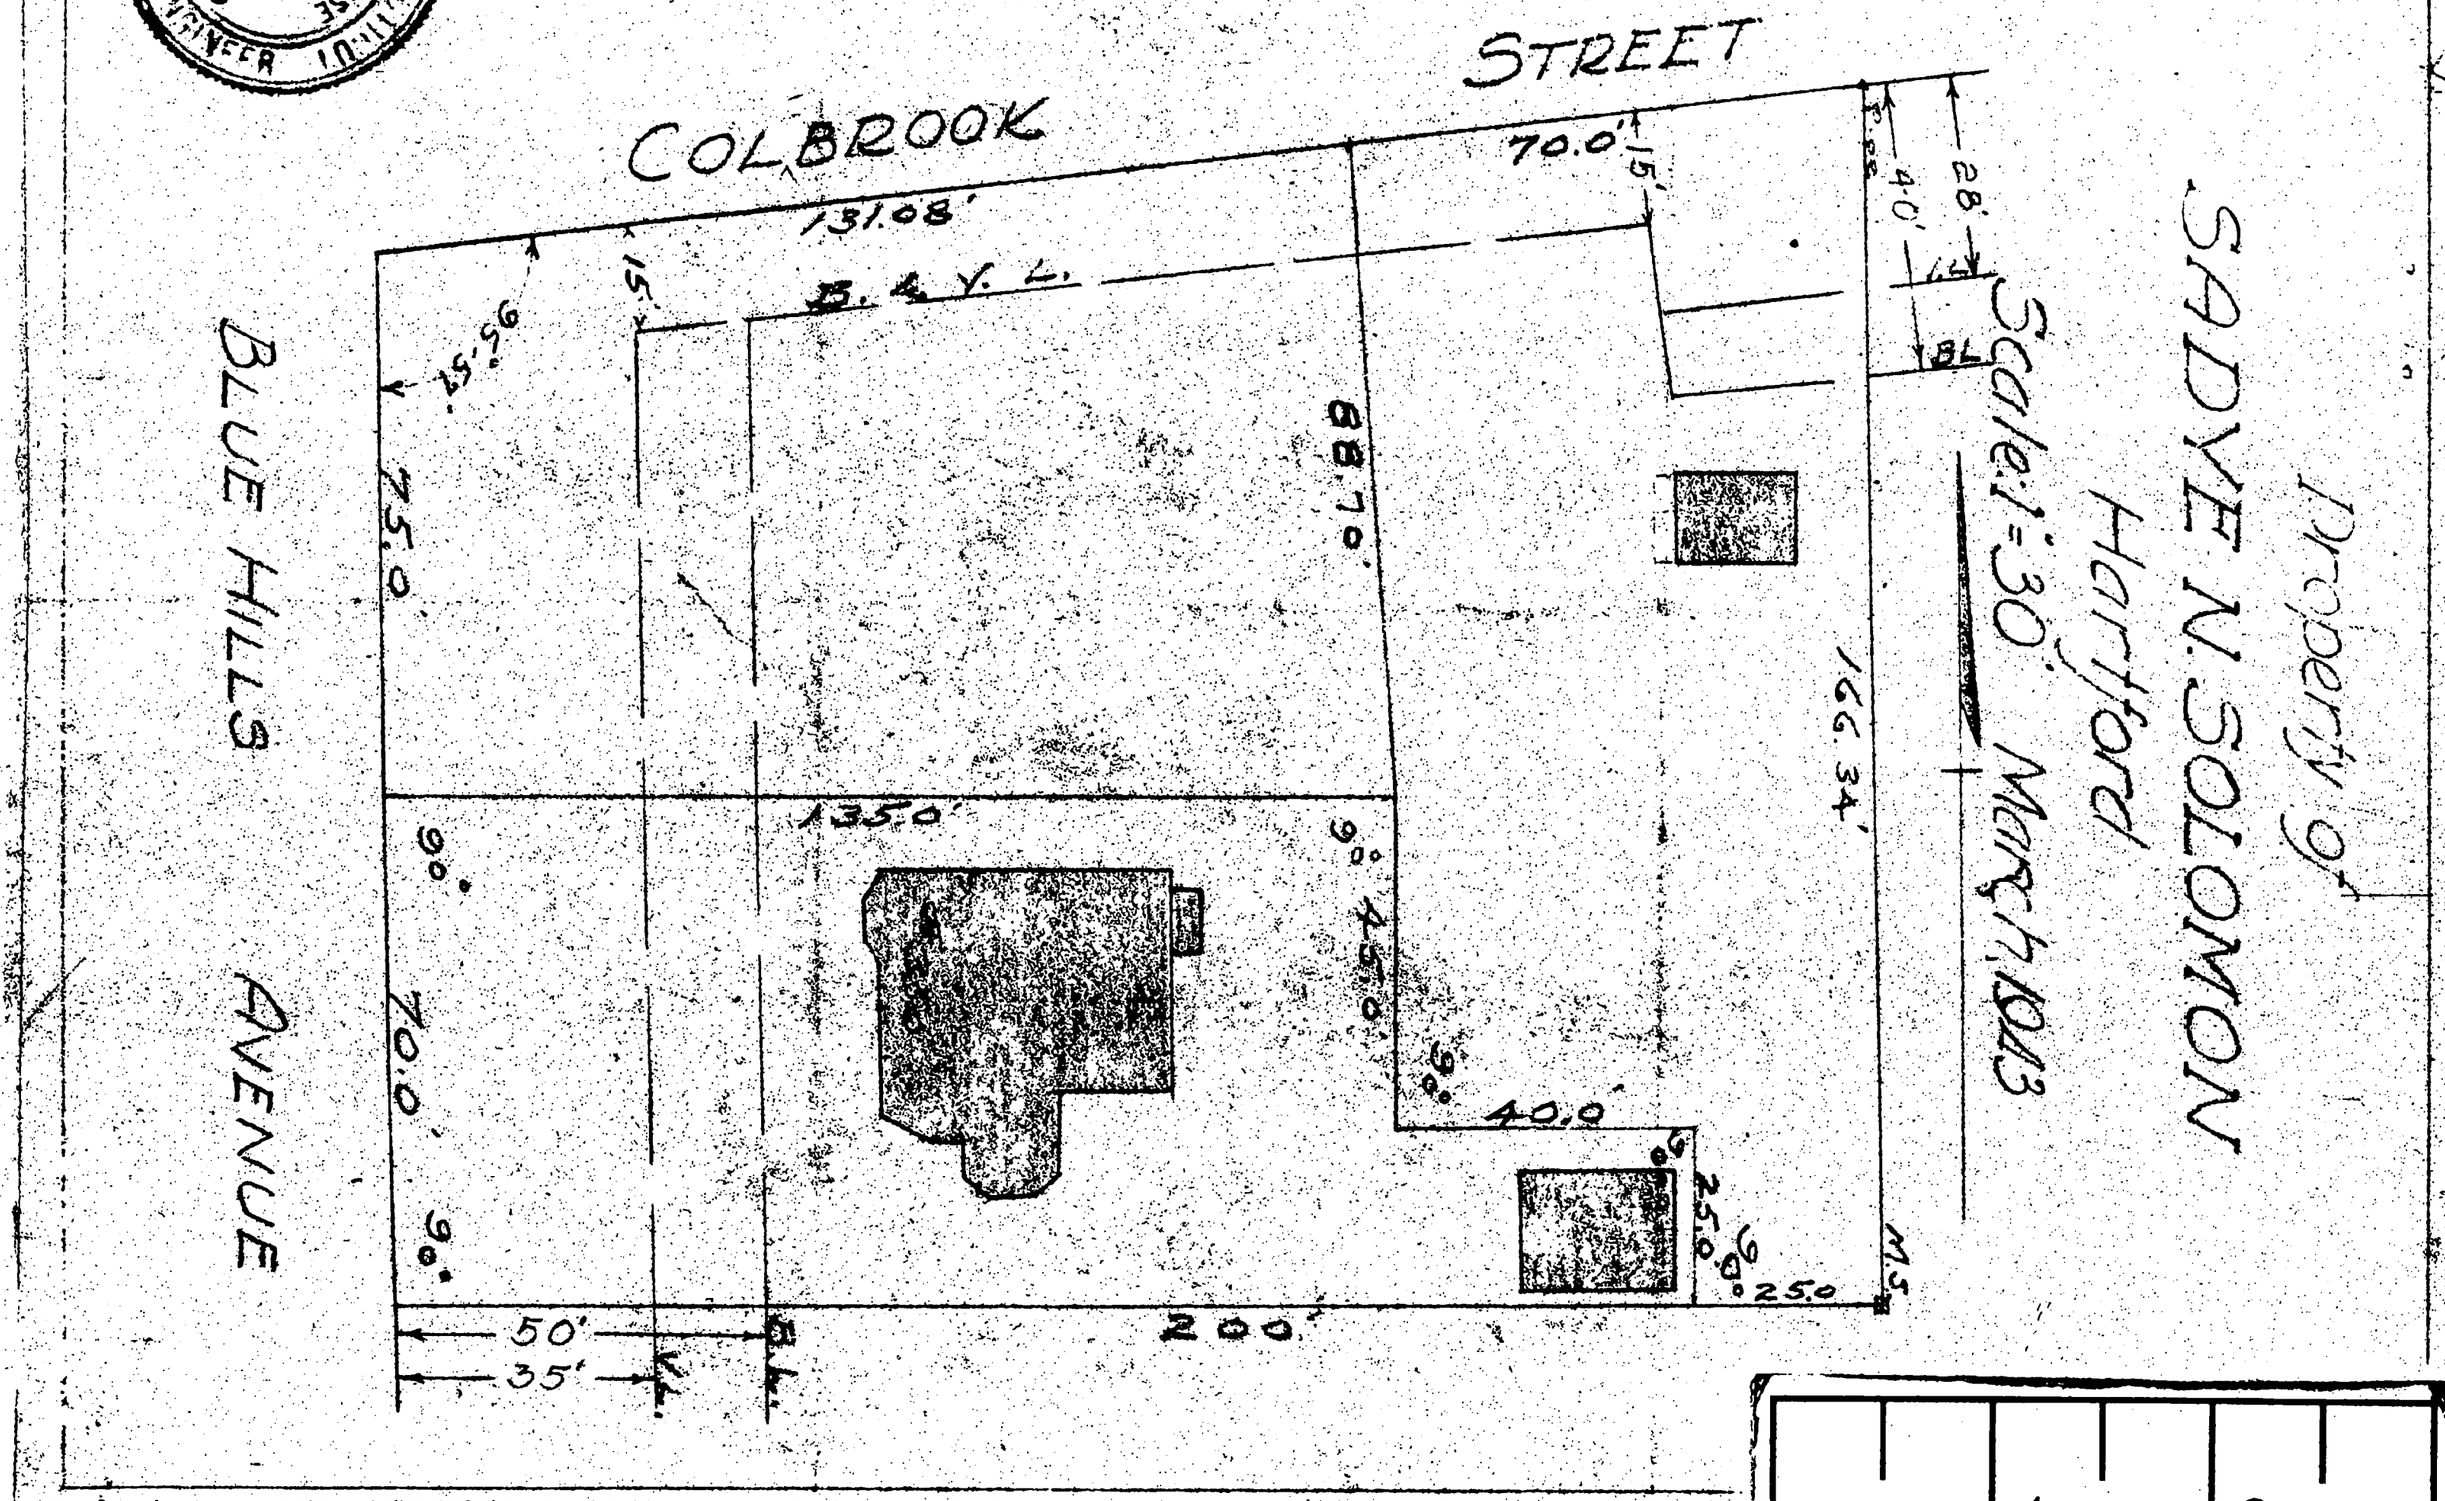
STATE OF CONNECTICUT
F. PENNY CLOSE
REGISTERED
CIVIL ENGINEER