422

The portion of Edwards St. shown on this plan is an established public street of the City of Hartford.
October 28, 1957
Winfield Sullivan
CITY ENGINEER
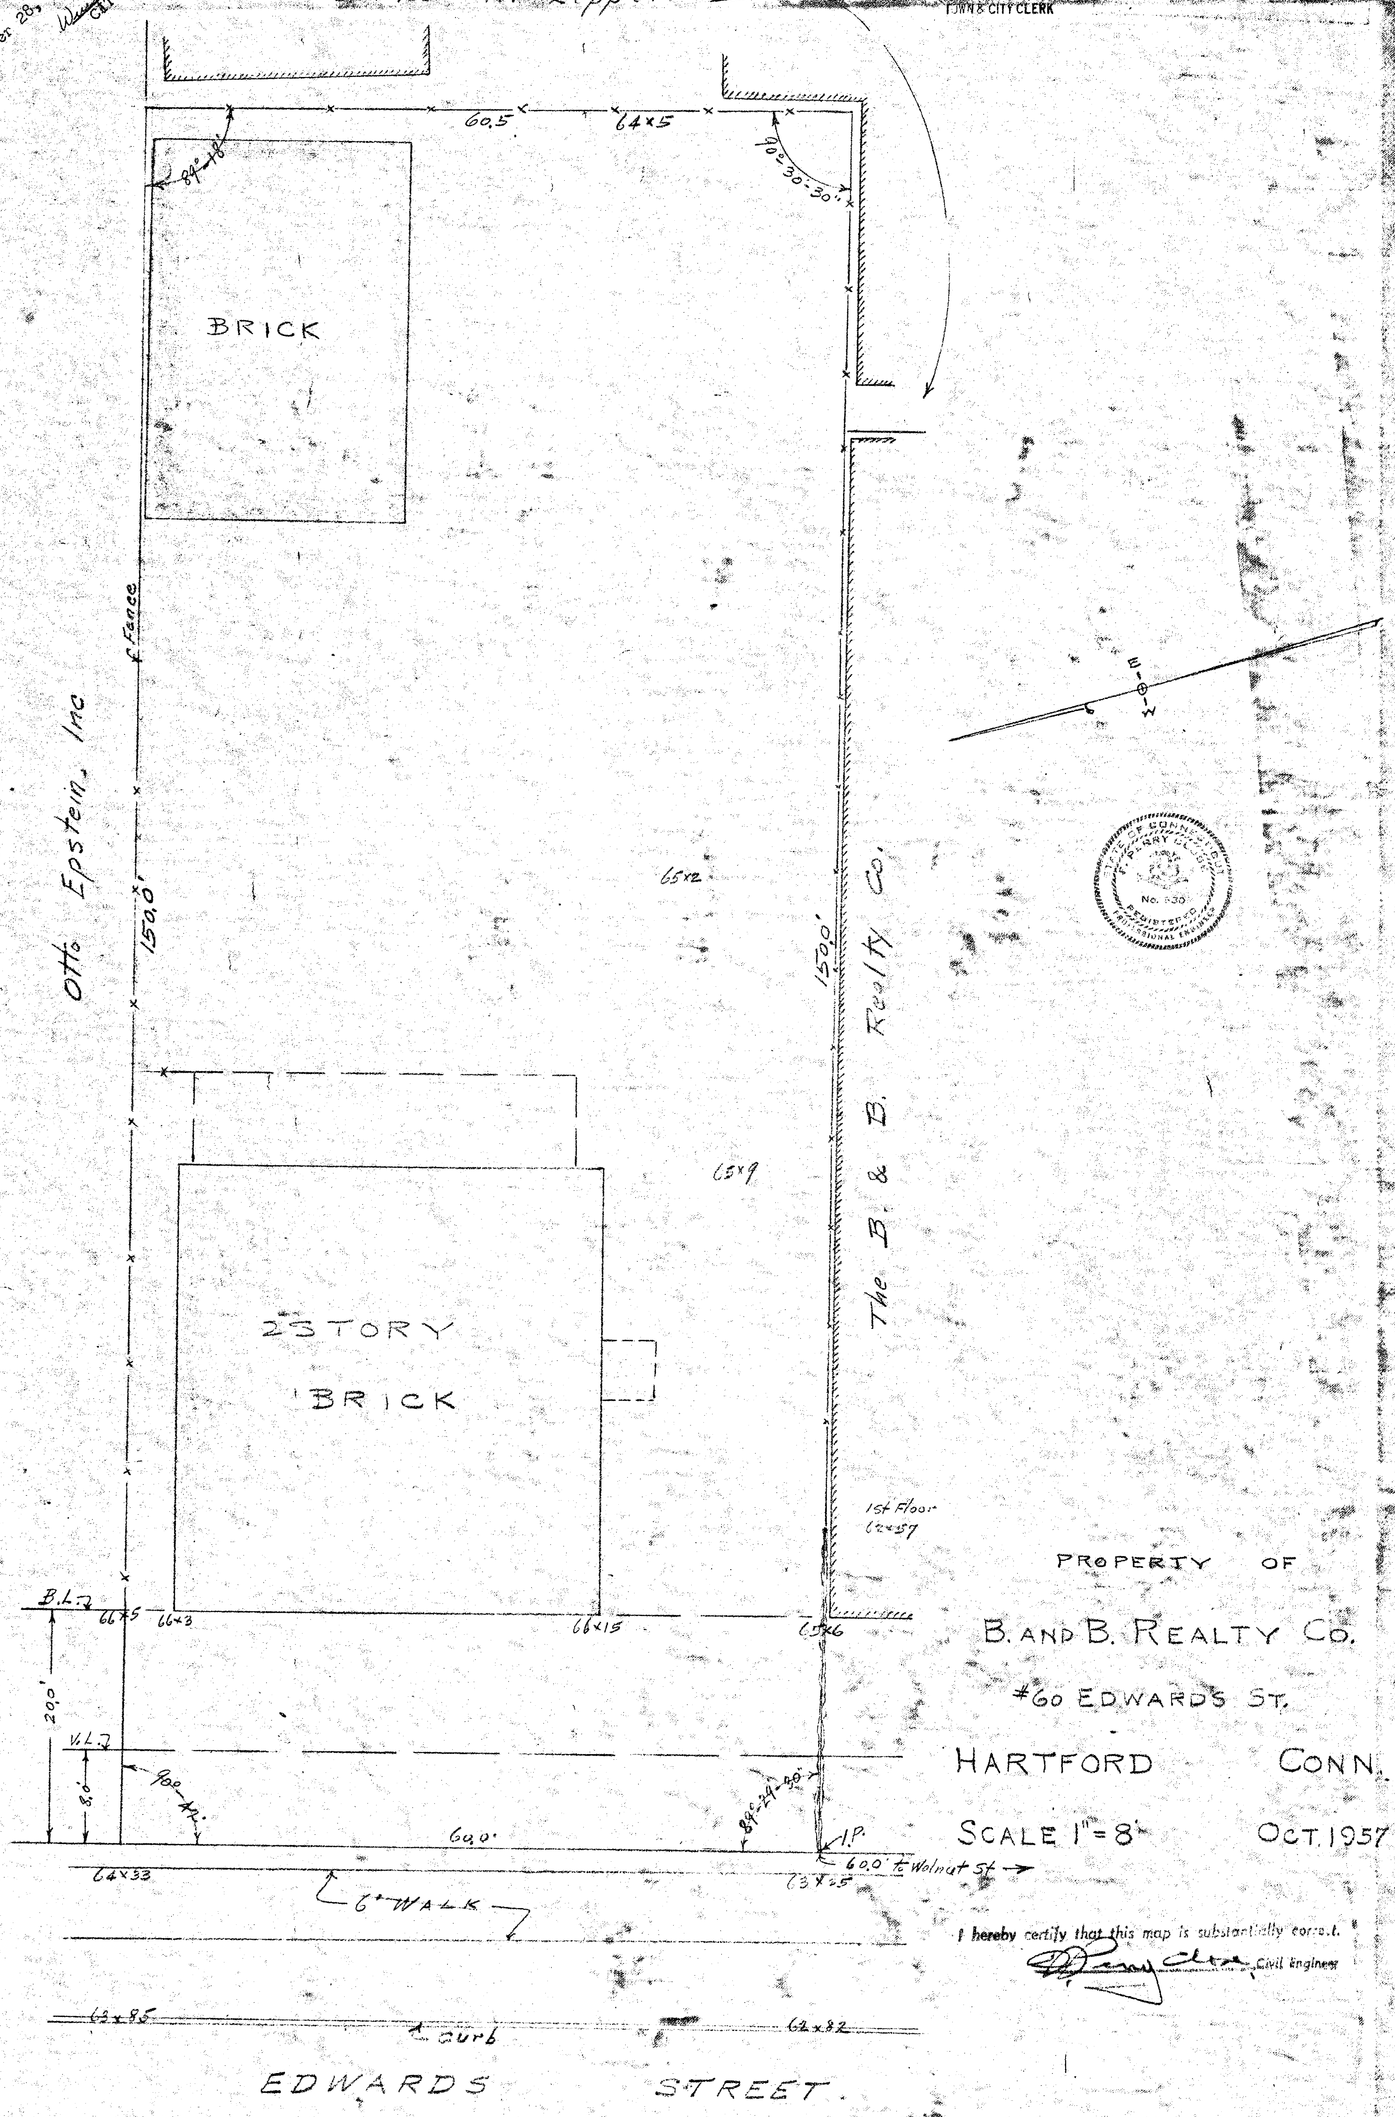
RECEIVED
HARTFORD, CONN.
Oct 23 3 35 PM '57
WILLIAM A. LINNANE
TOWN & CITY CLERK