


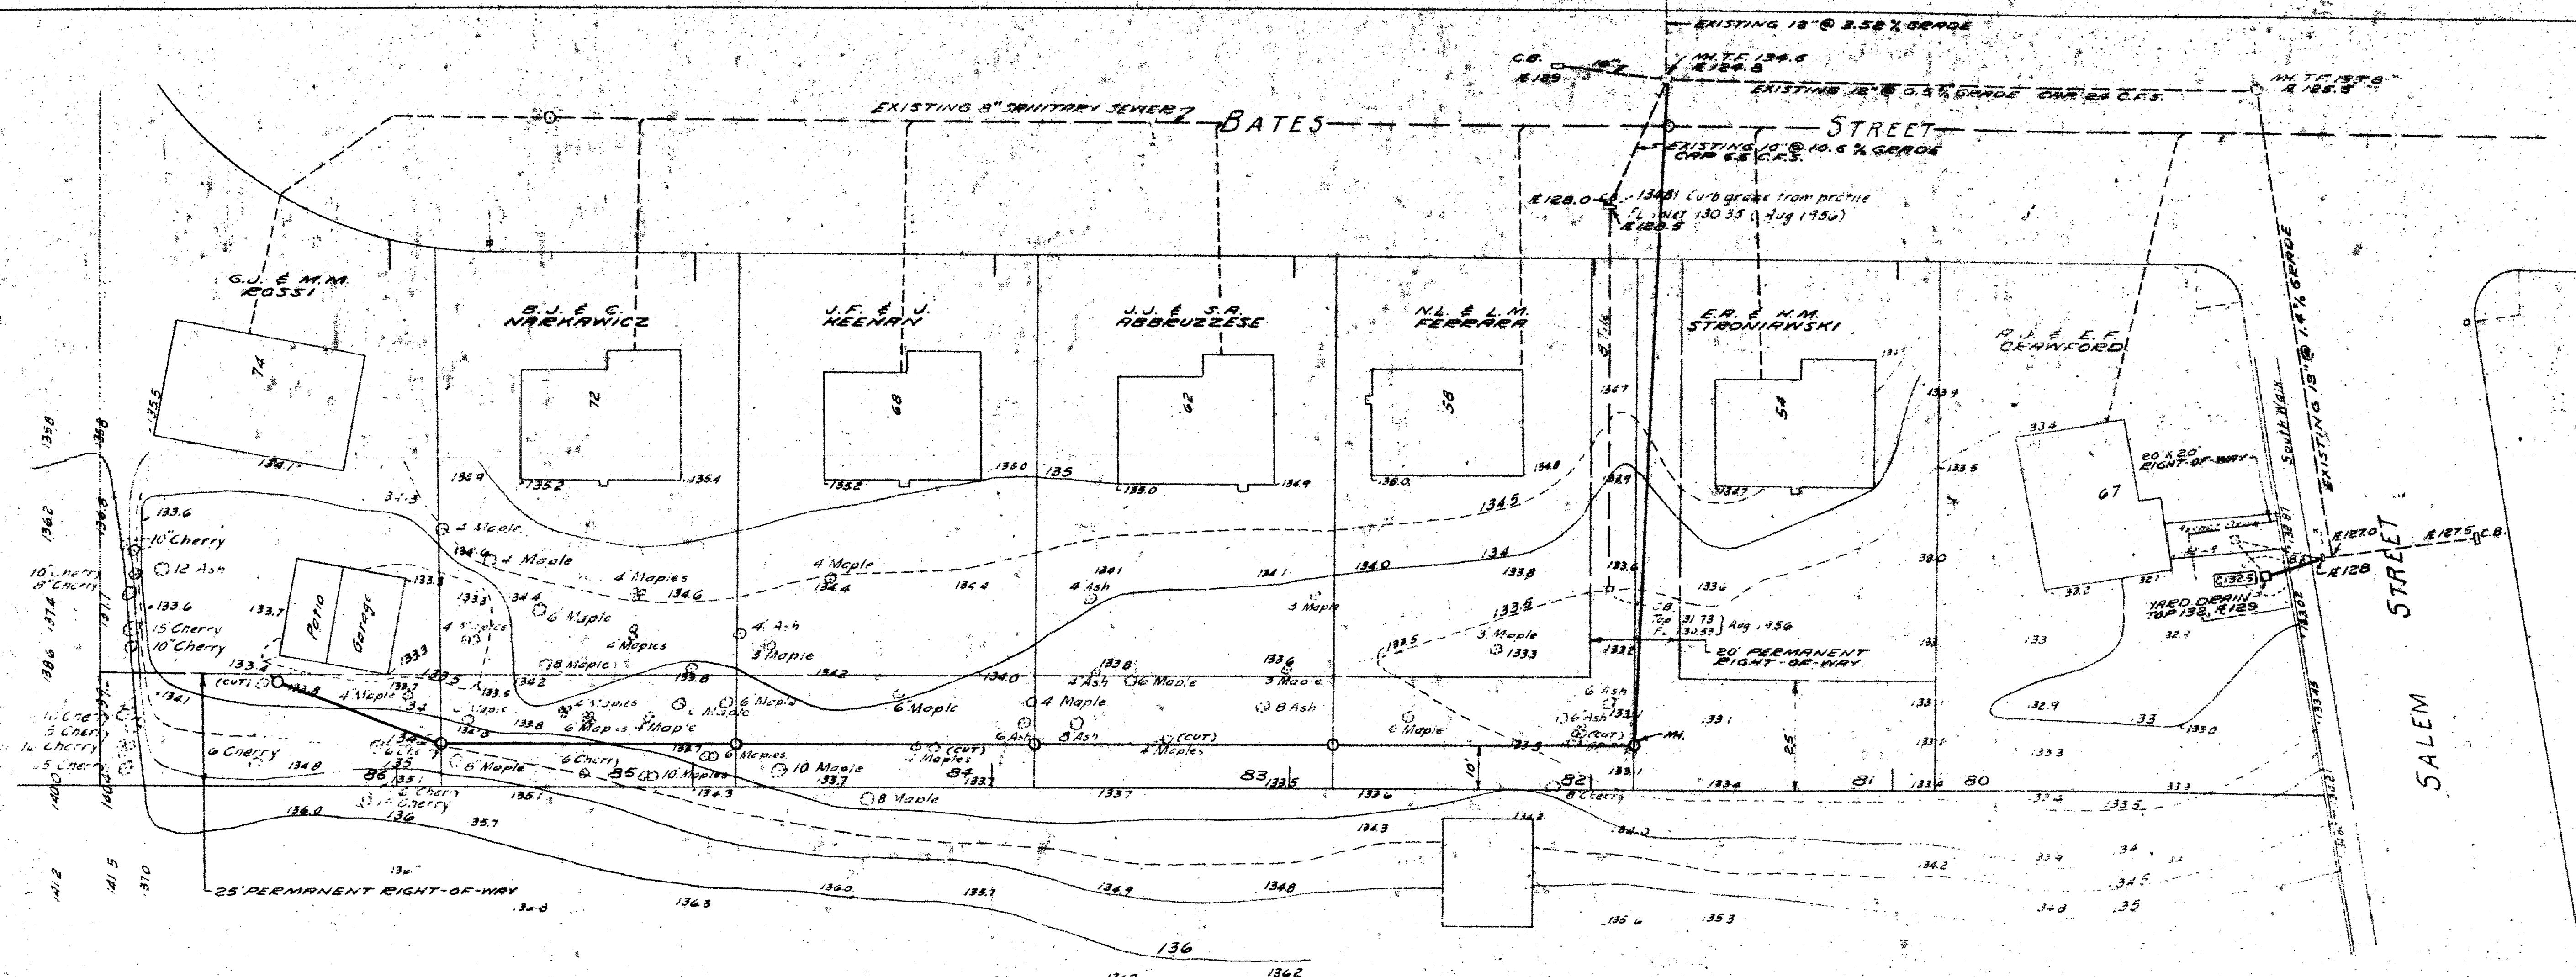

9 1955 Trees planted

Notes 808, P. 83

THE METROPOLITAN DISTRICT
BUREAU OF PUBLIC WORKS
112 BROAD STREET, HARTFORD, CONNECTICUT

ASSESSMENT & RIGHT-OF-WAY
PLAN FOR
BATES STREET
STORM DRAINS
HARTFORD
SCALE 1"=20'
SERIAL NO 12053 APRIL 1955

The position of Bates St. and
Salem St. shown on this plan
are established by the
City of Hartford
City Engineer
May 21, 1955

