

450-3

The portion of Maple Avenue shown on this plan is an established public street of the City of Hartford.

Aug. 28, 1958

Certified substantially correct.

William J. Bellamy
CITY ENGINEER

August 1958

Scale 1"=20'

Vincent J. Jaramila
found drawings

RECEIVED
HARTFORD, CONN.

AUG 25 10 33 AM '58

WILLIAM A. LINNANE
TOWN & CITY CLERK

Carl A. Chudzik


Surveyor

Recco Zito

Rosalina M. Casale

Sidney Mischel, et al

The 130 Corporation

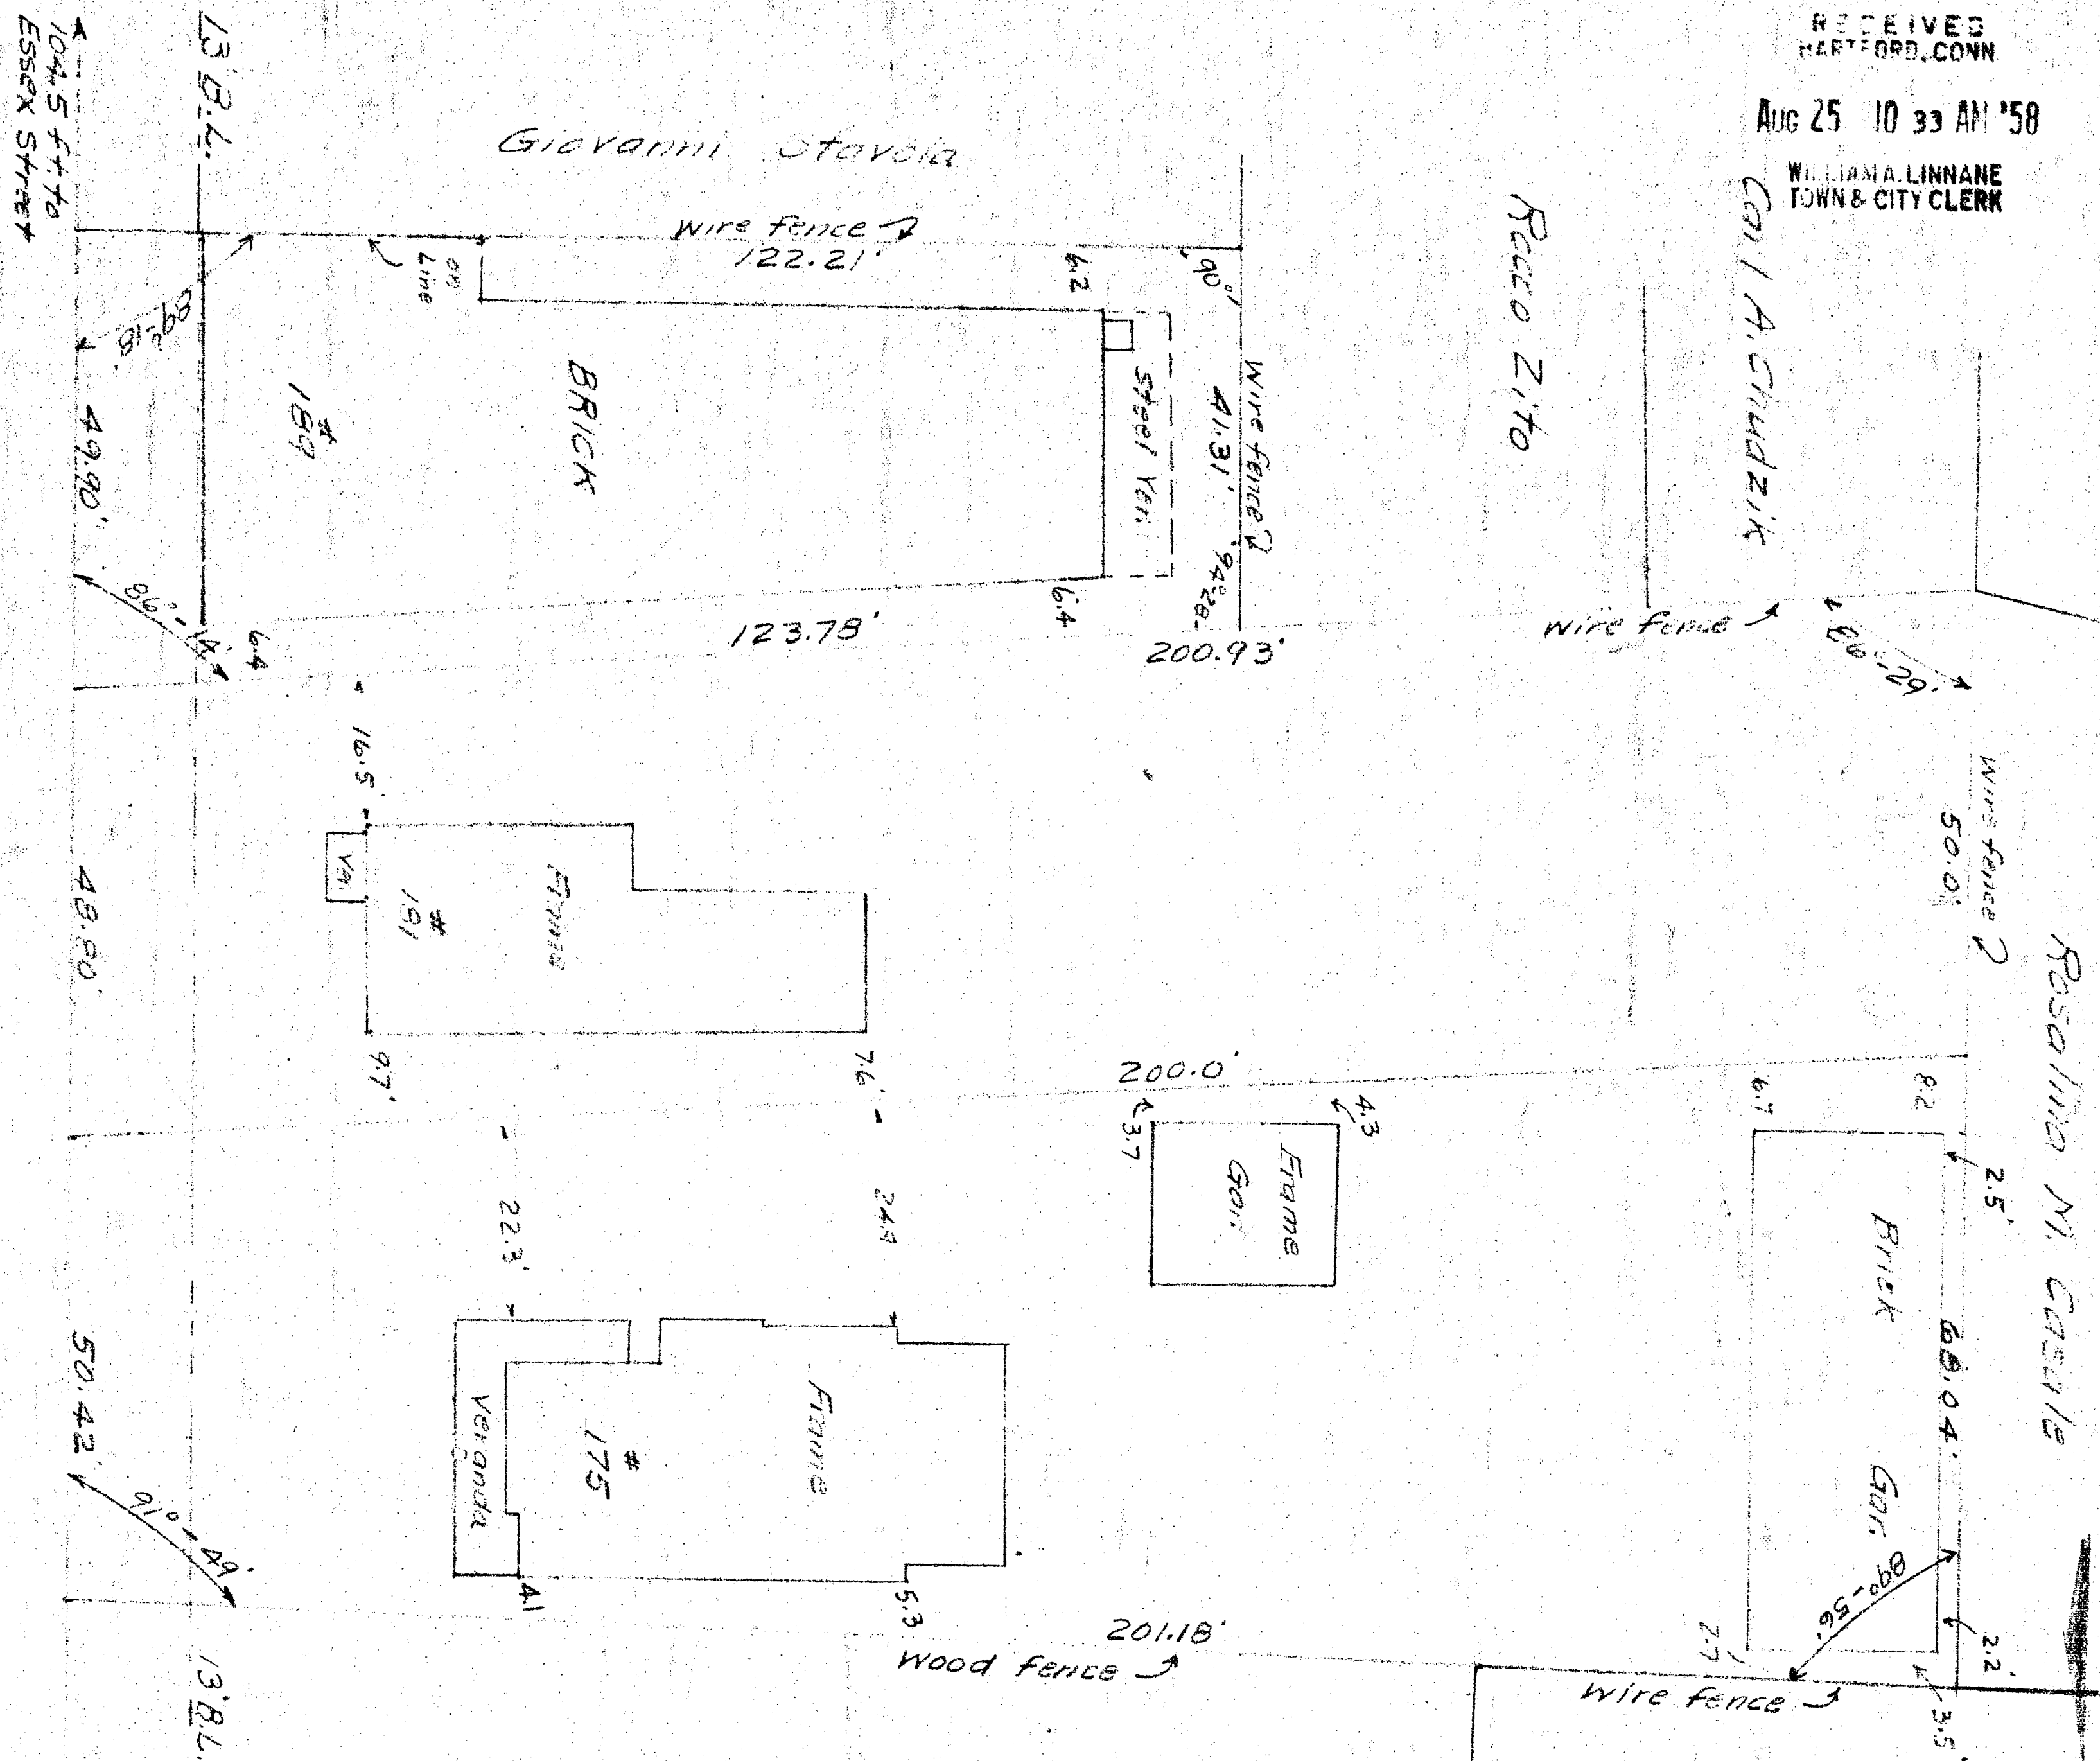

MAPLE

AVENUE

