


465

RECEIVED
HARTFORD, CONN.

JUN 18 4 08 PM '59

WILLIAM A. LINNANE
TOWN & CITY CLERK

The Hartford Electric Steel Company

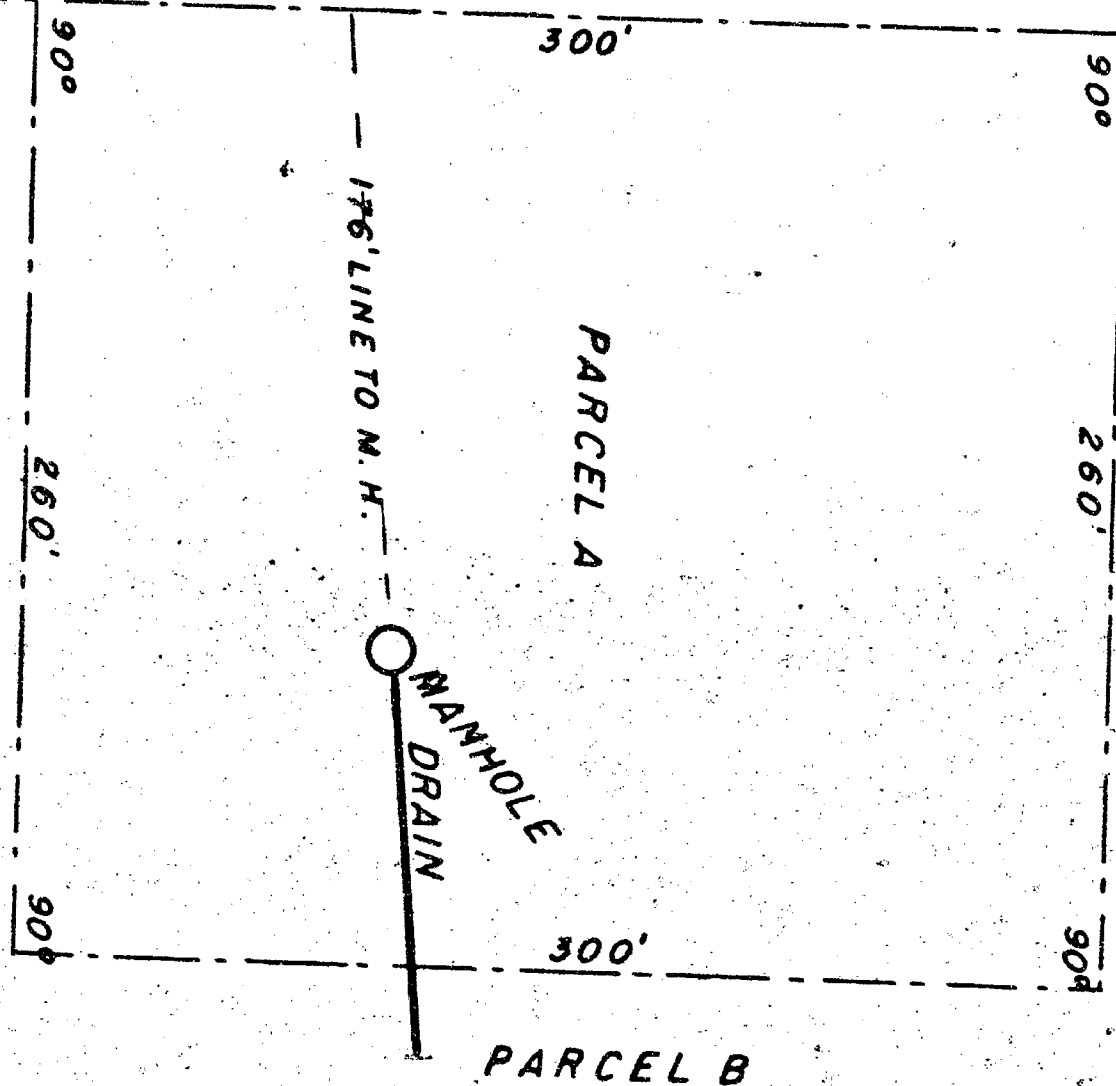

Map of Land Owned by
THE HARTFORD ELECTRIC STEEL COMPANY
Showing a Manhole and a Drain.
HARTFORD, CONN. Scale 1" = 80'
June 18, 1959



I HEREBY CERTIFY THAT THIS PLAN
IS SUBSTANTIALLY CORRECT.

John T. Henderson

John T. Henderson,
Consulting Engineer,
Hartford, Conn.

0 INCHES 1 2 3 4