
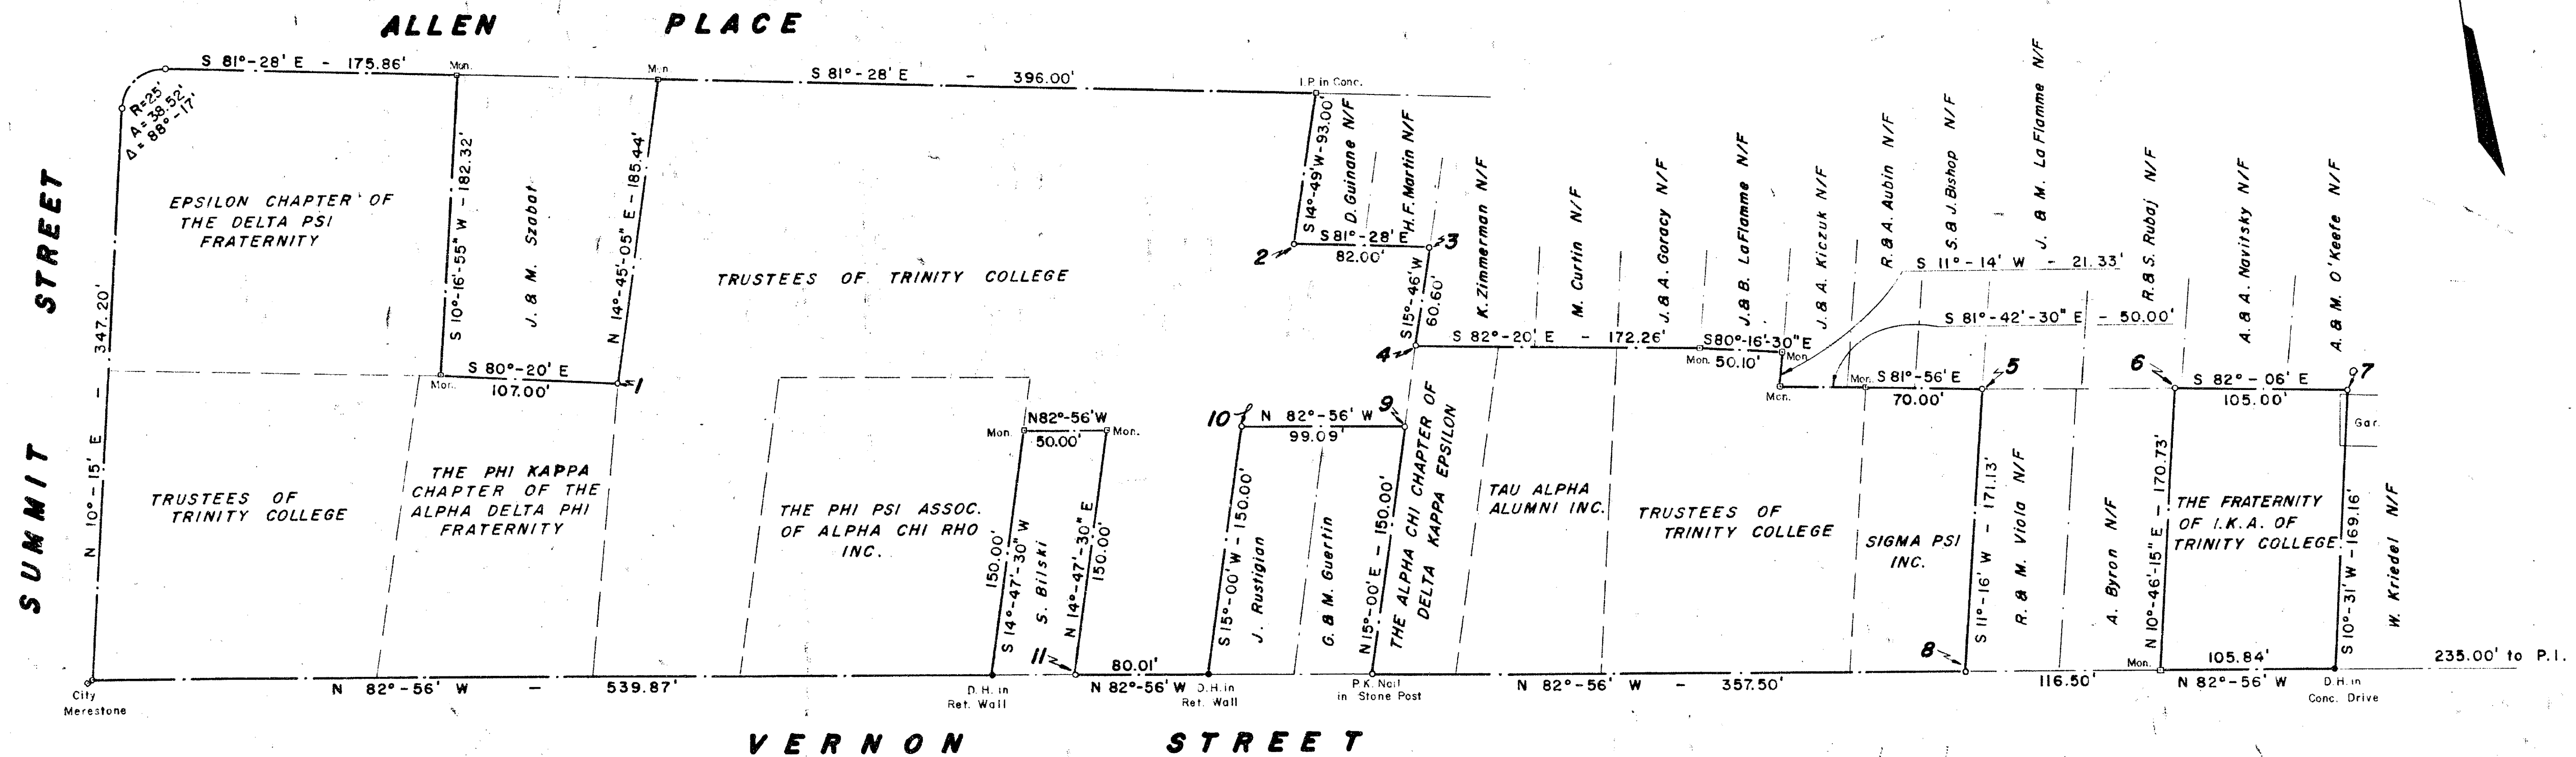


RECEIVED
HARTFORD, CONN.
FEB 17 10 54 AM '60
WILLIAM A. LINNANE
TOWN & CITY CLERK

SURVEY MAP Showing the Properties Of TRINITY COLLEGE & COLLEGE FRATERNITIES HARTFORD, CONN.

INSERTS Showing Location of
Property Markers
NOT TO SCALE

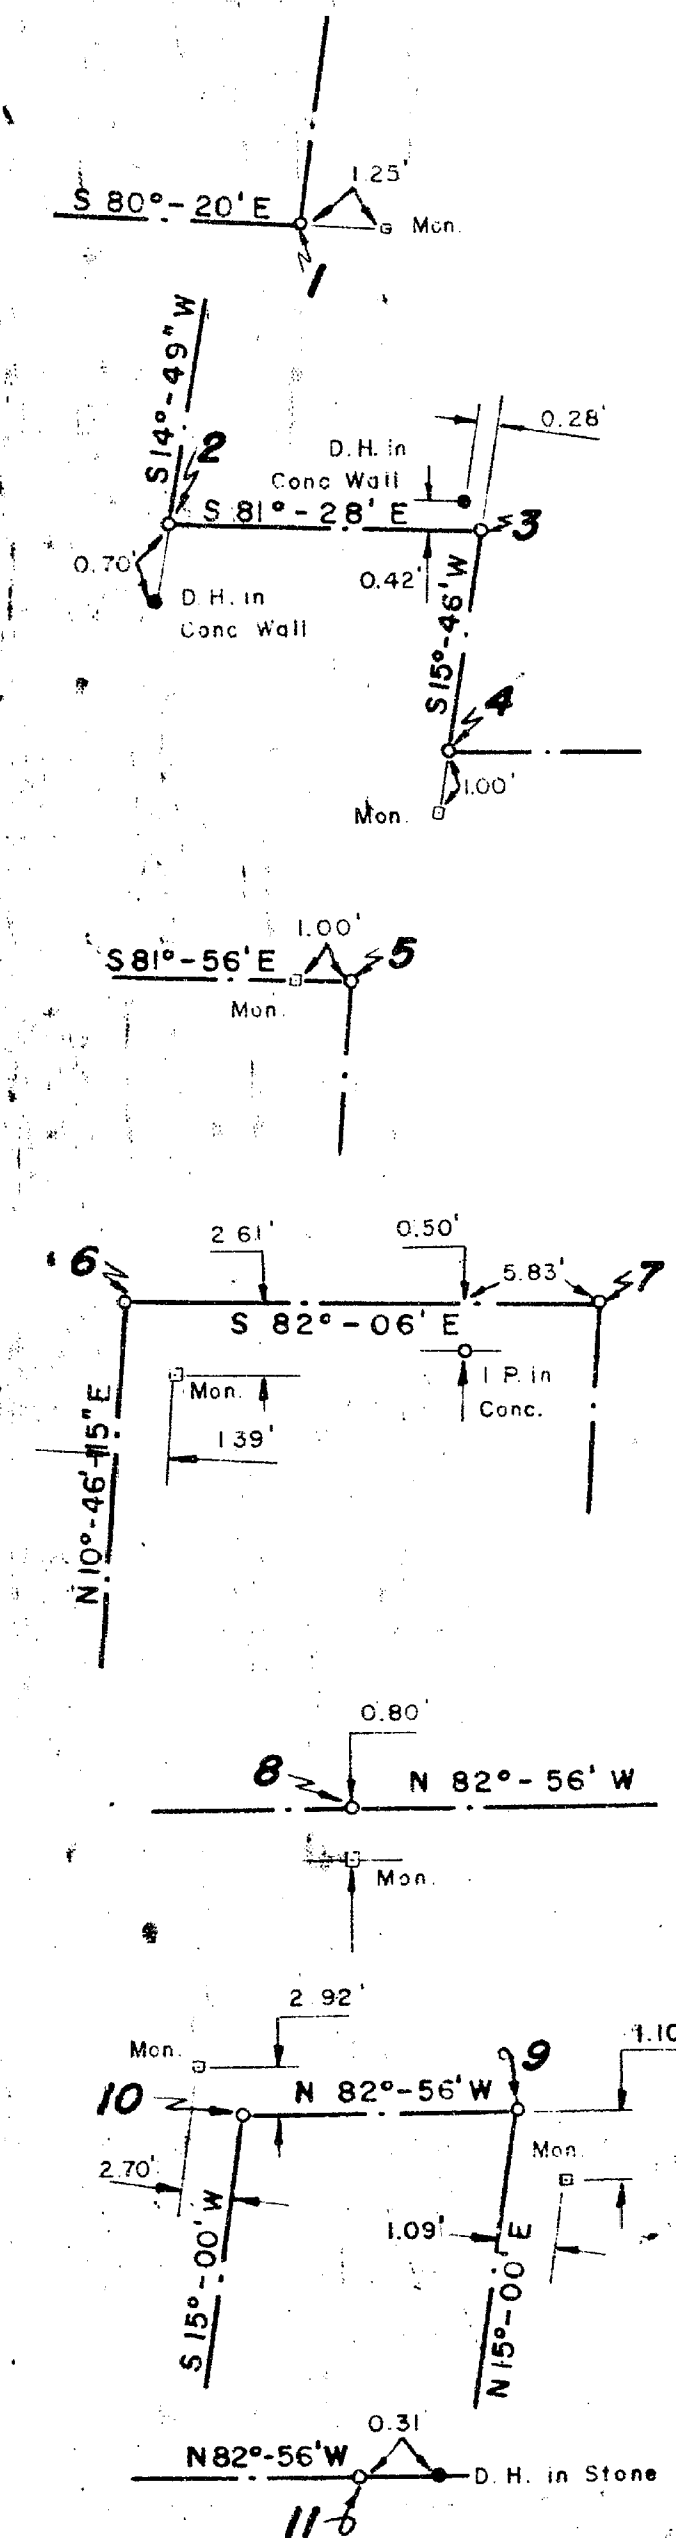

LEGEND

- PROPERTY LINE
- PROP. LINE BETWEEN COLLEGE & FRATERNITIES PROPERTIES
- PROP. CORNER
- Mon. MONUMENT
- D.H. DRILL HOLE
- I.P. IRON PIN
- 2 INSERT NO.
- P.I. POINT OF INTERSECTION OF STREET LINES

TOTAL AREA = 7.262 acr.

For Charles L.