



496

RECEIVED
JUL 21 2 36 PM '60
The portion of Albany Ave. shown on this plan
is an established public street of the City of
Hartford.
Winifred W. Dwyer
City Engineer

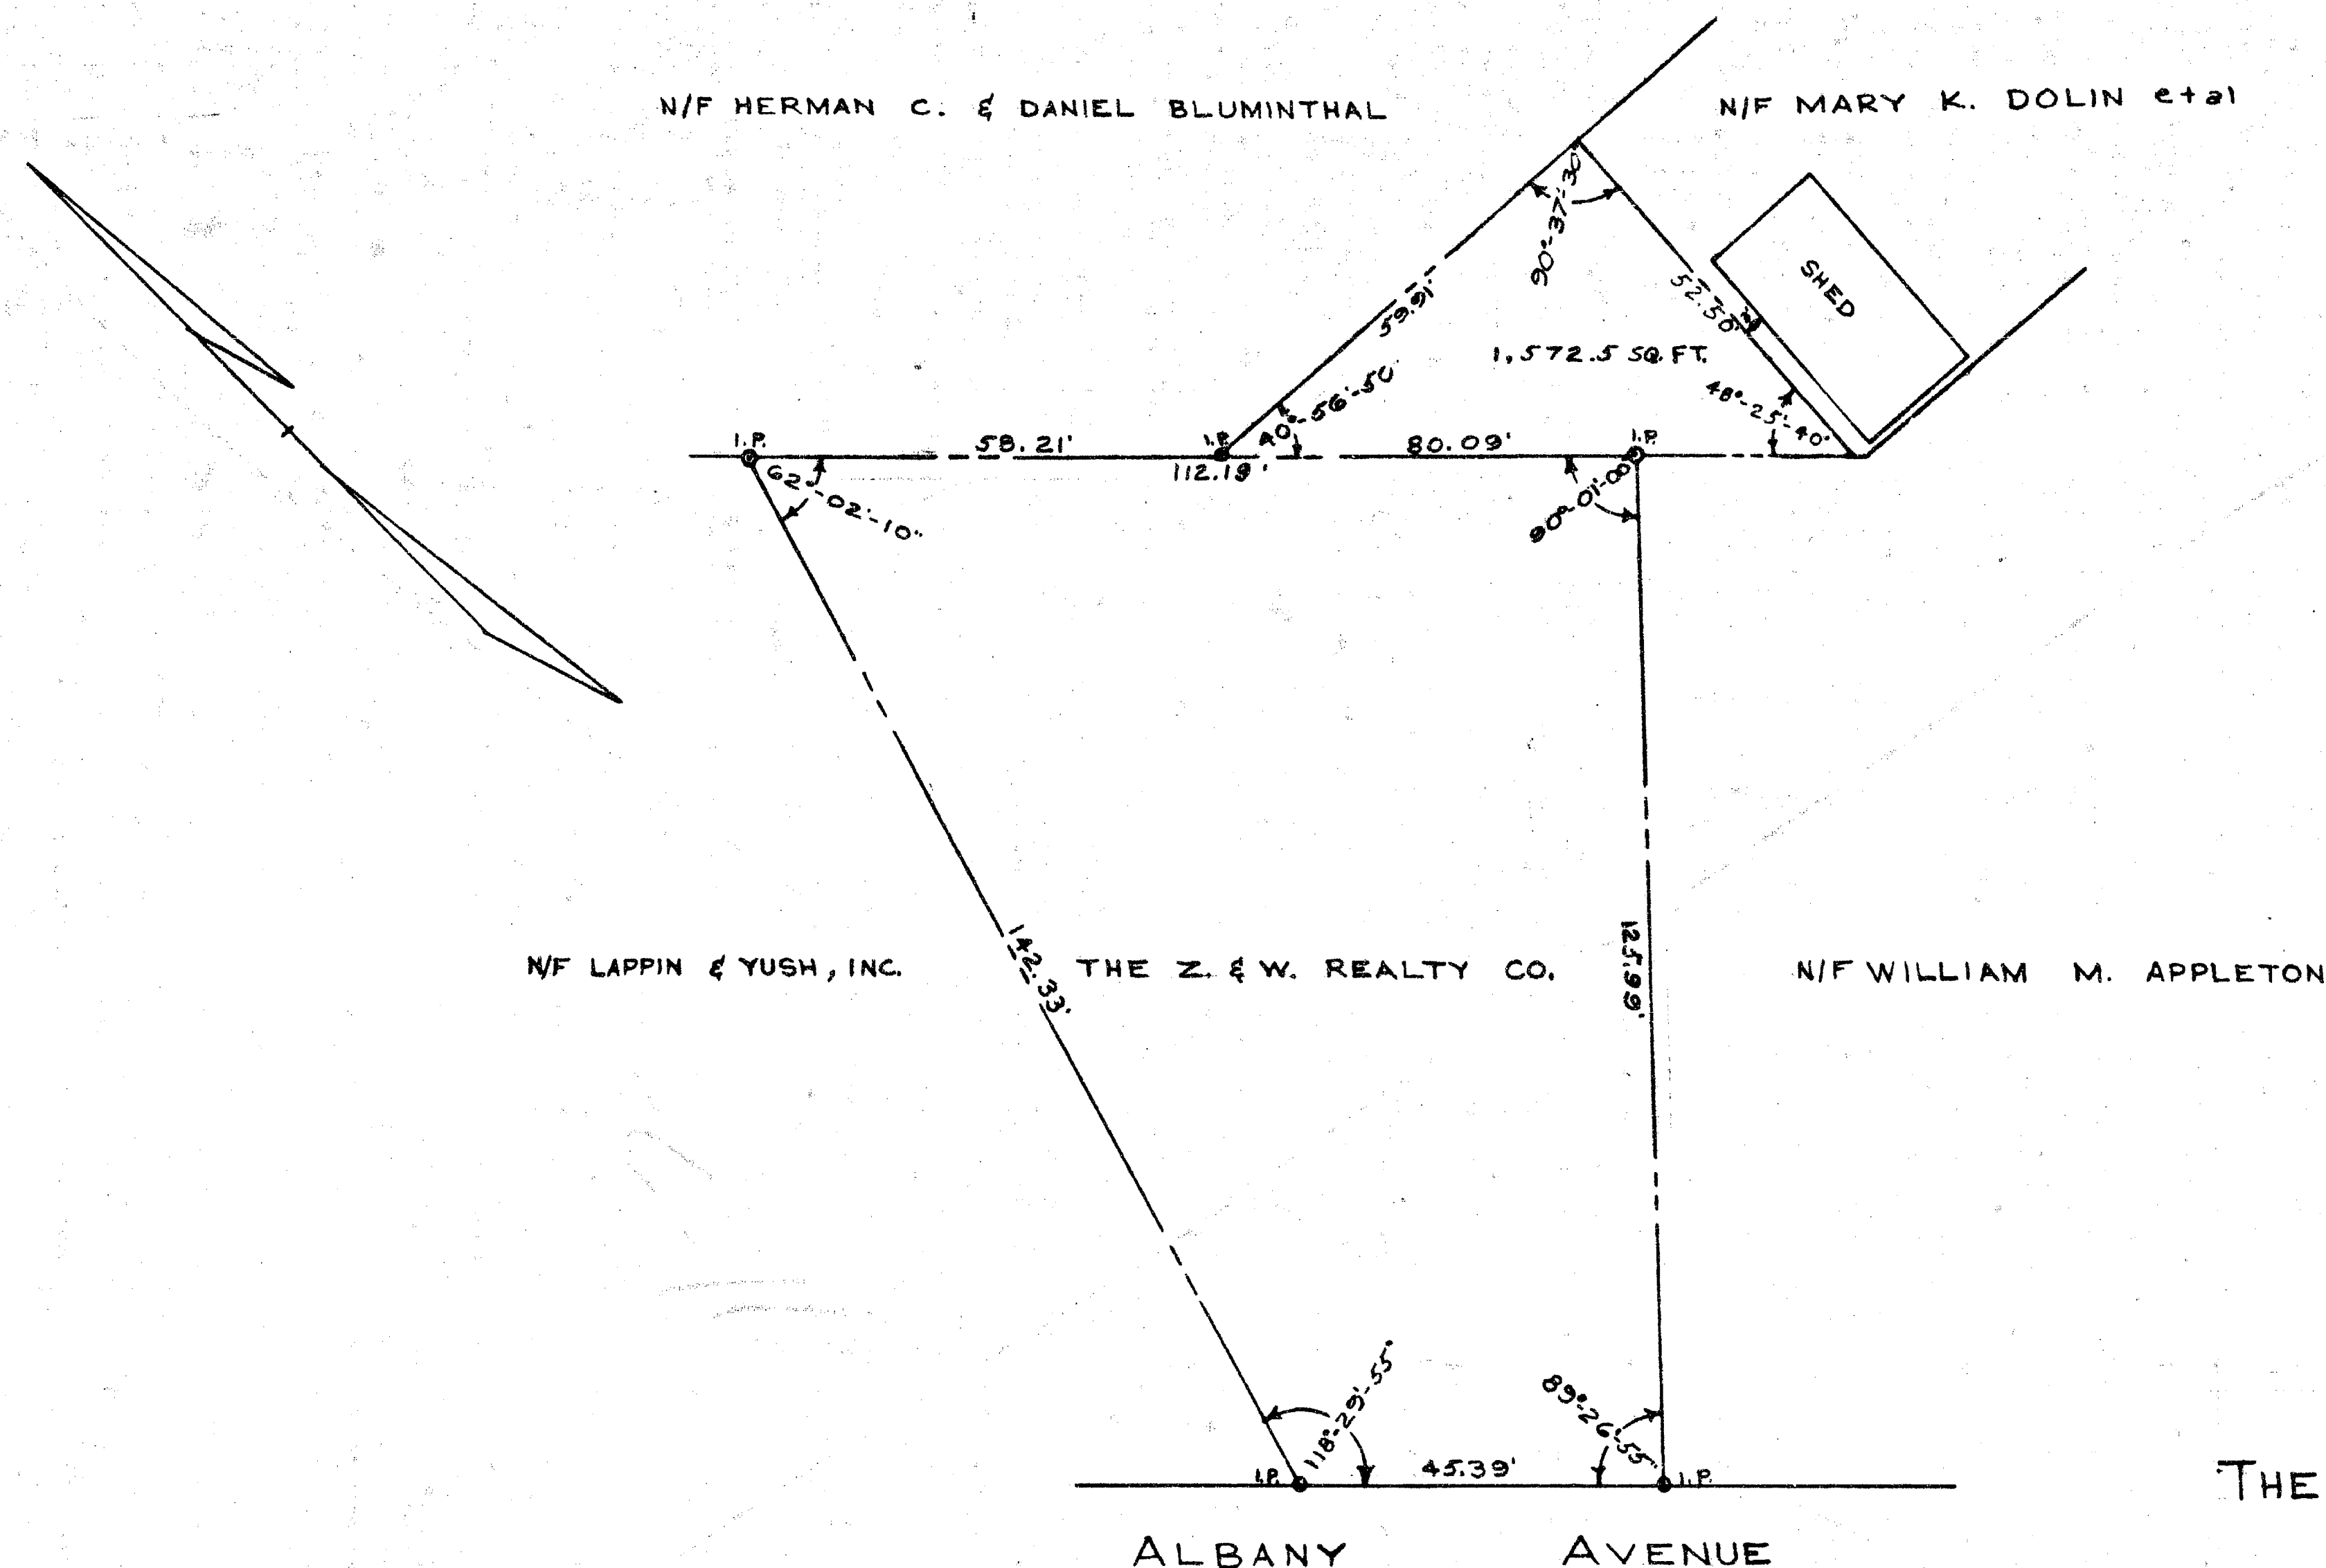

THIS SURVEY IS CERTIFIED SUBSTANTIALLY CORRECT

Harold R. Sanderson

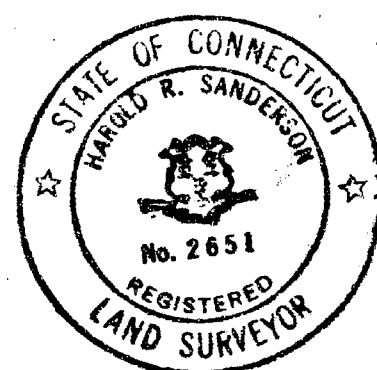

PROPERTY OF
THE Z. & W. REALTY CO.
ALBANY AVENUE
HARTFORD CONNECTICUT
SCALE 1"=20' MAY 1960
SURVEY BY
HAROLD R. SANDERSON C.E. & L.S.
BLOOMFIELD CONNECTICUT



Hfd-13