

497-2

NOTE: THIS SKETCH COMPILED FROM A MAP ENTITLED,
"PROPERTY OF RUTH SOBOL, KNOWN AS 3420 AND REAR
3440 MAIN STREET HARTFORD, CONN. SCALE 1"=50' APRIL
21, 1960" FRED B. WHEELER L.S.

RECEIVED
HARTFORD, CONN.

AUG 23 9 49 AM '60

ROBERT J. GALLIVAN
TOWN & CITY CLERK


The portion of Main St. shown on
this plan is an established public
street of the City of Hartford.

Aug. 23, 1960

Winifred M. Kelly
City Engineer

LEGEND:

- UNDERGROUND DUCT
- MANHOLE LOCATION
- POLE LOCATION
- ANCHOR GUY LOCATION
- CENTER LINE OF RAIL LINE

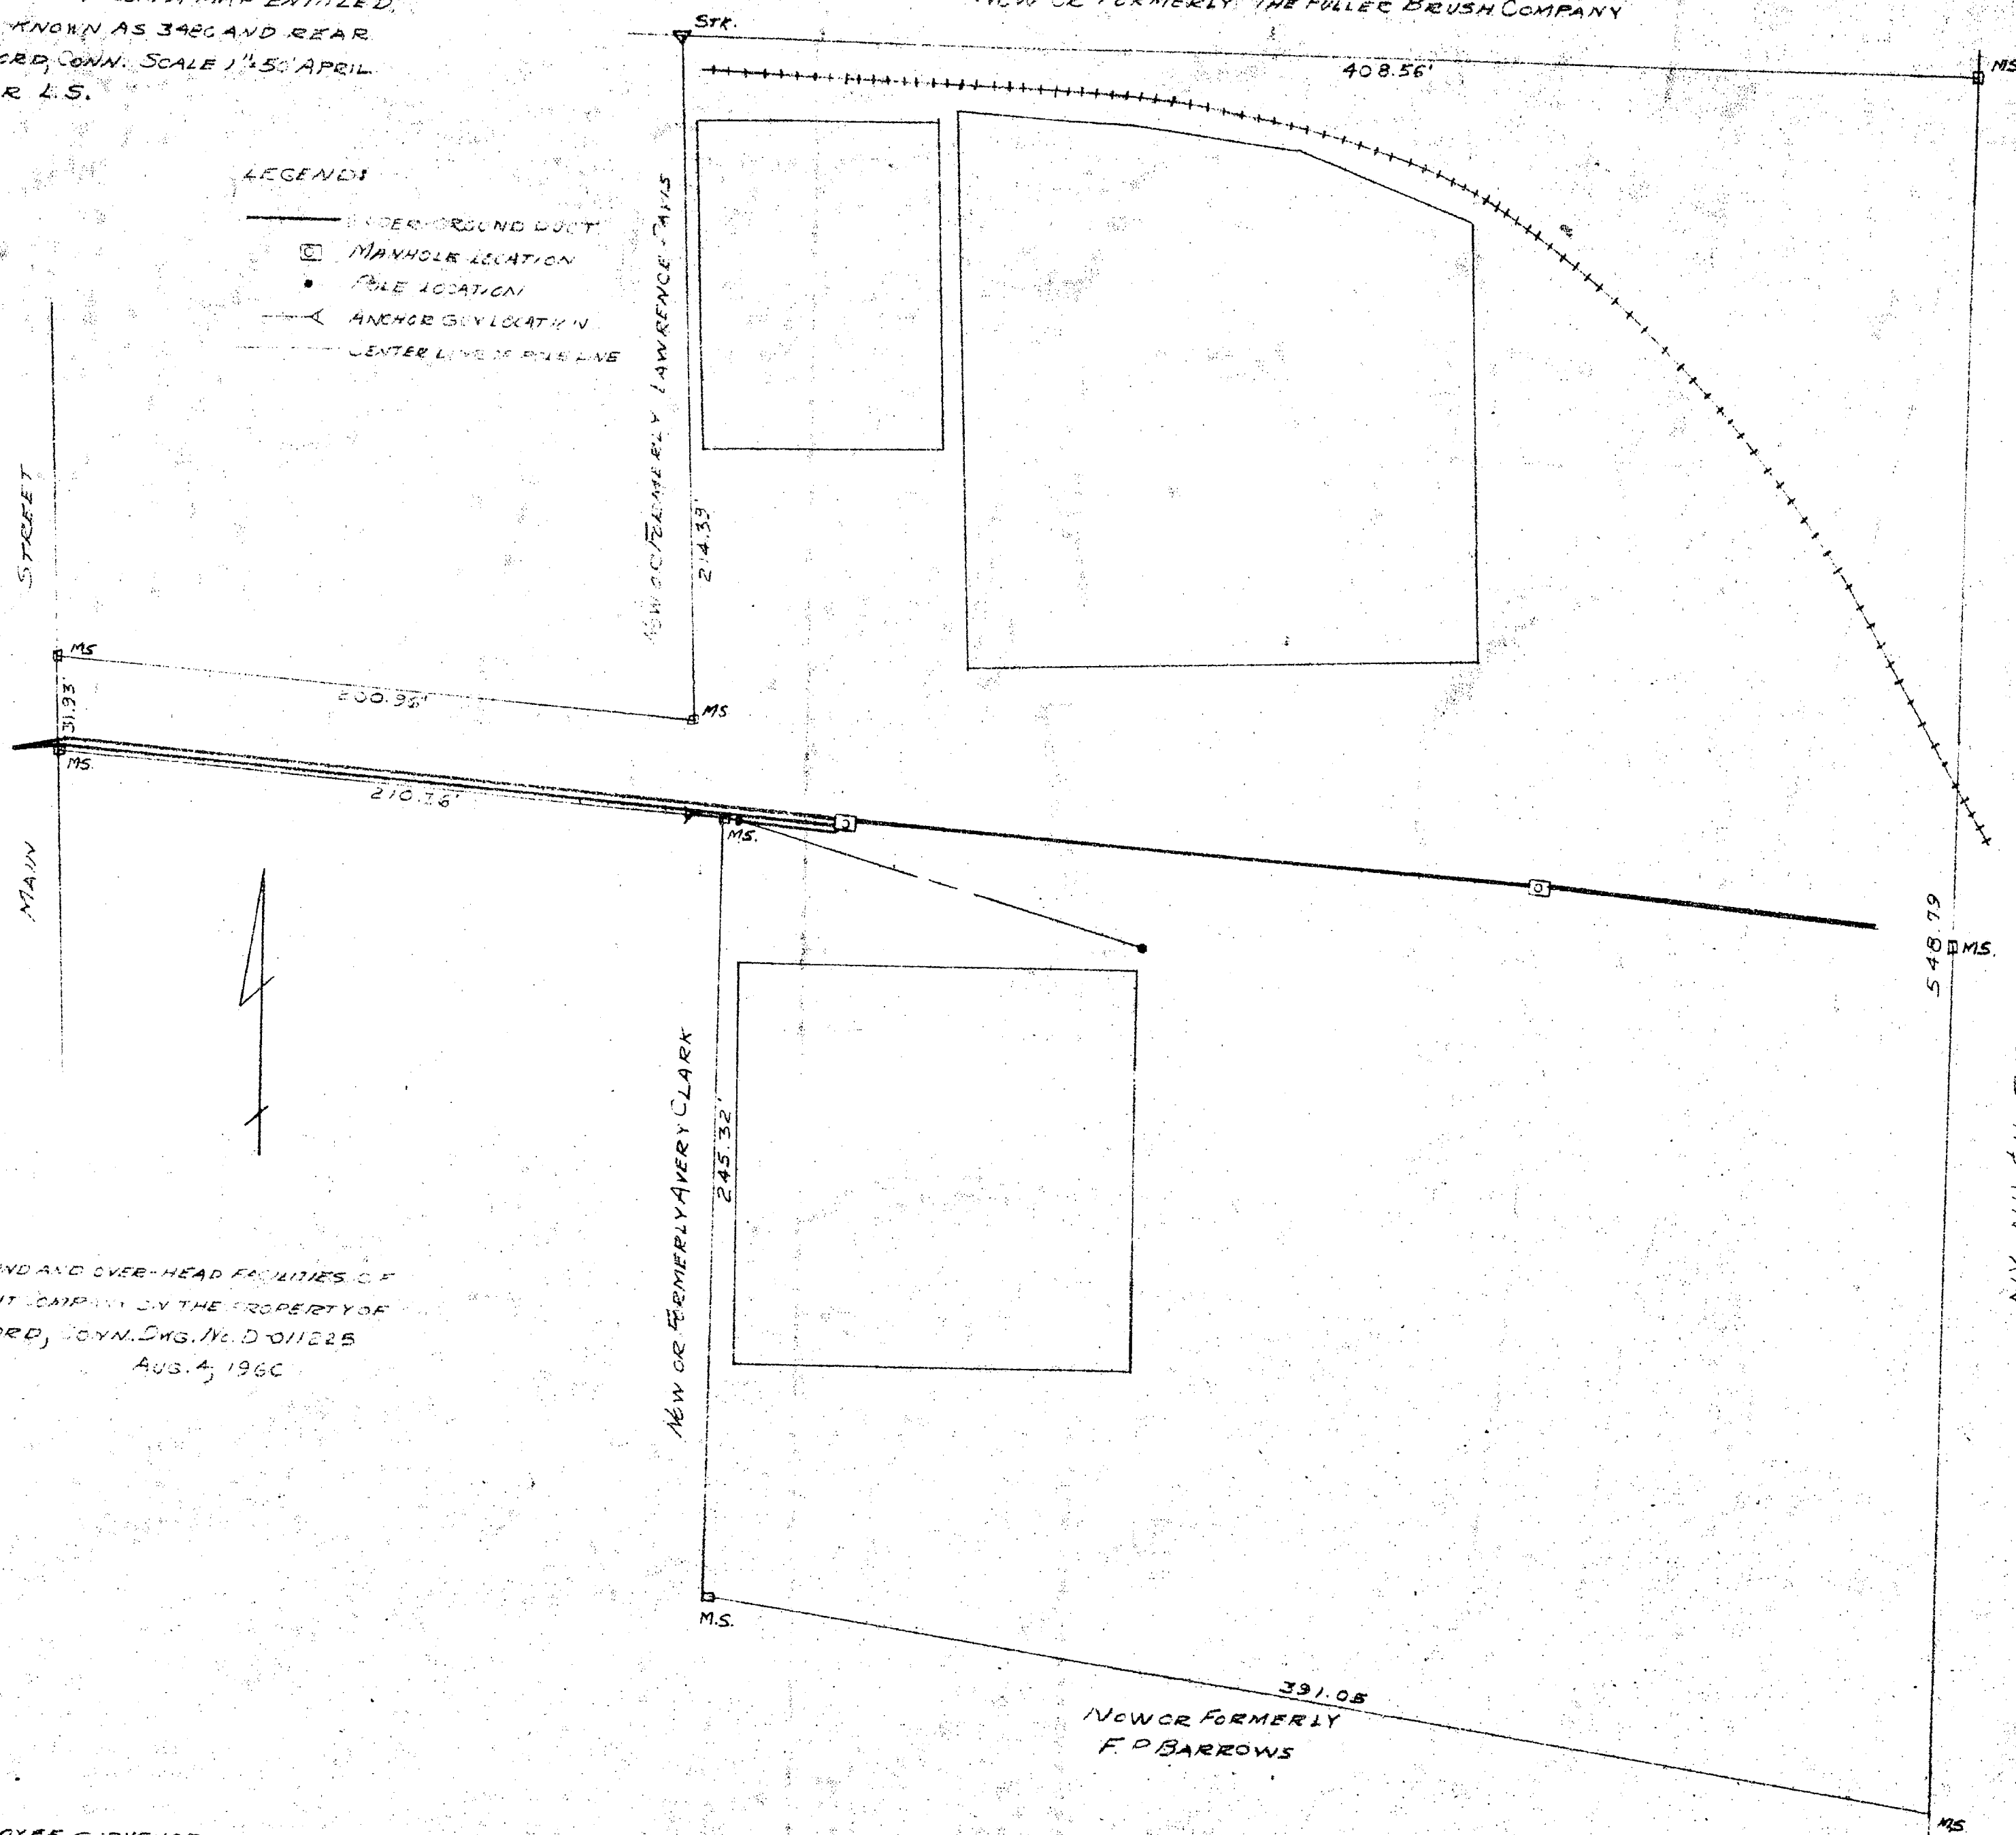

SKETCH SHOWING UNDERGROUND AND OVER-HEAD FACILITIES OF
THE HARTFORD ELECTRIC LIGHT COMPANY ON THE PROPERTY OF
RUTH SOBOL MAIN ST. HARTFORD, CONN. SNG. NO. D 011225
SCALE 1"=50' AUG. 4, 1960

N.Y. M.H. & H. R. 12.

THE UNDER-SIGNED UTILITY EMPLOYEE SURVEYOR
CERTIFIES THIS SKETCH SUBSTANTIALLY CORRECT
DATE, AUG. 5, 1960 SIGNED *James J. Moran*

