


RECEIVED
HARTFORD CONN.
ROBERT J. GALLIVAN
TOWN & CITY CLERK

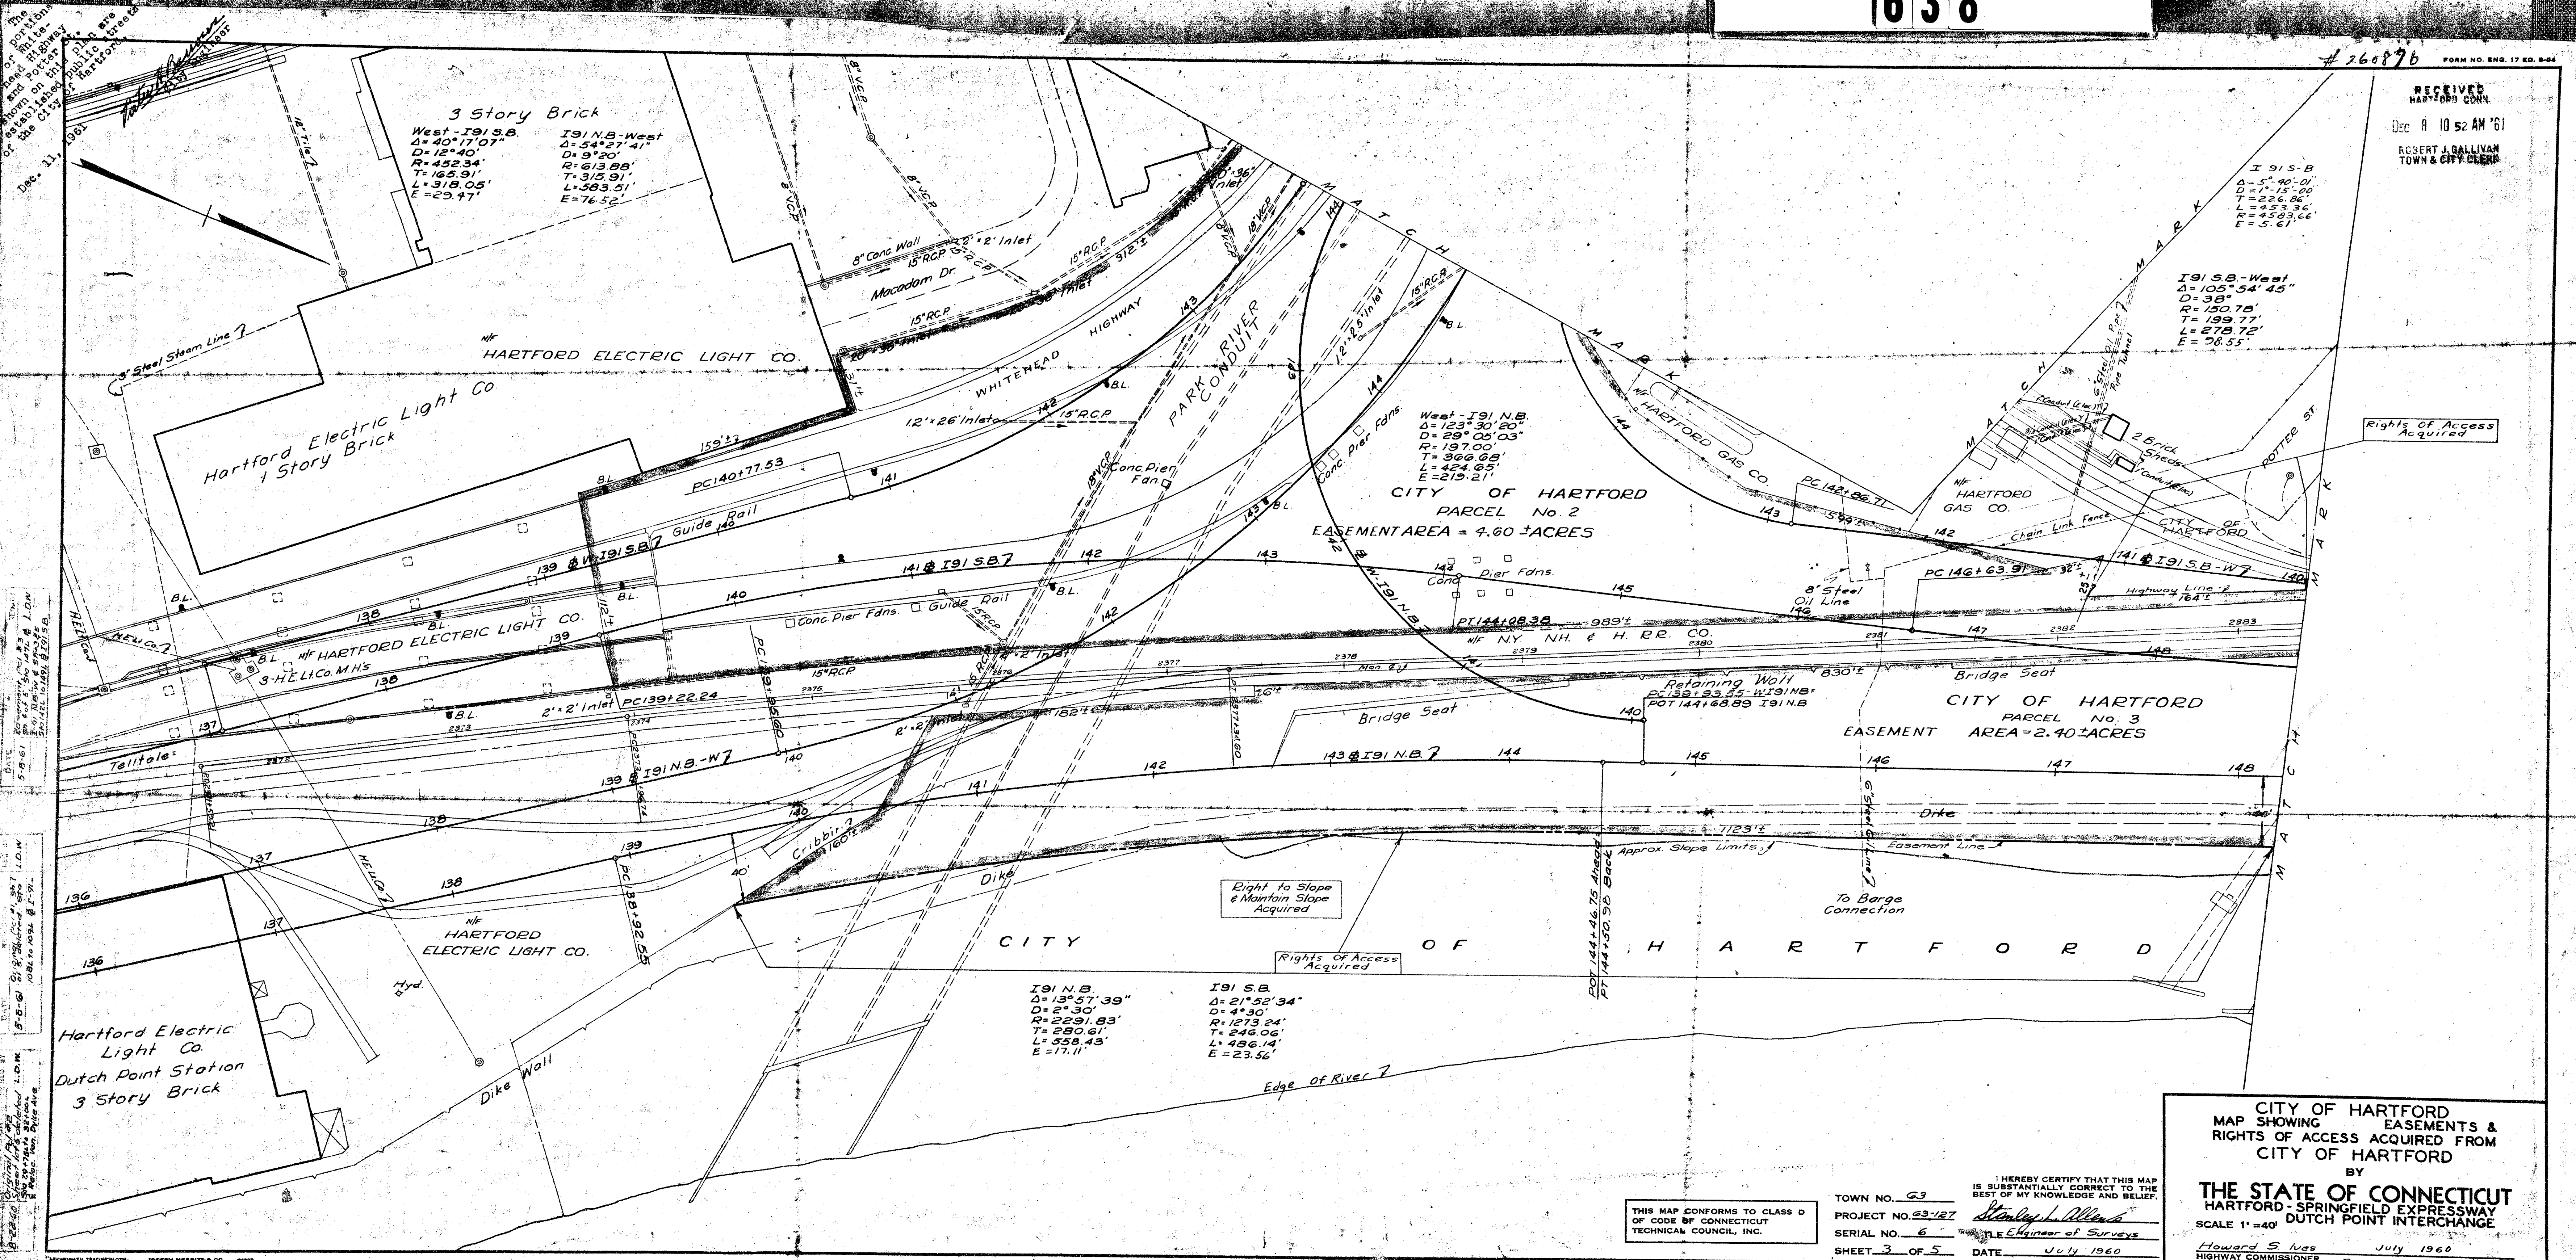

DATE 5-B-61
 8096ment 701 13
 501401 5 50147L 4 L.D.W.
 1-91 NBSW 5 501475
 50142L 10149L 4 1915B

DATE 5-5-61


THIS MAP CONFORMS TO CLASS D
OF CODE OF CONNECTICUT
TECHNICAL COUNCIL, INC.

TOWN NO. 63
PROJECT NO. 63-127
SERIAL NO. 6
SHEET 3 OF 5

I HEREBY CERTIFY THAT THIS MAP
IS SUBSTANTIALLY CORRECT TO THE
BEST OF MY KNOWLEDGE AND BELIEF

Stanley L. Allen
ENGINEER OF SURVEYS

DATE JULY 1960

CITY OF HARTFORD
MAP SHOWING EASEMENTS &
RIGHTS OF ACCESS ACQUIRED FROM
CITY OF HARTFORD
BY
THE STATE OF CONNECTICUT
HARTFORD - SPRINGFIELD EXPRESSWAY
DUTCH POINT INTERCHANGE
SCALE 1" = 40'

Howard S. Nes July 1960
HIGHWAY COMMISSIONER Rev. REVISED OCT. 1966

0 INCHES 1 2 3 4