


640

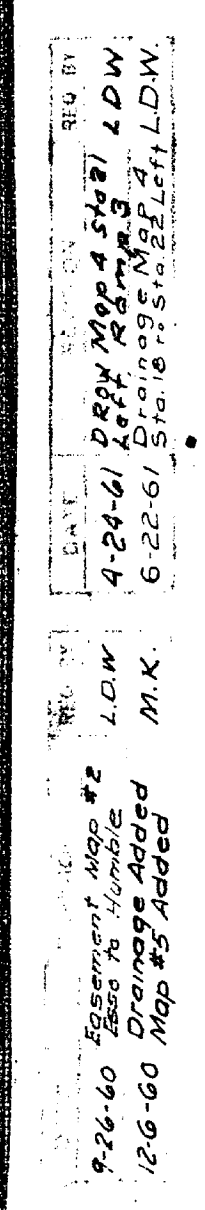

640