


705-2

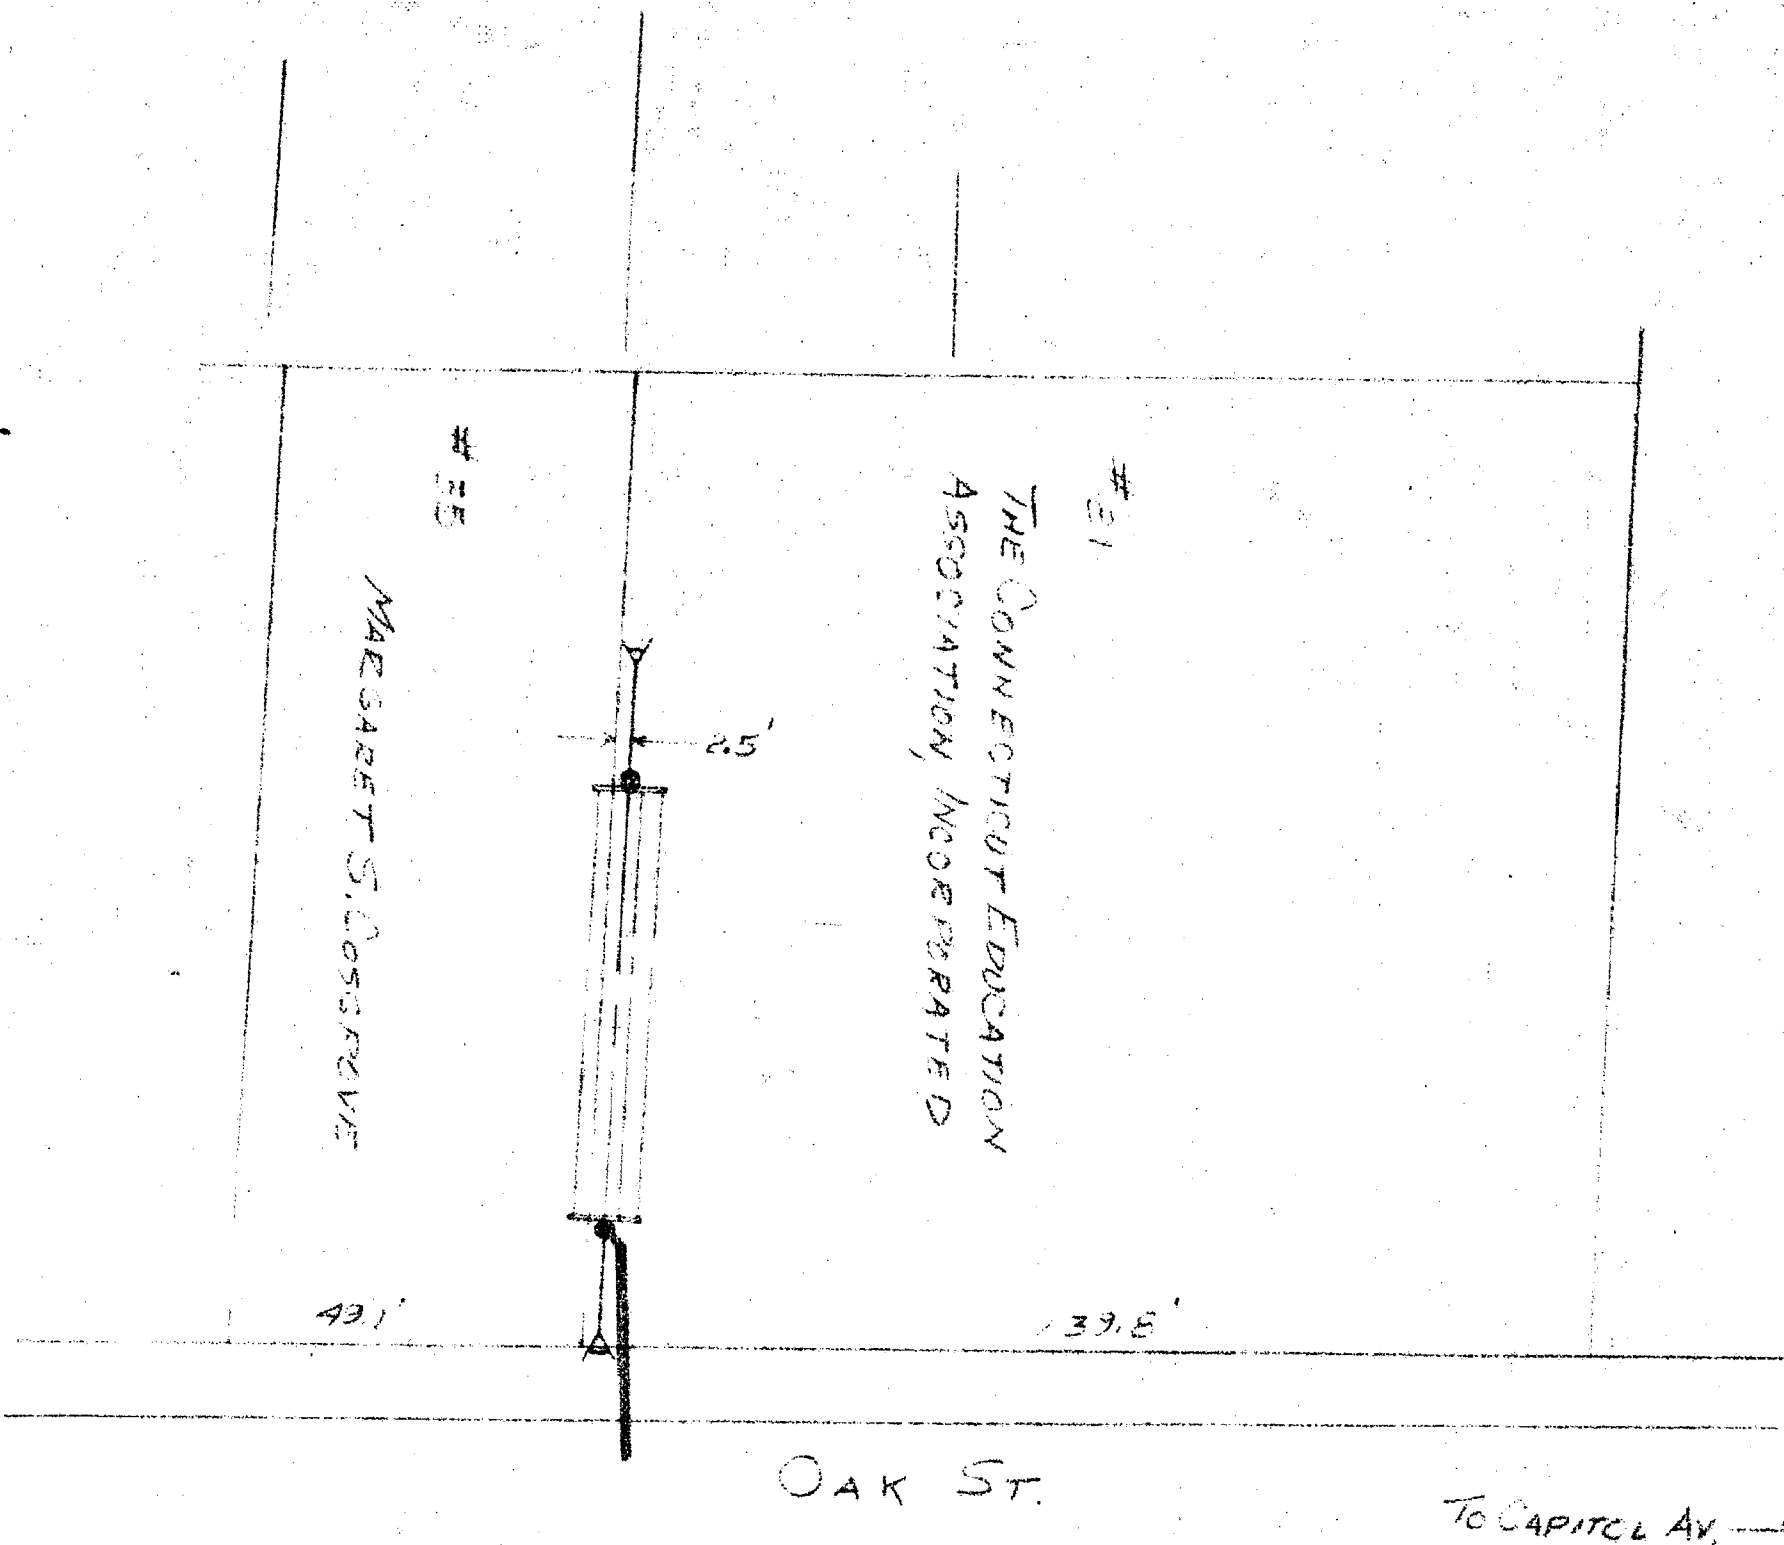

SKETCH SHOWING WIRE CROSSING BY THE HARTFORD ELECTRIC
LIGHT COMPANY OVER THE PROPERTY OF MARGARET S. GOSGRAVE
#35 OAK ST. HARTFORD, CONN. SCALE 1"=40' FEB. 26, 1963 FILE NO. D-011230

THE UNDERSIGNED UTILITY EMPLOYEE
CERTIFIES THIS MAP TO BE
"SUBSTANTIALLY CORRECT" AND IN
ACCORDANCE WITH CLASS D OF CODE
OF COMM. TECHNICAL COUNCIL, INC.
THE HARTFORD ELECTRIC LIGHT COMPANY
PER A.R. Tolerman

The portion of Oak Street shown on
this plan is an established public
street of the City of Hartford.

Arthur W. Bascove
City Engineer

March 12, 1963

