


Robert H. B.
City Engineer

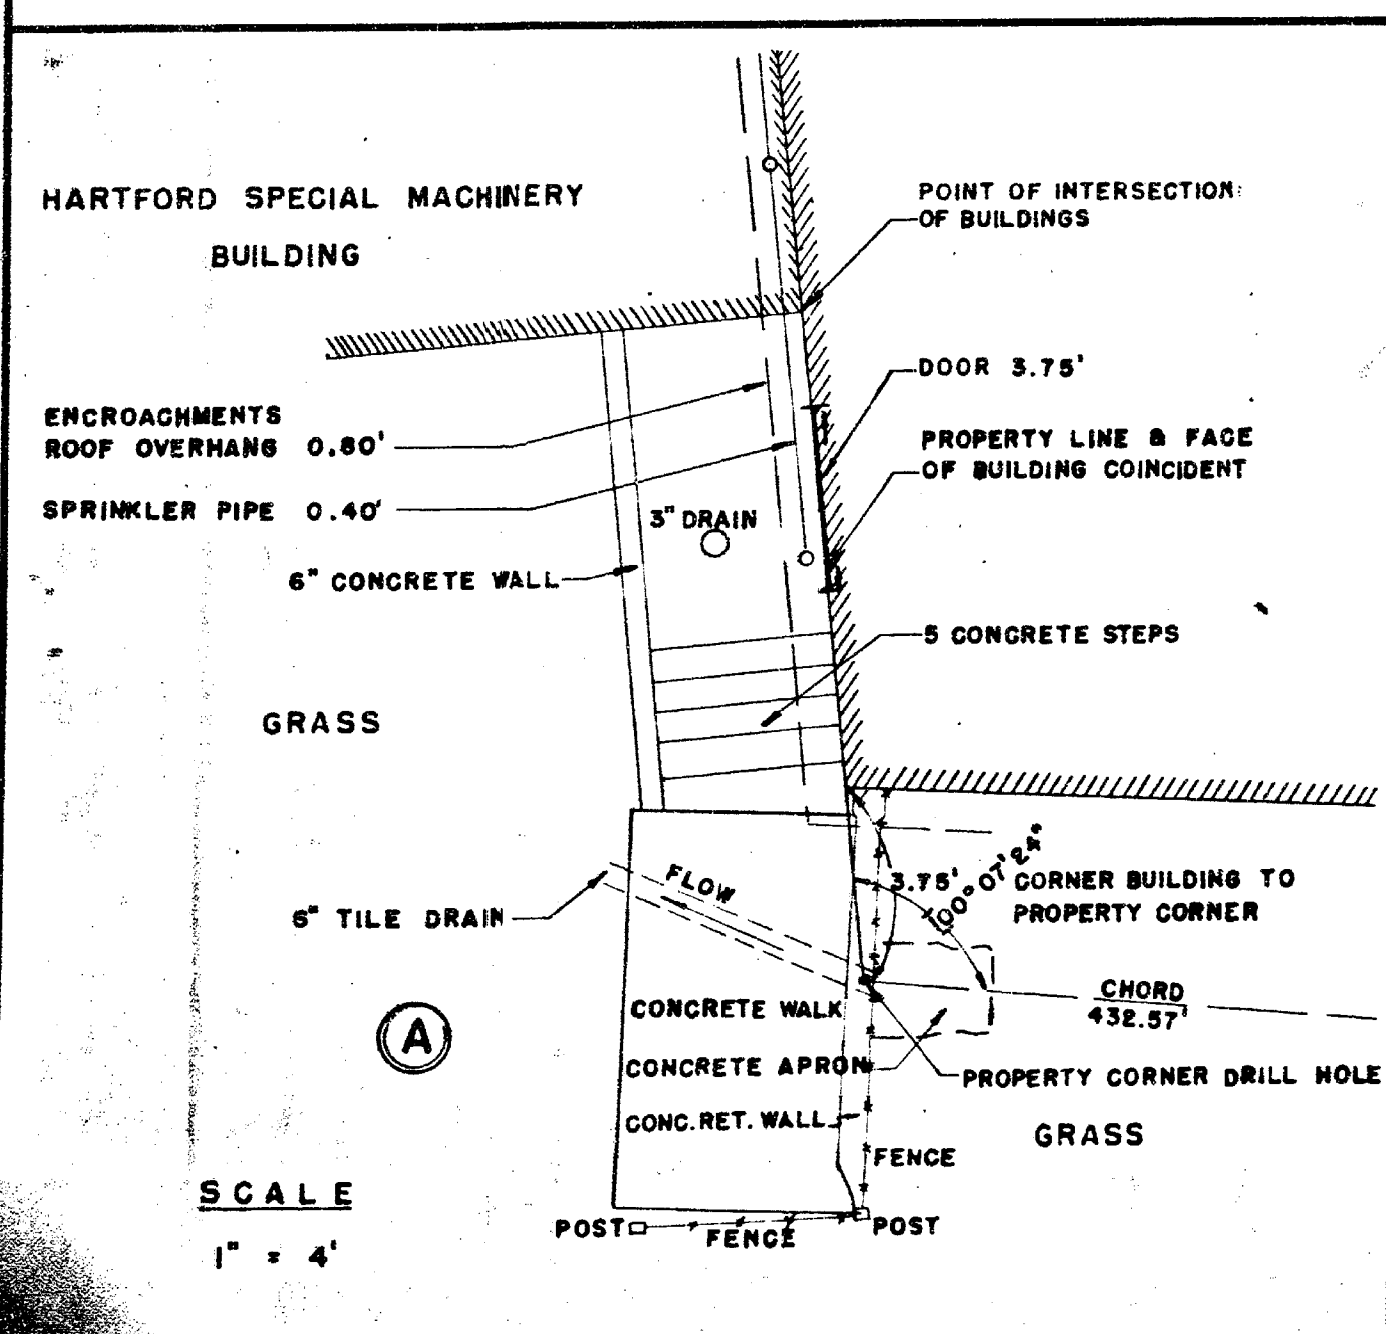

AUGUST, 1962

I HEREBY CERTIFY THAT THIS MAP IS SUBSTANTIALLY CORRECT.

Edward J. Tottman

