


717-1

RECEIVED
HARTFORD, CONN.

AUG 28 10 58 AM '63

ROBERT J. GALLIVAN
TOWN & CITY CLERK

WETHERSFIELD

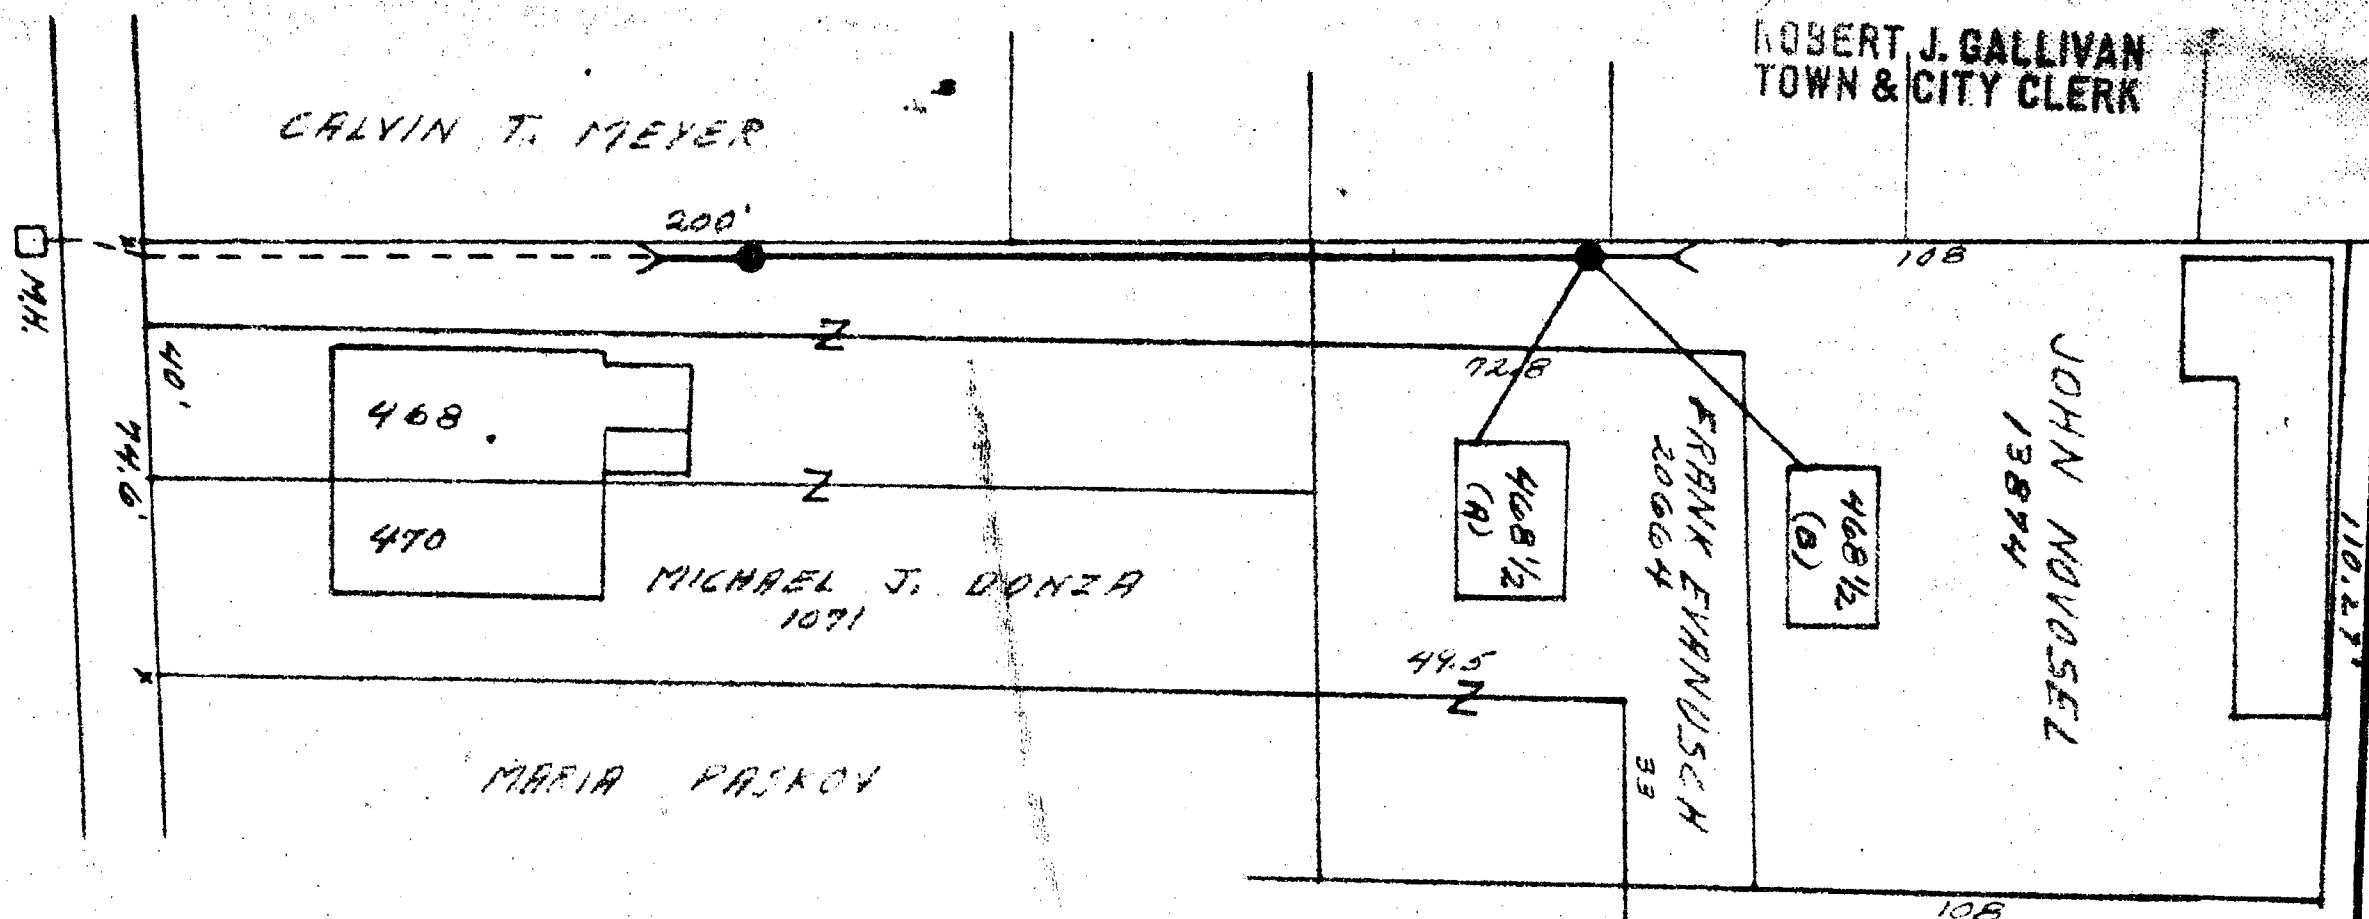

The portion of Wethersfield Ave. shown on this plan is an established public street of the City of Hartford.

Sept. 4, 1963 *Robert J. Gallivan*
City Engineer

THE HARTFORD ELECTRIC LIGHT CO.
ELECTRIC OPERATIONS DEPARTMENT
DRAWN BY *JLK* CHECKED BY *JLK* APPROVED BY *JLK*
SCALE 1"=50'
DATE August 20, 1963 NO. D-011815

LEGEND
● Pole
— Anchor Guy
— Overhead Facilities
--- Underground Facilities

