

720


The portions of Nelson St. and Garden St. shown on this plan are established public streets of the City of Hartford.

Sept. 4, 1963 *Porter H. Bannister*
HELCO POLE City Engineer
— HELCO ANCHOR

RECEIVED
HARTFORD, CONN.

AUG 28 10 58 AM '63

ROBERT J. GALLIVAN
TOWN & CITY CLERK

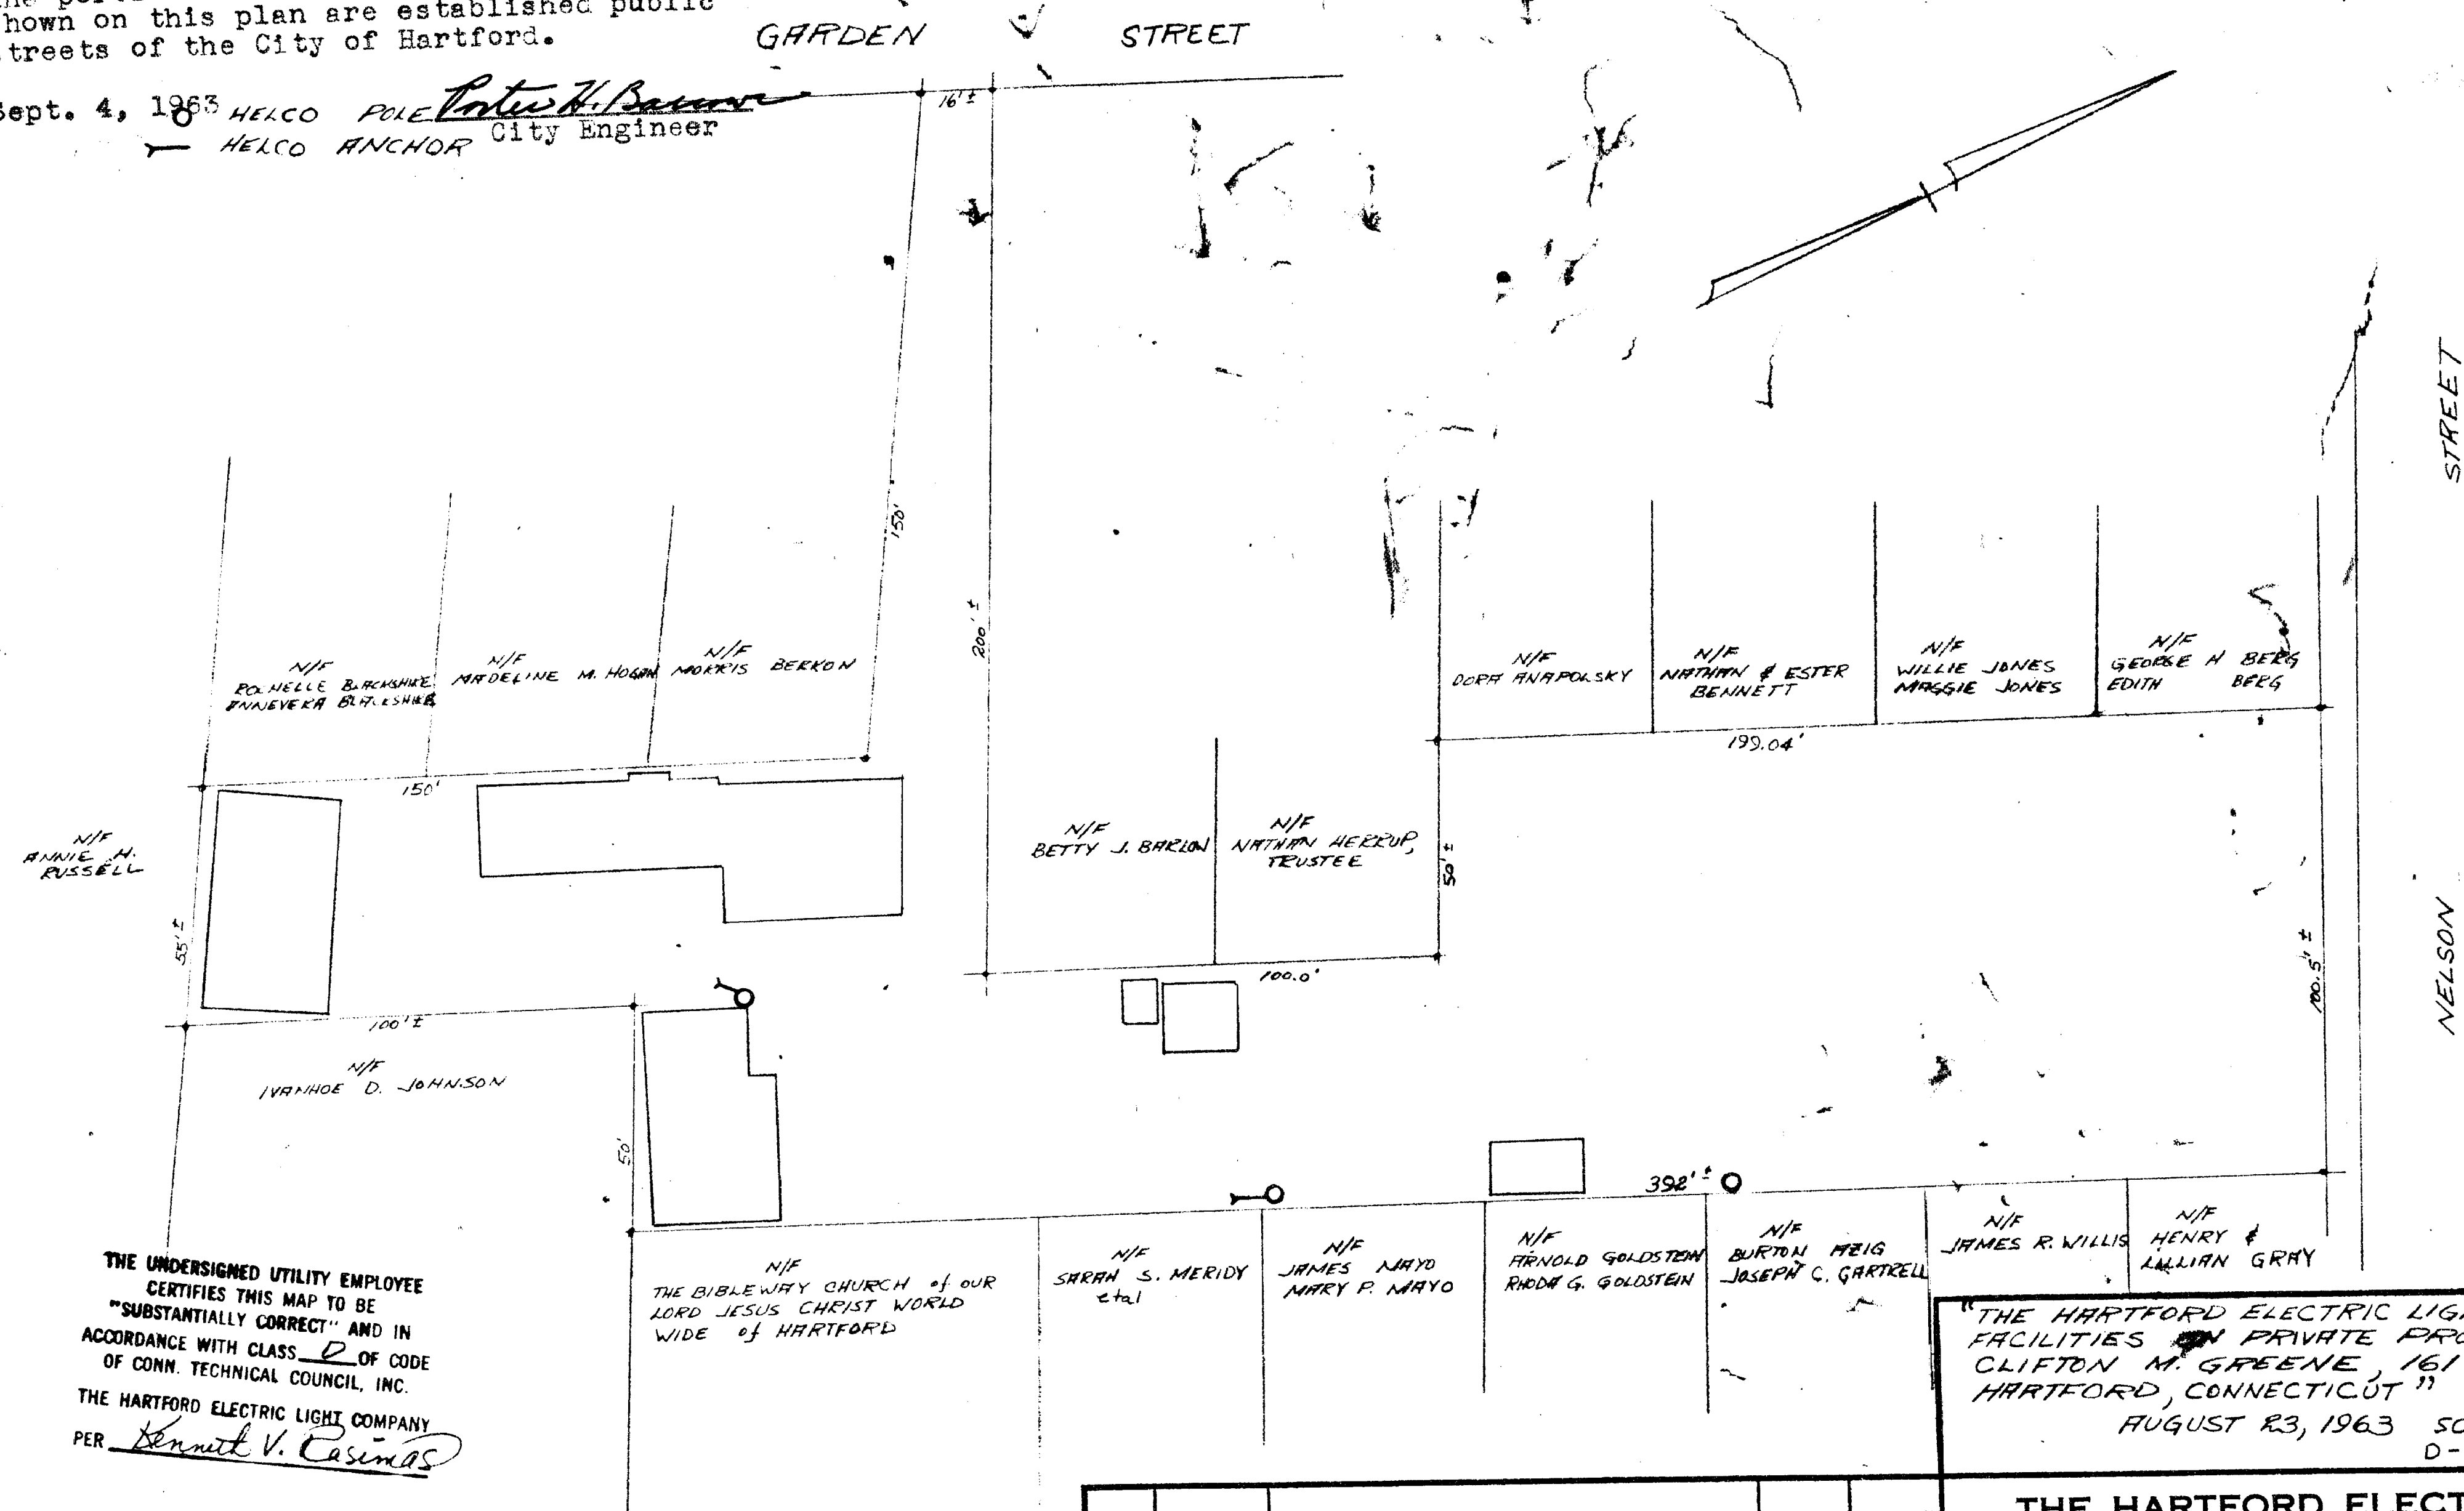

THE UNDERSIGNED UTILITY EMPLOYEE
CERTIFIES THIS MAP TO BE
"SUBSTANTIALLY CORRECT" AND IN
ACCORDANCE WITH CLASS D OF CODE
OF CONN. TECHNICAL COUNCIL, INC.
THE HARTFORD ELECTRIC LIGHT COMPANY
PER *Kenneth V. Casimiro*

"THE HARTFORD ELECTRIC LIGHT COMPANY
FACILITIES ON PRIVATE PROPERTY OF
CLIFTON M. GREENE, 161 NELSON STREET,
HARTFORD, CONNECTICUT"
AUGUST 23, 1963 SCALE 1"=40'
D-011816

NO.	DATE	DESCRIPTION	BY	APP. BY

THE HARTFORD ELECTRIC LIGHT CO.
ELECTRIC OPERATIONS DEPARTMENT

DRAWN BY _____ CHECKED BY _____ APPROVED BY _____
SCALE _____
DATE _____ NO. _____

