

764-2

Dis No 289805


RECEIVED
HARTFORD, CONN.

FEB 24 2 16 PM '65

ROBERT J. GALLIVAN
TOWN & CITY CLERK

THE UNDERSIGNED UTILITY EMPLOYEE
CERTIFIES THIS MAP TO BE
"SUBSTANTIALLY CORRECT" AND IN
ACCORDANCE WITH CLASS D OF CODE
OF CONN. TECHNICAL COUNCIL, INC.

THE HARTFORD ELECTRIC LIGHT COMPANY
PER Franklin D. Smith

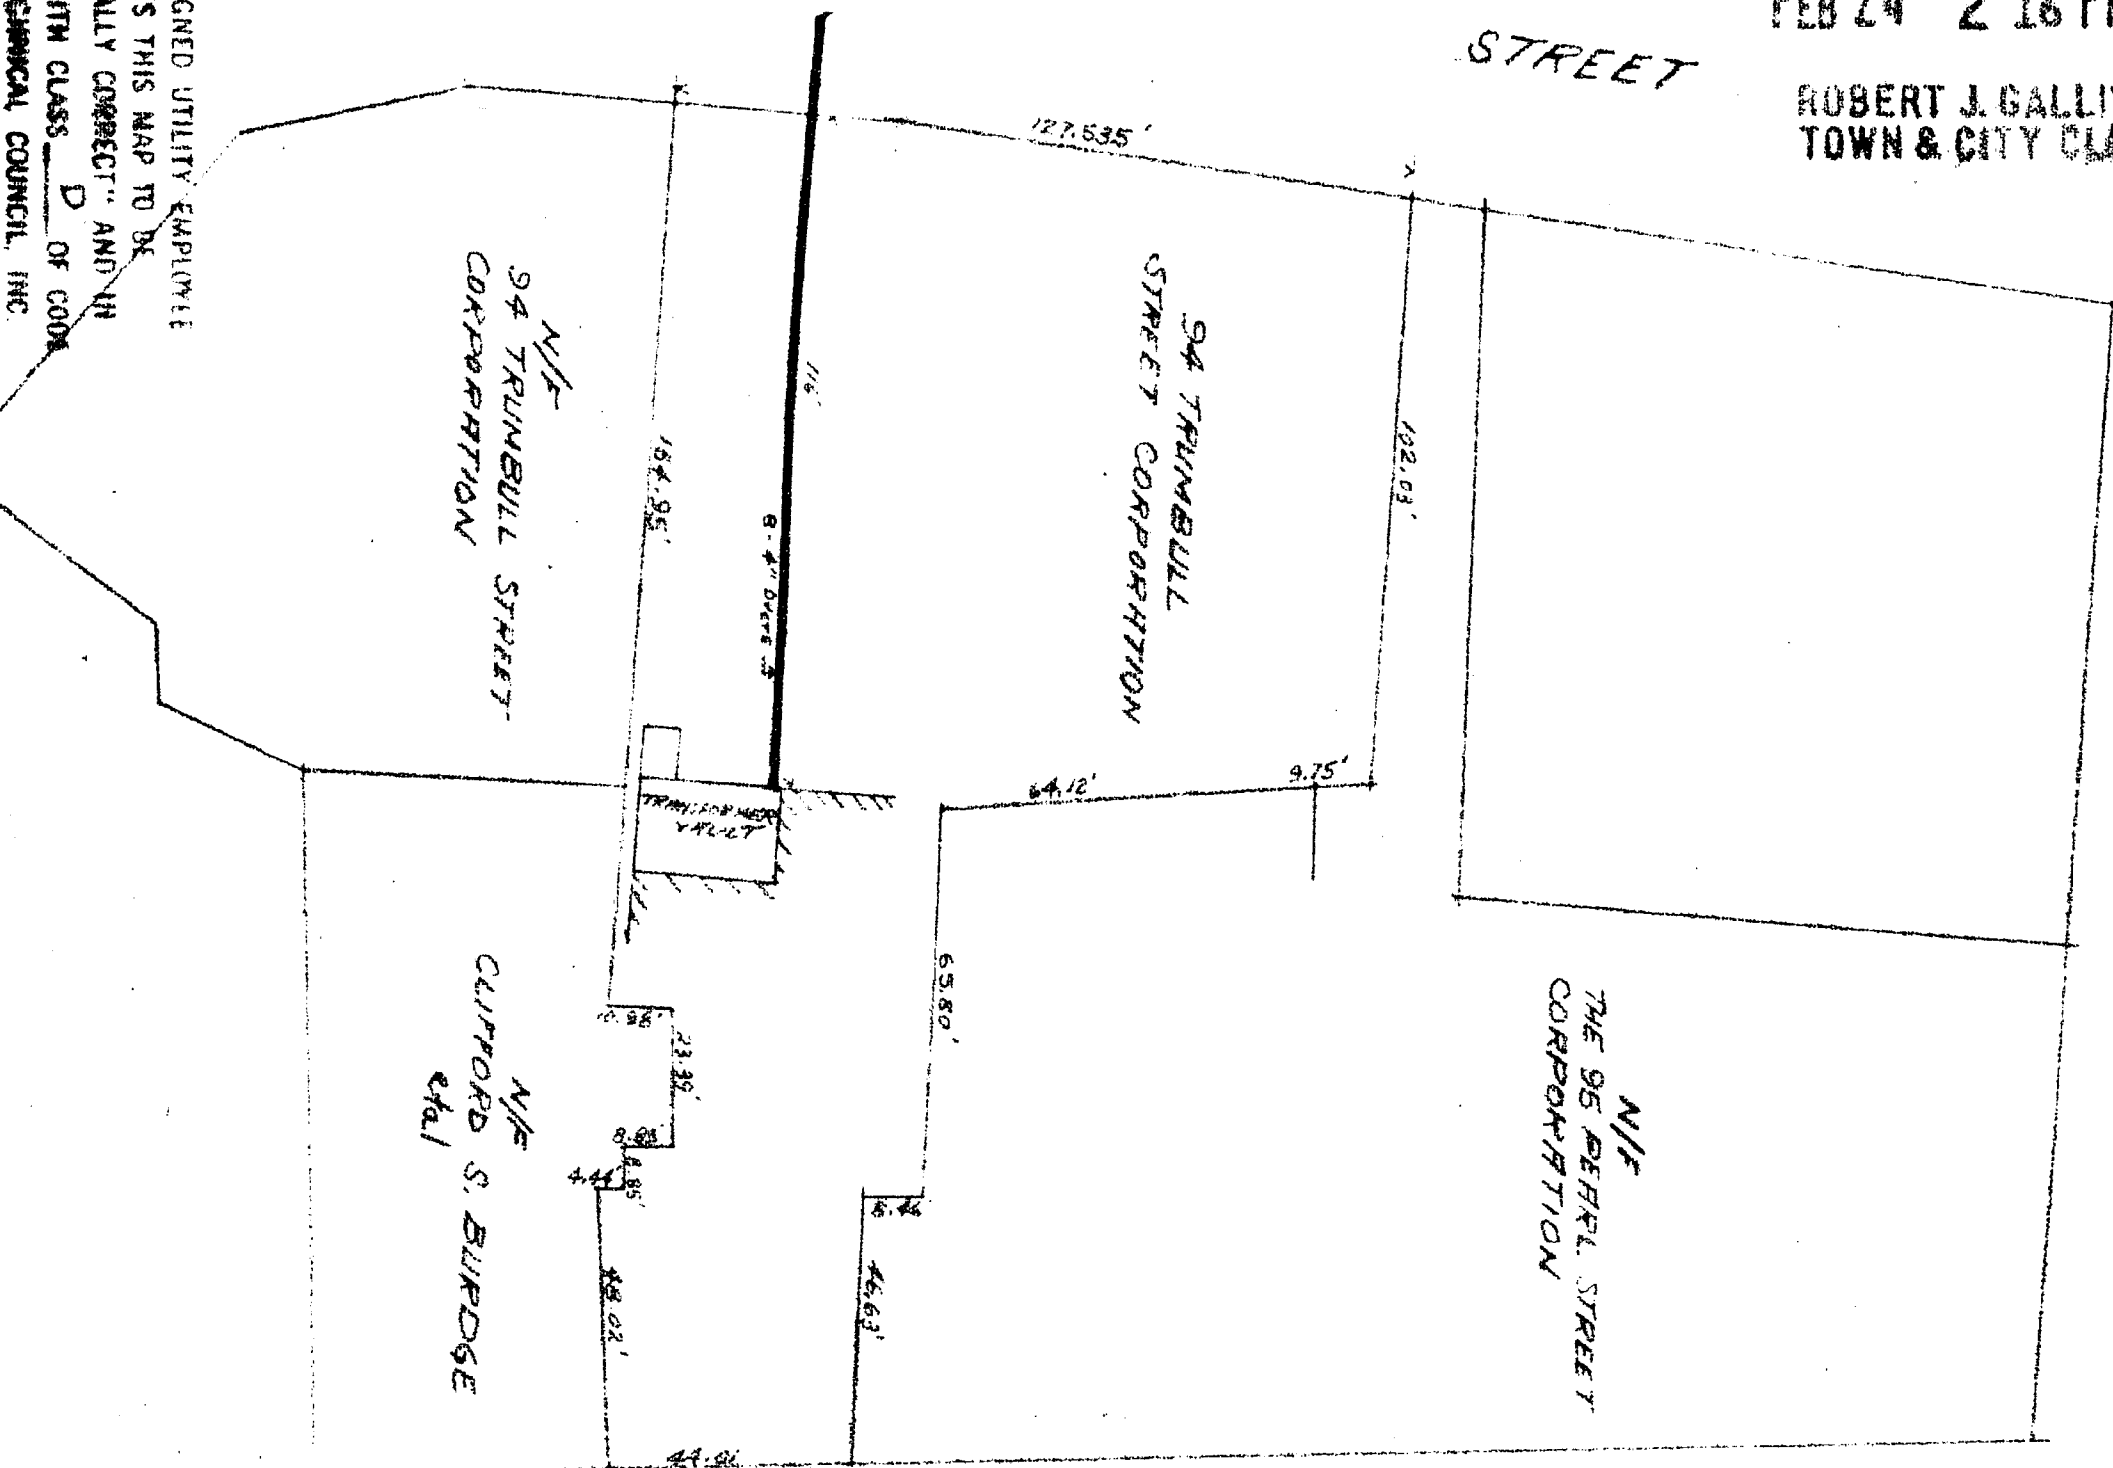

The portions of Trumbull Street, Pearl Street and
Lewis Street shown on this plan are established public
streets of the City of Hartford.

Feb. 25, 1965

City Engineer

LEWIS STREET

STREET

STREET

PEARL

N/E
THE 96 PEARL STREET
CORPORATION

N/E
94 TRUMBULL
STREET CORPORATION

N/E
94 TRUMBULL STREET
CORPORATION

N/E
CLIFFORD S. BURDGE
et al

TRANSFORMER
VAULT

NO.	DATE	DESCRIPTION	BY	APP. BY

REVISIONS

THE HARTFORD ELECTRIC LIGHT CO.

ELECTRIC OPERATIONS DEPARTMENT

DRAWN BY K. M. W. CHECKED BY g. g.

SCALE

DATE

NO. D-01259

APPROVED BY g. g.