


CITY OF HARTFORD
RECEIVED
SEP 9 1964 10:14 A.M.
Robert J. Ballin
TOWN & CITY PLANNING

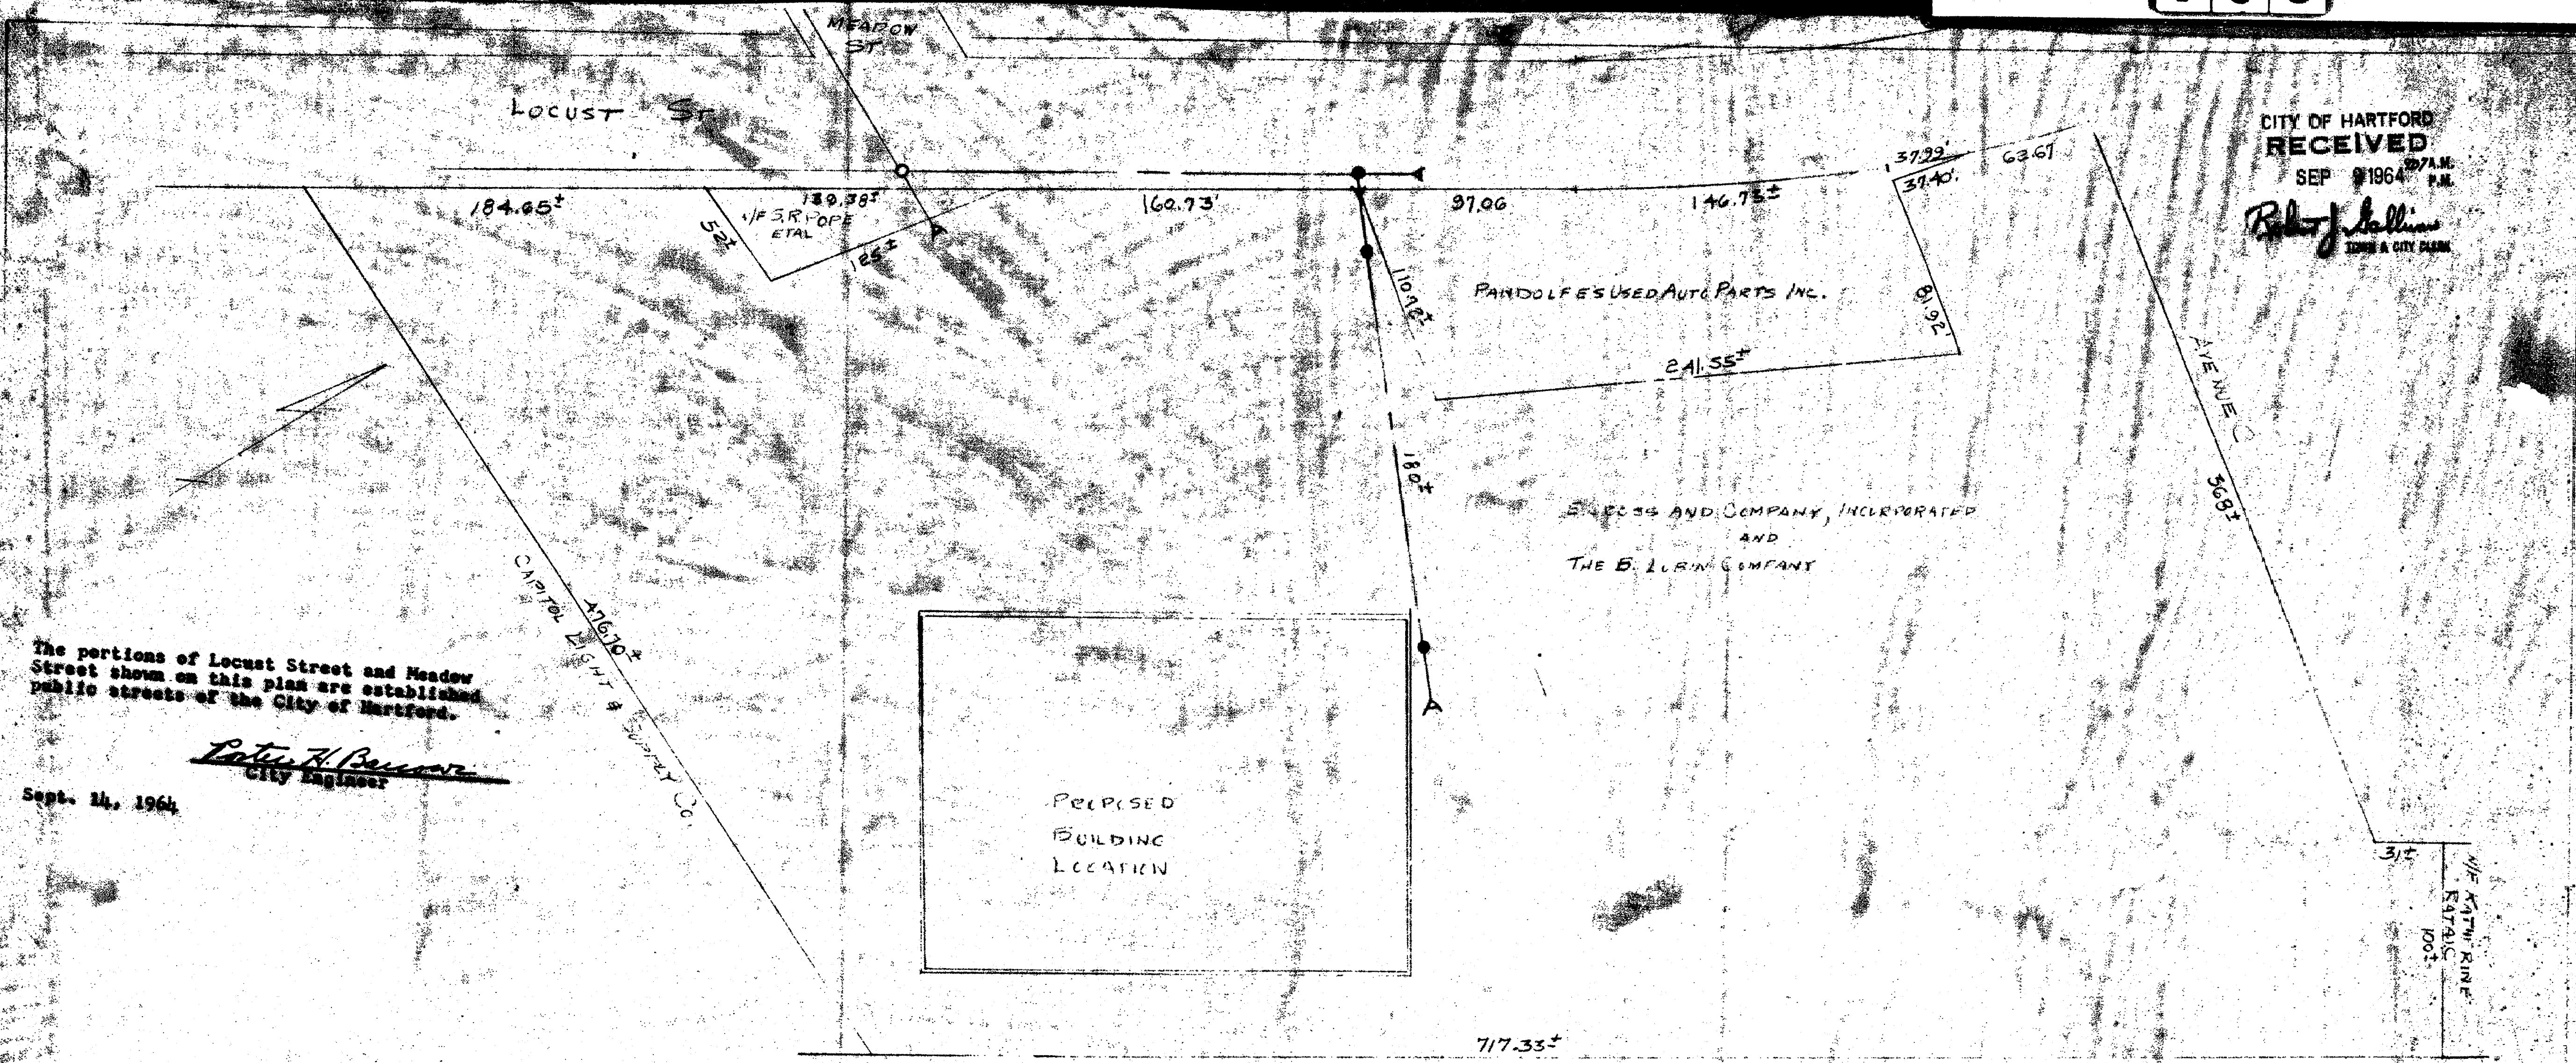

The portions of Locust Street and Meadow Street shown on this plan are established public streets of the City of Hartford.

Robert H. Benson
City Engineer

Sept. 14, 1964

THE UNDERSIGNED UTILITY EMPLOYEE
CERTIFIES THIS MAP TO BE
"SUBSTANTIALLY CORRECT" AND IN
ACCORDANCE WITH CLASS _____ OF CODE
OF CONN. TECHNICAL COUNCIL, INC.
THE HARTFORD ELECTRIC LIGHT COMPANY
per *A.R. Tolson*

SKETCH SHOWING POLE LINE FACILITIES OF THE HARTFORD ELECTRIC LIGHT CO.
ON THE PROPERTY OF E. GROSS AND CO. INC., THE B. LUBIN CO. AND ONE 1/2
PROPERTY OF PANDOLFE'S USED AUTO PARTS INC. OFF LOCUST ST. HARTFORD, CONN.
SCALE 1"=50' AUG 31, 1964 FILE NO. D-01255

THE HARTFORD ELECTRIC LIGHT CO.

LEGEND:

- EXISTING POLES
- PROPOSED POLE LOCATION
- ANCHOR GUY LOCATIONS
- CENTER LINE OF POLE LINE

