


June 2, 1965

Robert H. Bauer
City Engineer

RECEIVED
HARTFORD, CONN.
Mar 26 11 10 AM '71
ROBERT J. GALLIVAN
TOWN OF HARTFORD

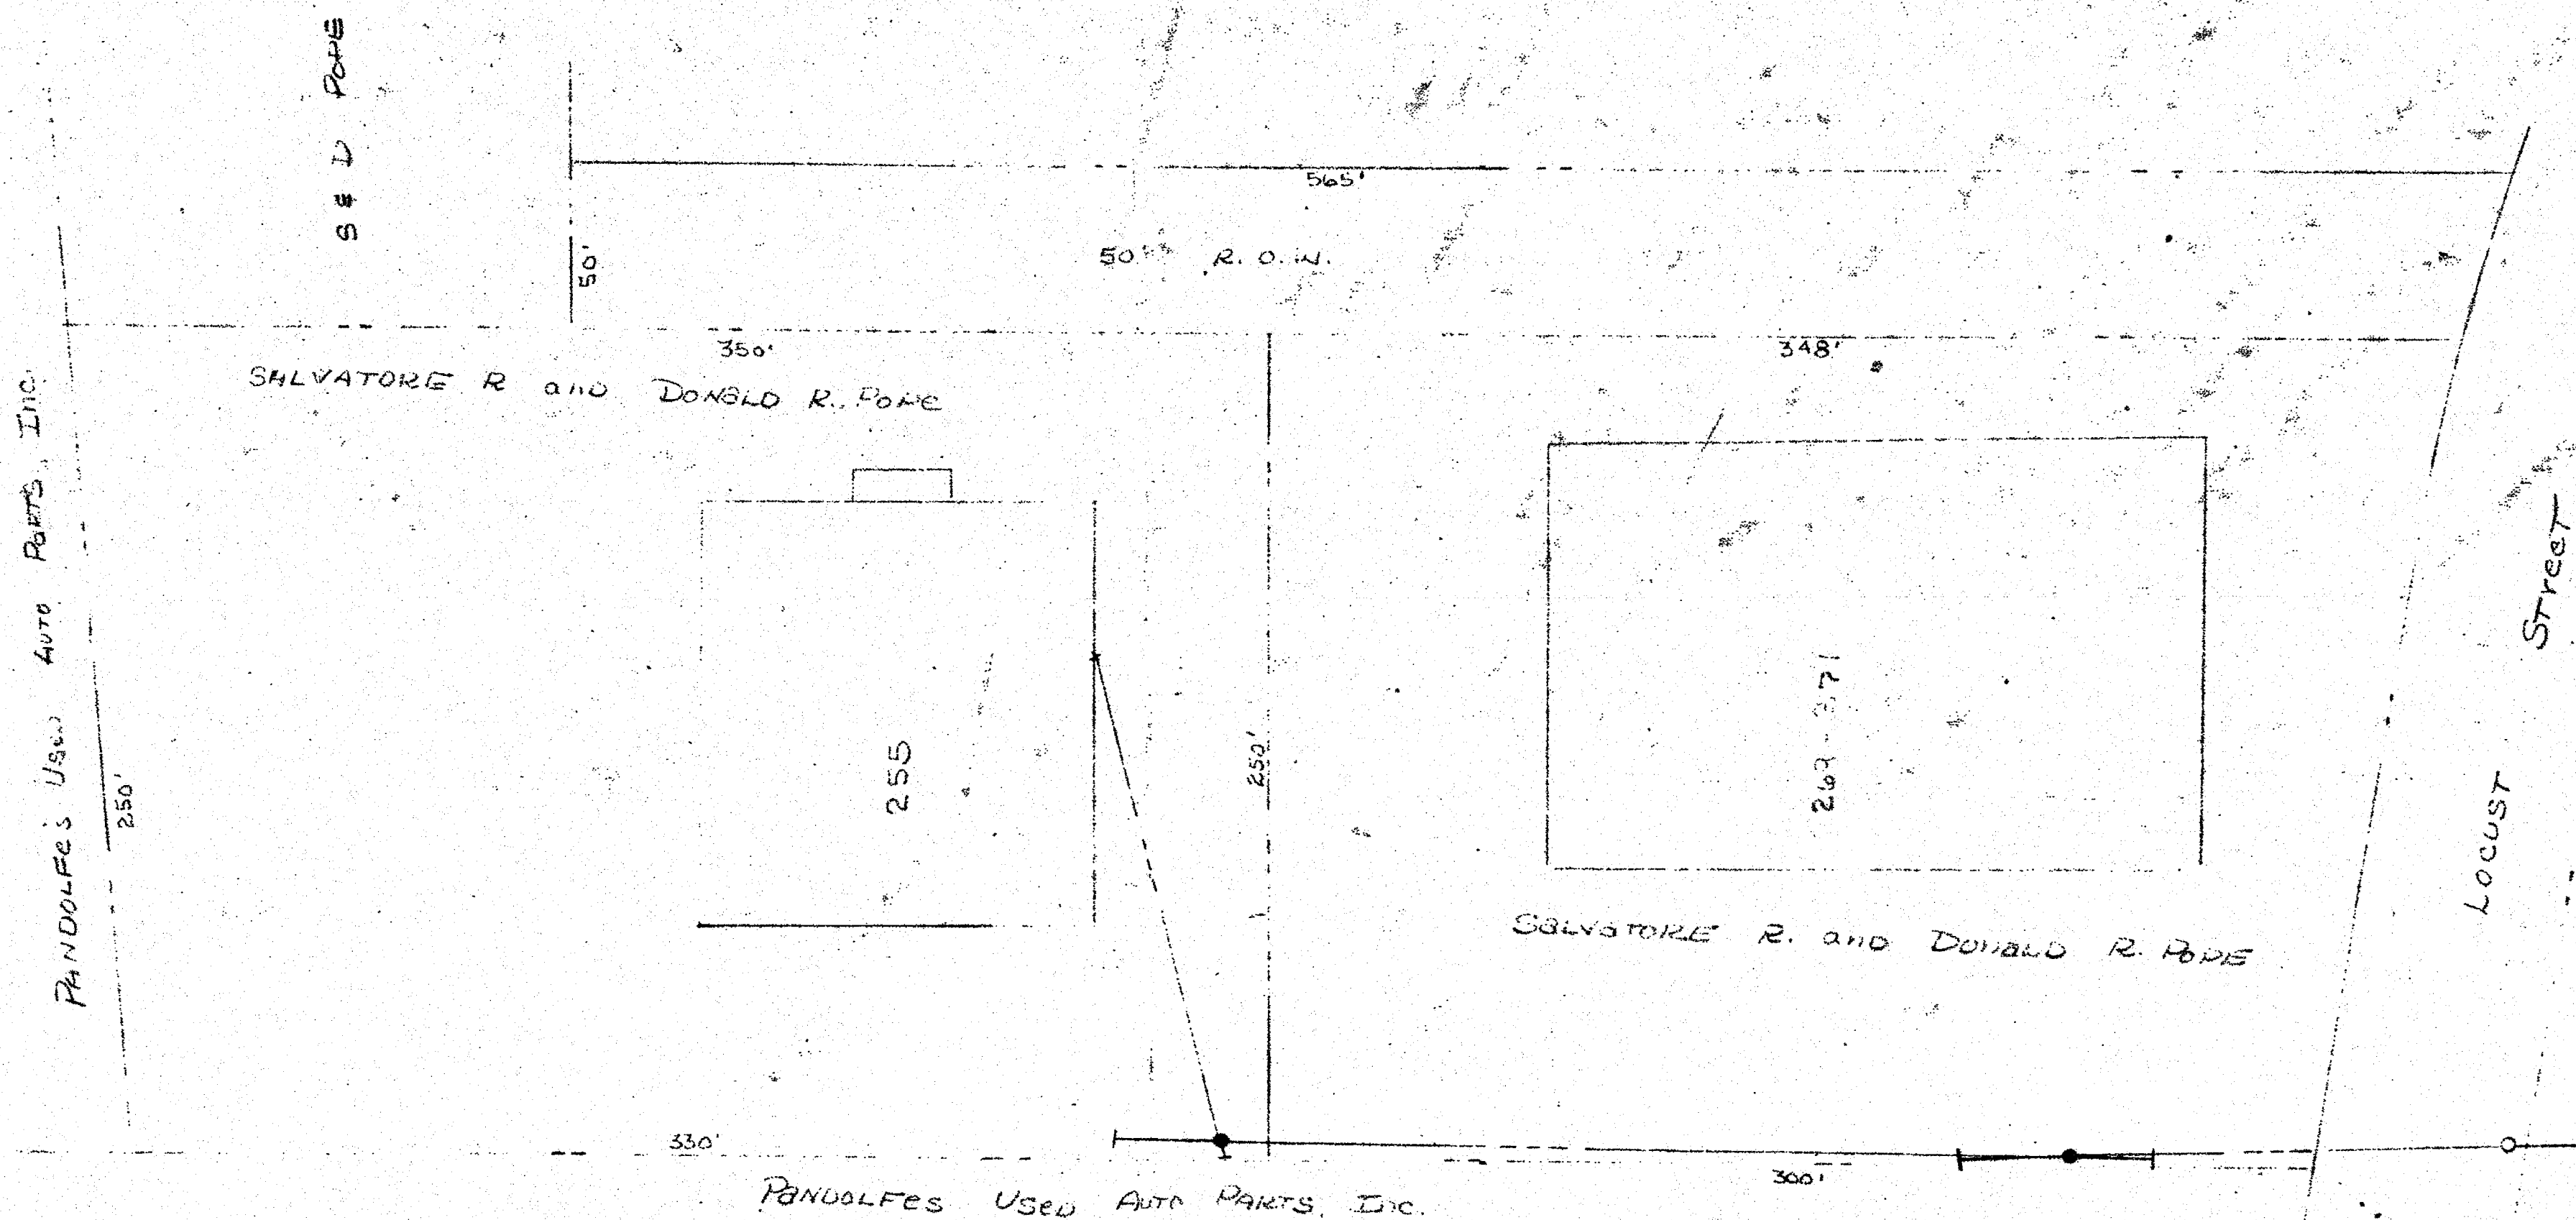

- POLE LOCATION
- ANCHOR LOCATION
- Center Line of Pole Line

THE UNDERSIGNED EMPLOYEE CERTIFIES THIS MAP TO BE
"SUBSTANTIALLY CORRECT" AND IN
ACCORDANCE WITH CLASS D OF CODE
OF CONN. TECHNICAL COUNCIL INC

THE HARTFORD ELECTRIC LIGHT COMPANY
BY Butch E. Shaban

SKETCH SHOWING WIRE LINE FACILITIES OF

THE HARTFORD ELECTRIC LIGHT CO.
ELECTRIC OPERATIONS DEPARTMENT

DRAWN BY PS CHECKED BY SH APPROVED BY _____

SCALE 1"=50'

DATE 2-4-75

NO

[illegible]