



Property of
FRANCESCO SARDO
278 Maple Ave.
Hartford Conn.
July 1966
Scale 1"=50'

The portion of Maple Ave. shown on this street of the City of Hartford, July 22, 1966.

City Engineer



MAPLE AVE

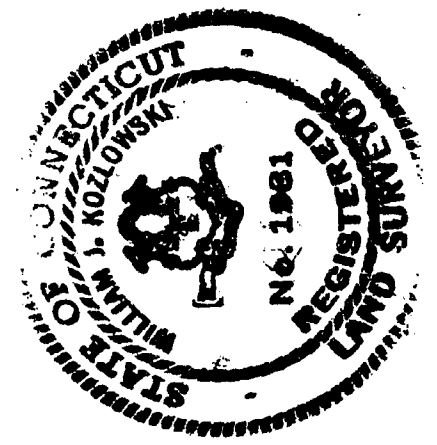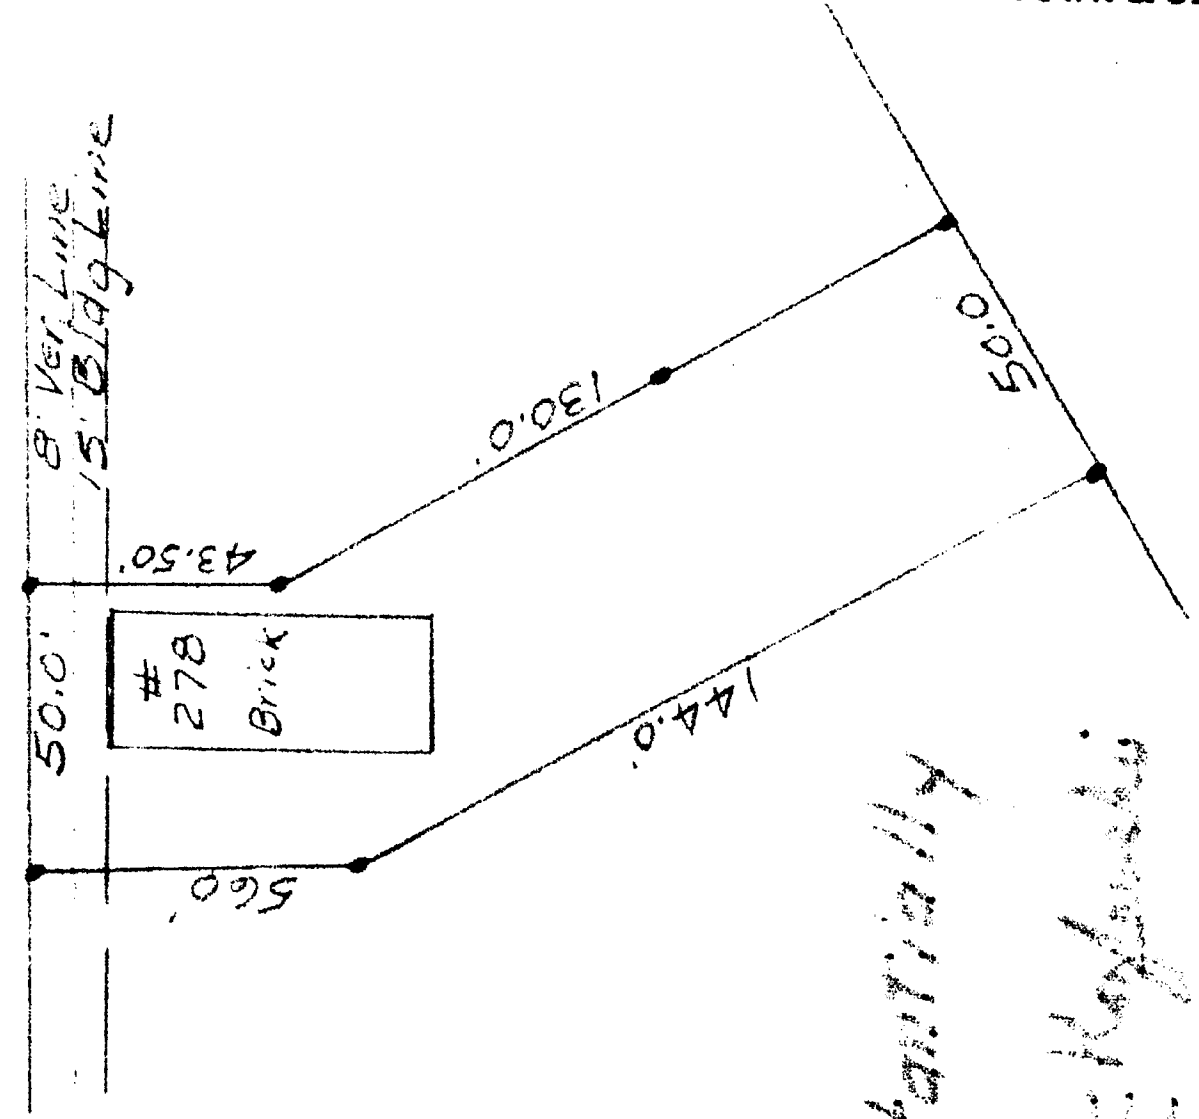

certified substantially correct.
William J. Hoffmann
Surveyor

RECEIVED
HARTFORD, CONN.
JUL 22 11 44 AM '66
ROBERT J. GALLIVAN
TOWN & CITY CLERK

