

EAST FILE CORP. IRVING, GA. 8PM 34


905

The portion of Brainard Road shown on this plan is an established public street of the City of Hartford.

George E. Neppner
 Asst. City Engineer

March 25, 1966

STATE OF CONNECTICUT

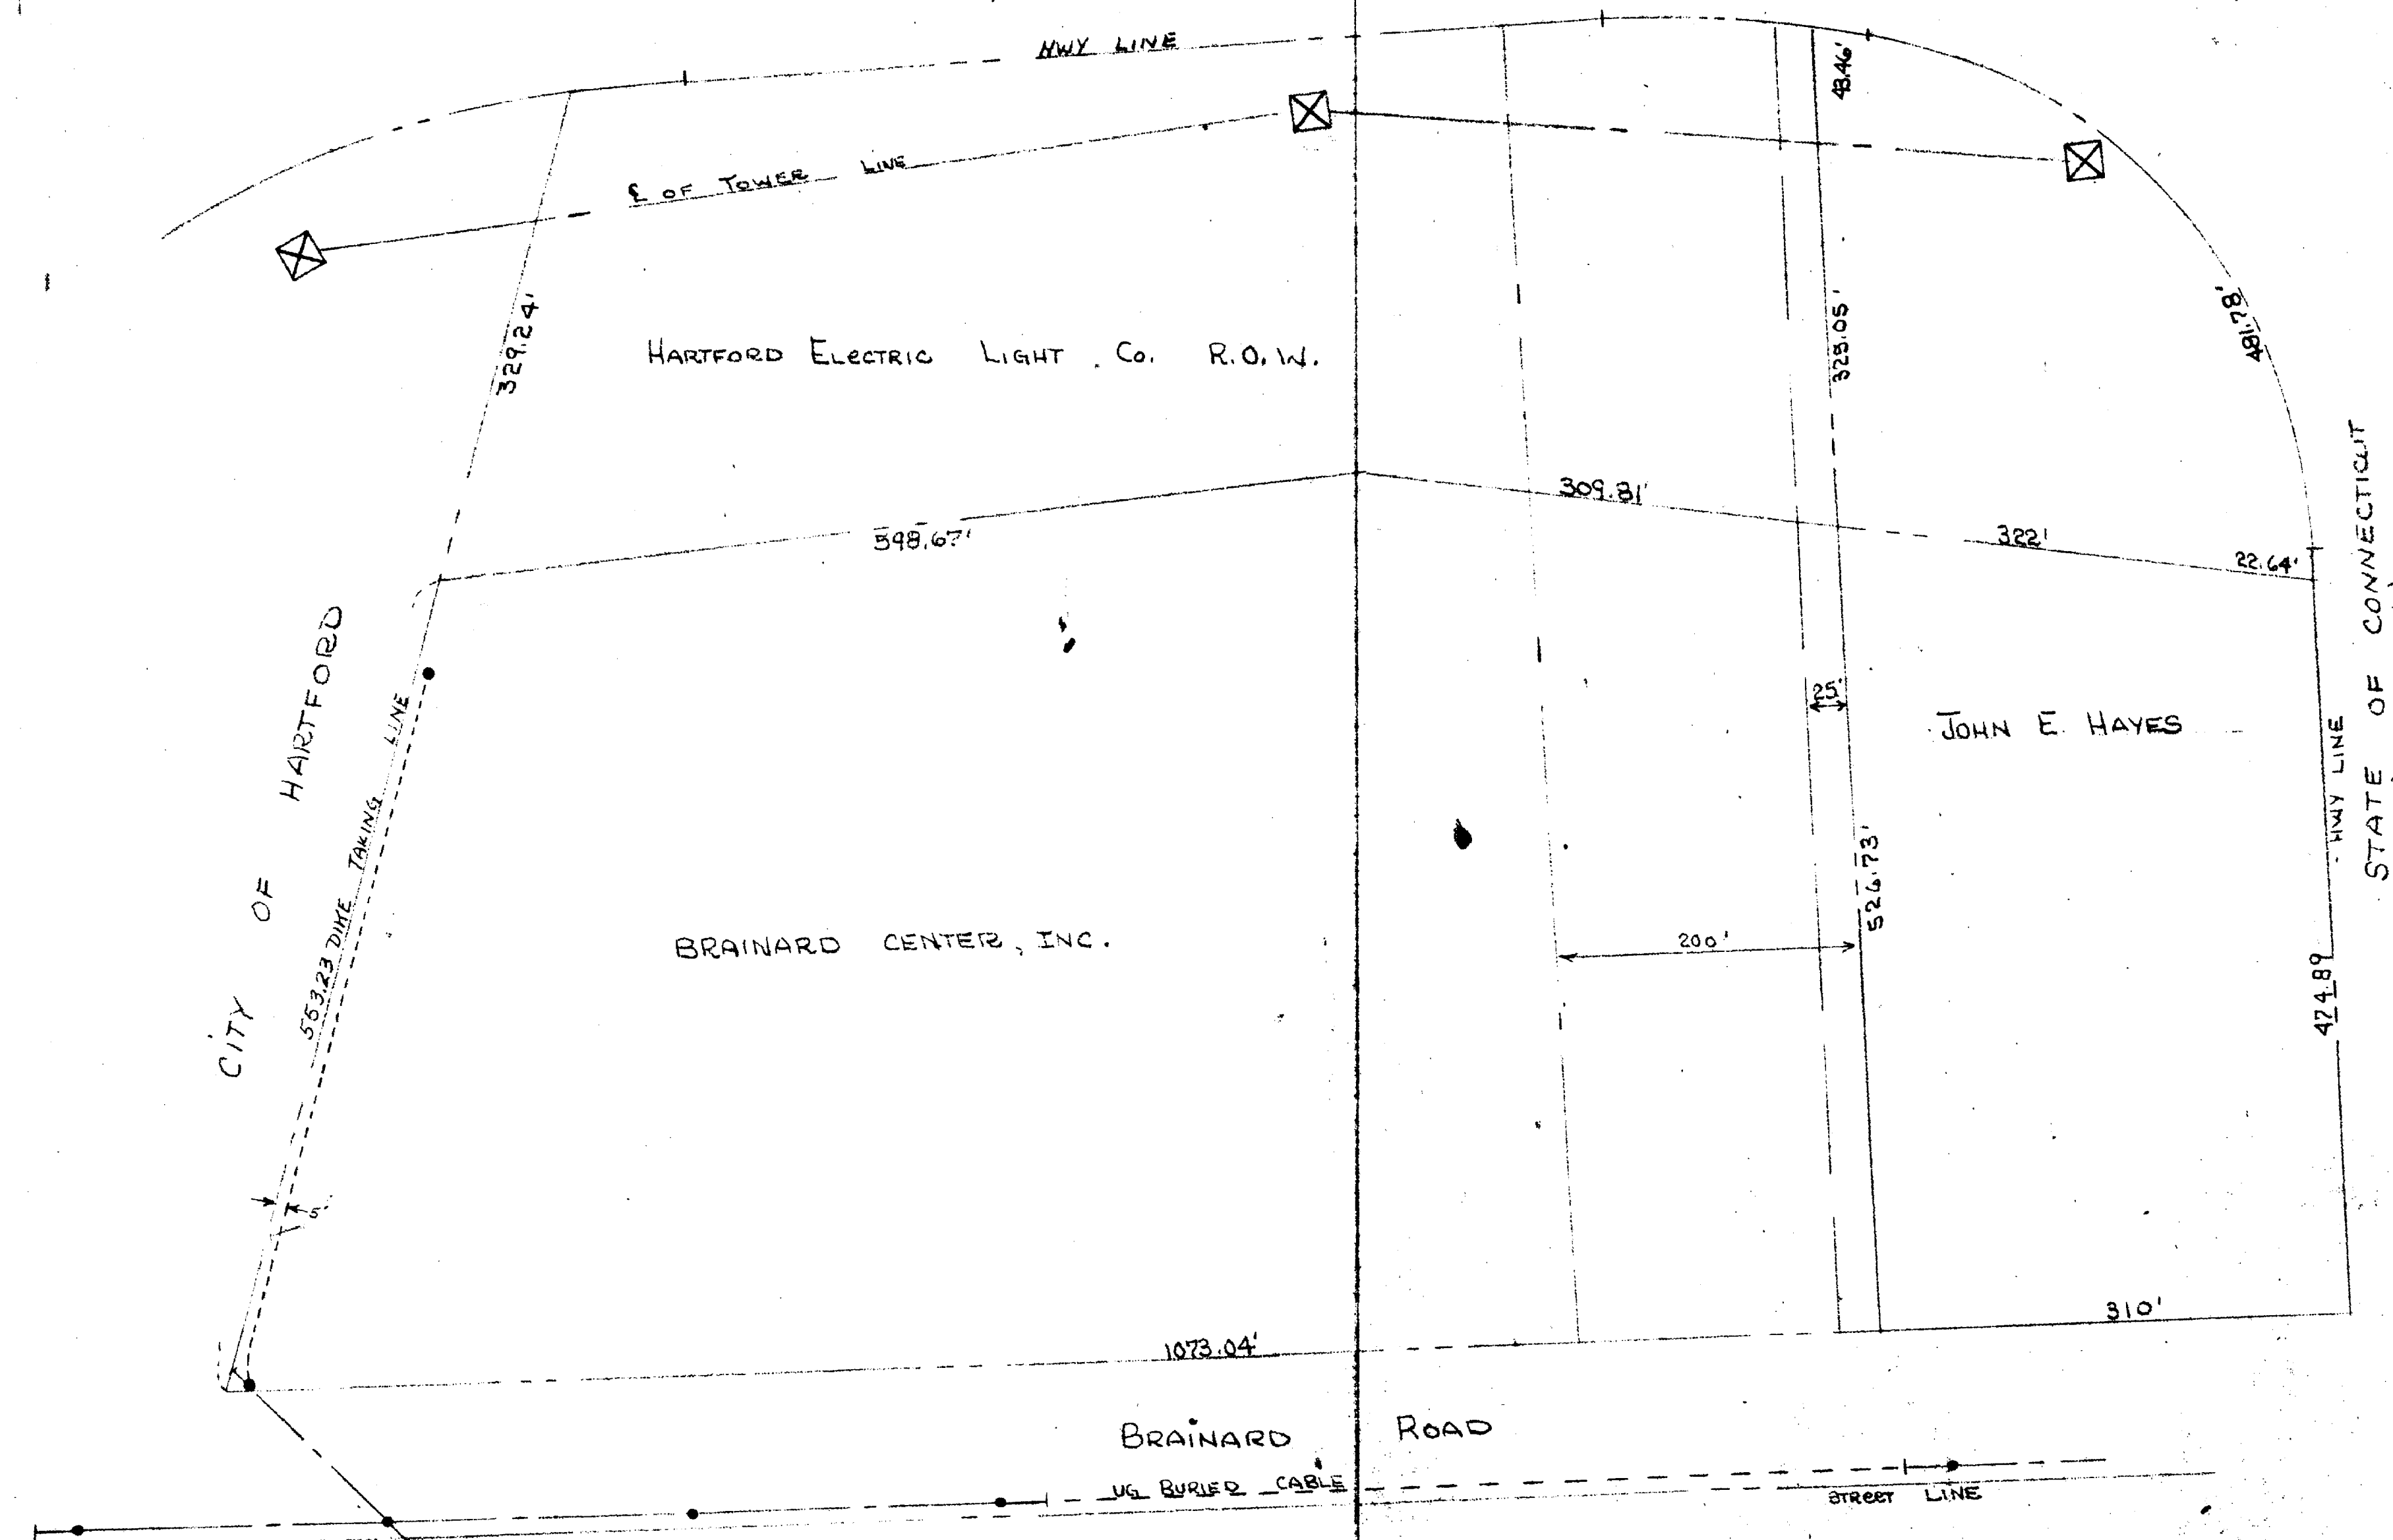

LEGEND

- POLE LOCATION
- CENTER LINE OF POLE LINE
- ANCHOR GUY
- UNDERGROUND CABLE

THE UNDERSIGNED UTILITY EMPLOYEE
 CERTIFIES THIS MAP TO BE
 "SUBSTANTIALLY CORRECT" AND IN
 ACCORDANCE WITH CLASS D OF CODE
 OF CONN. TECHNICAL COUNCIL, INC.
 FOR THE HARTFORD ELECTRIC LIGHT COMPANY
 BY *Robert E. Shaw*

SKETCH SHOWING POLES AND UNDERGROUND FACILITIES OF THE
 HARTFORD ELECTRIC LIGHT COMPANY ON THE PROPERTY OF
 BRAINARD CENTER, INC., BRAINARD ROAD, HARTFORD, CONN.
 SCALE: 1"=100', DEC. 29, 1965, FILE NO. D-012525

THE HARTFORD ELECTRIC LIGHT CO.

ELECTRIC OPERATIONS DEPARTMENT

DRAWN BY *RS-GAR* CHECKED BY *GAR* APPROVED BY

SCALE: 1"=100'

DATE DEC 29, 1965

NO. D-012525

NO.	DATE	DESCRIPTION	BY	APP. BY
1	3-7-66	Added Underground & Revised Title	GAR	

