


EAST FILE CORP. IRVINE, CA EPH 34
855

855-2


A portion of New Park Avenue shown on this plan is an established public street of the City of Hartford.

Robert H. Bunker
 City Engineer
 April 6, 1967

RECEIVED
 HARTFORD, CONN.
 APR 5 10 40 AM '67
 ROBERT H. BUNKER
 TOWN & CITY CLERK

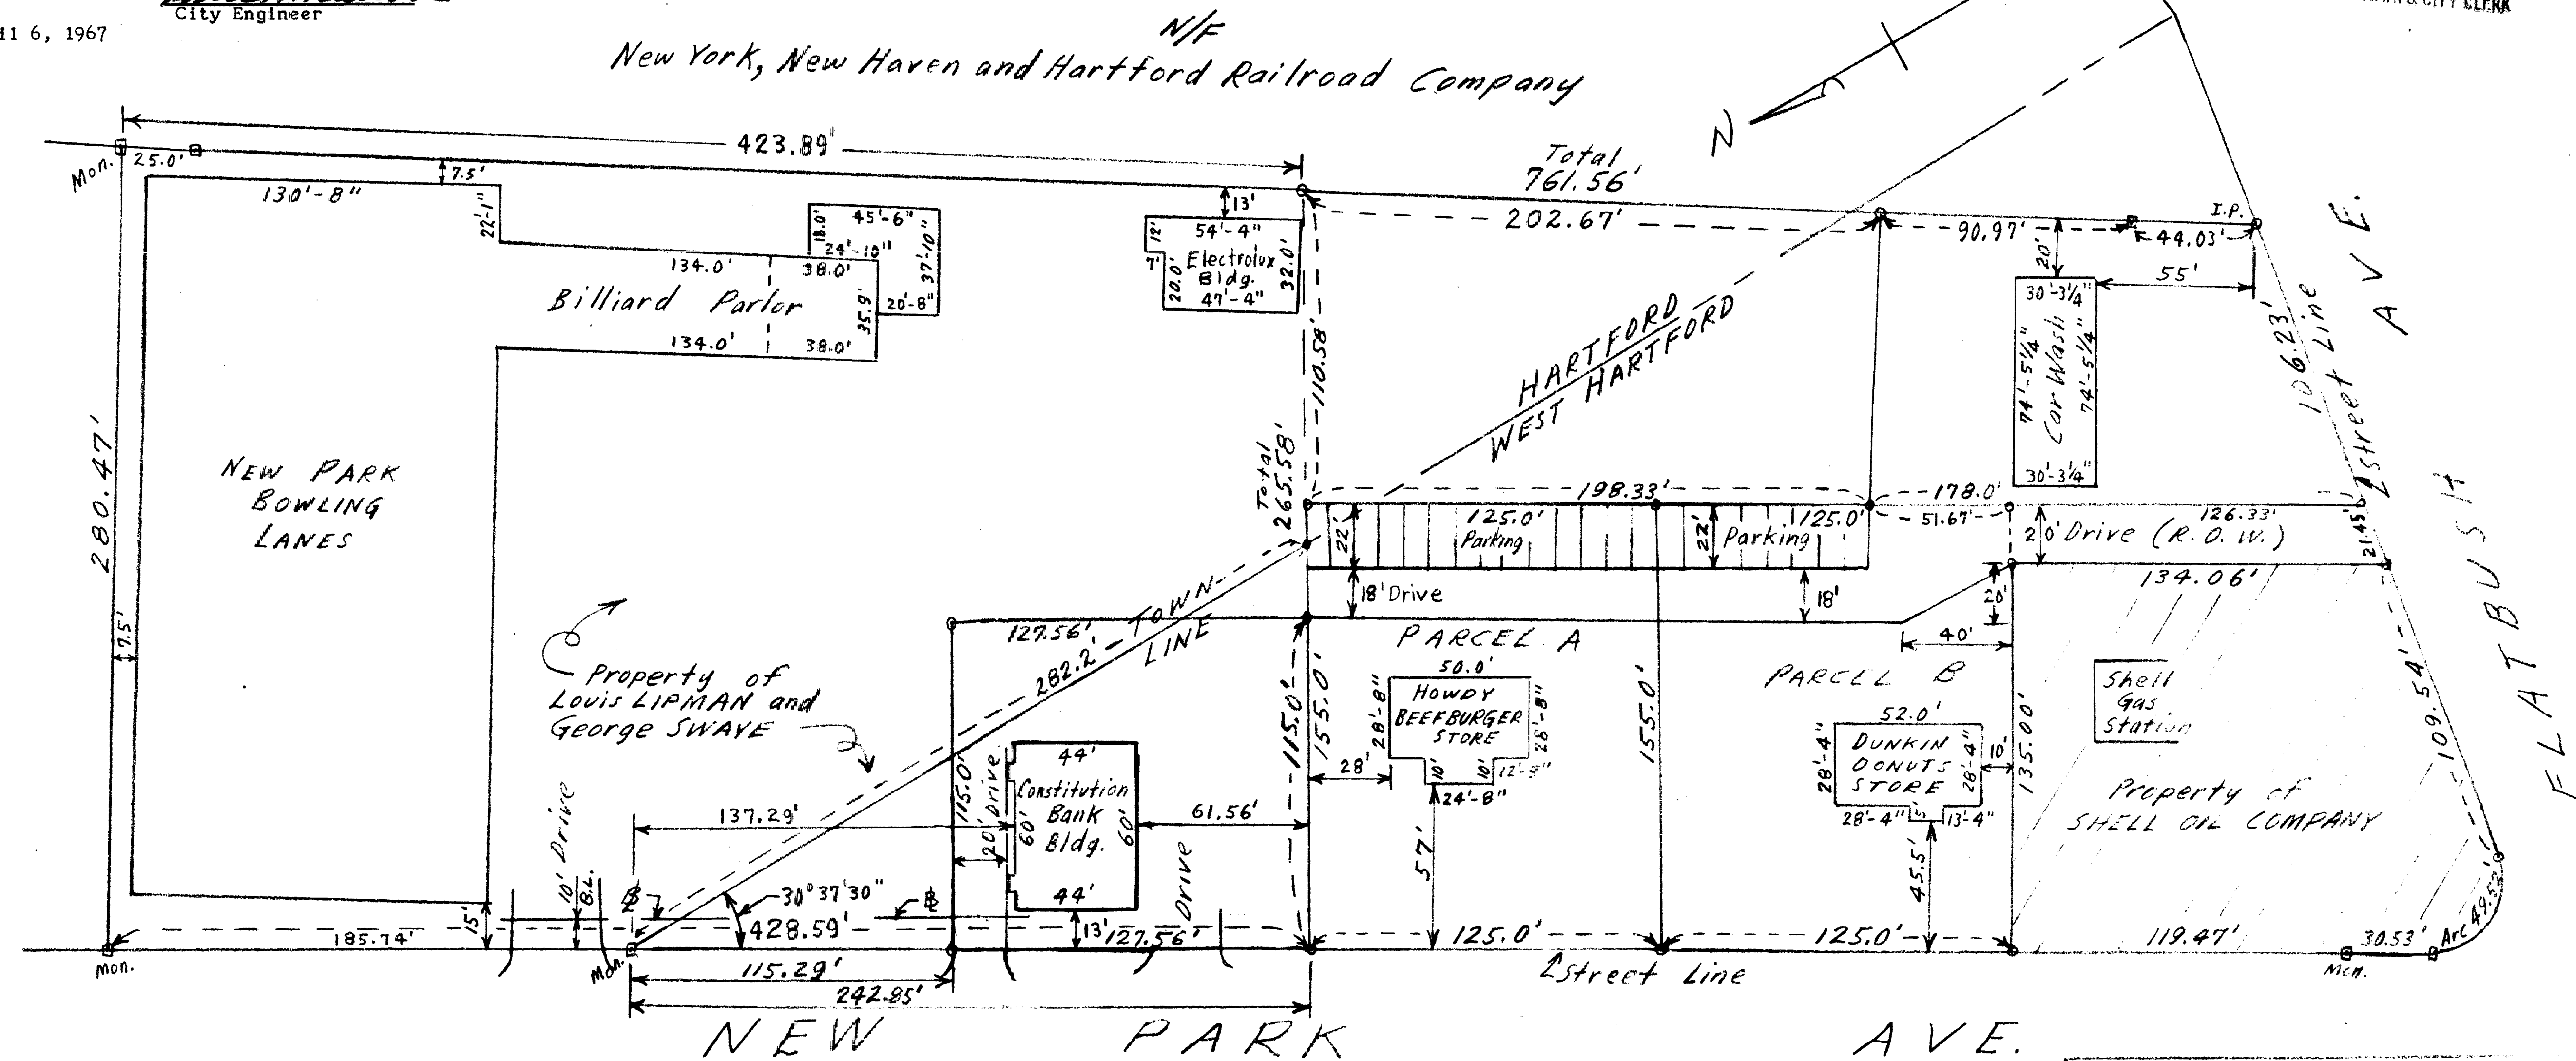

No Zoning Violated
 I hereby certify that this map
 is substantially correct.
Theodore E. Miller
 Civil Engineer & Land Surveyor

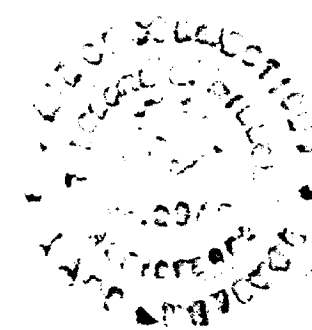

PROPERTY SURVEY	
NEW PARK AVE. - BUILDINGS	
NEW PARK AVE. - Hartford, Conn.	
OWNERS: Louis LIPMAN & George SWAYE	
T. E. MILLER - ENGINEER	
Scale: 1" = 40'-0"	SHEET No. 1
Date: NOV. 29, 1966	of 1 Sheet
REV. MARCH 27, 1967	

