


Lotus F. Barrow
CITY ENGINEER


CASE FILE GROUP NUMBER 00 856	874 36
---	--------

856-1

RECEIVED
HARTFORD, CONN.
APR 20 3 14 PM '67
ROBERT J. GALLIVAN
TOWN & CITY CLERK

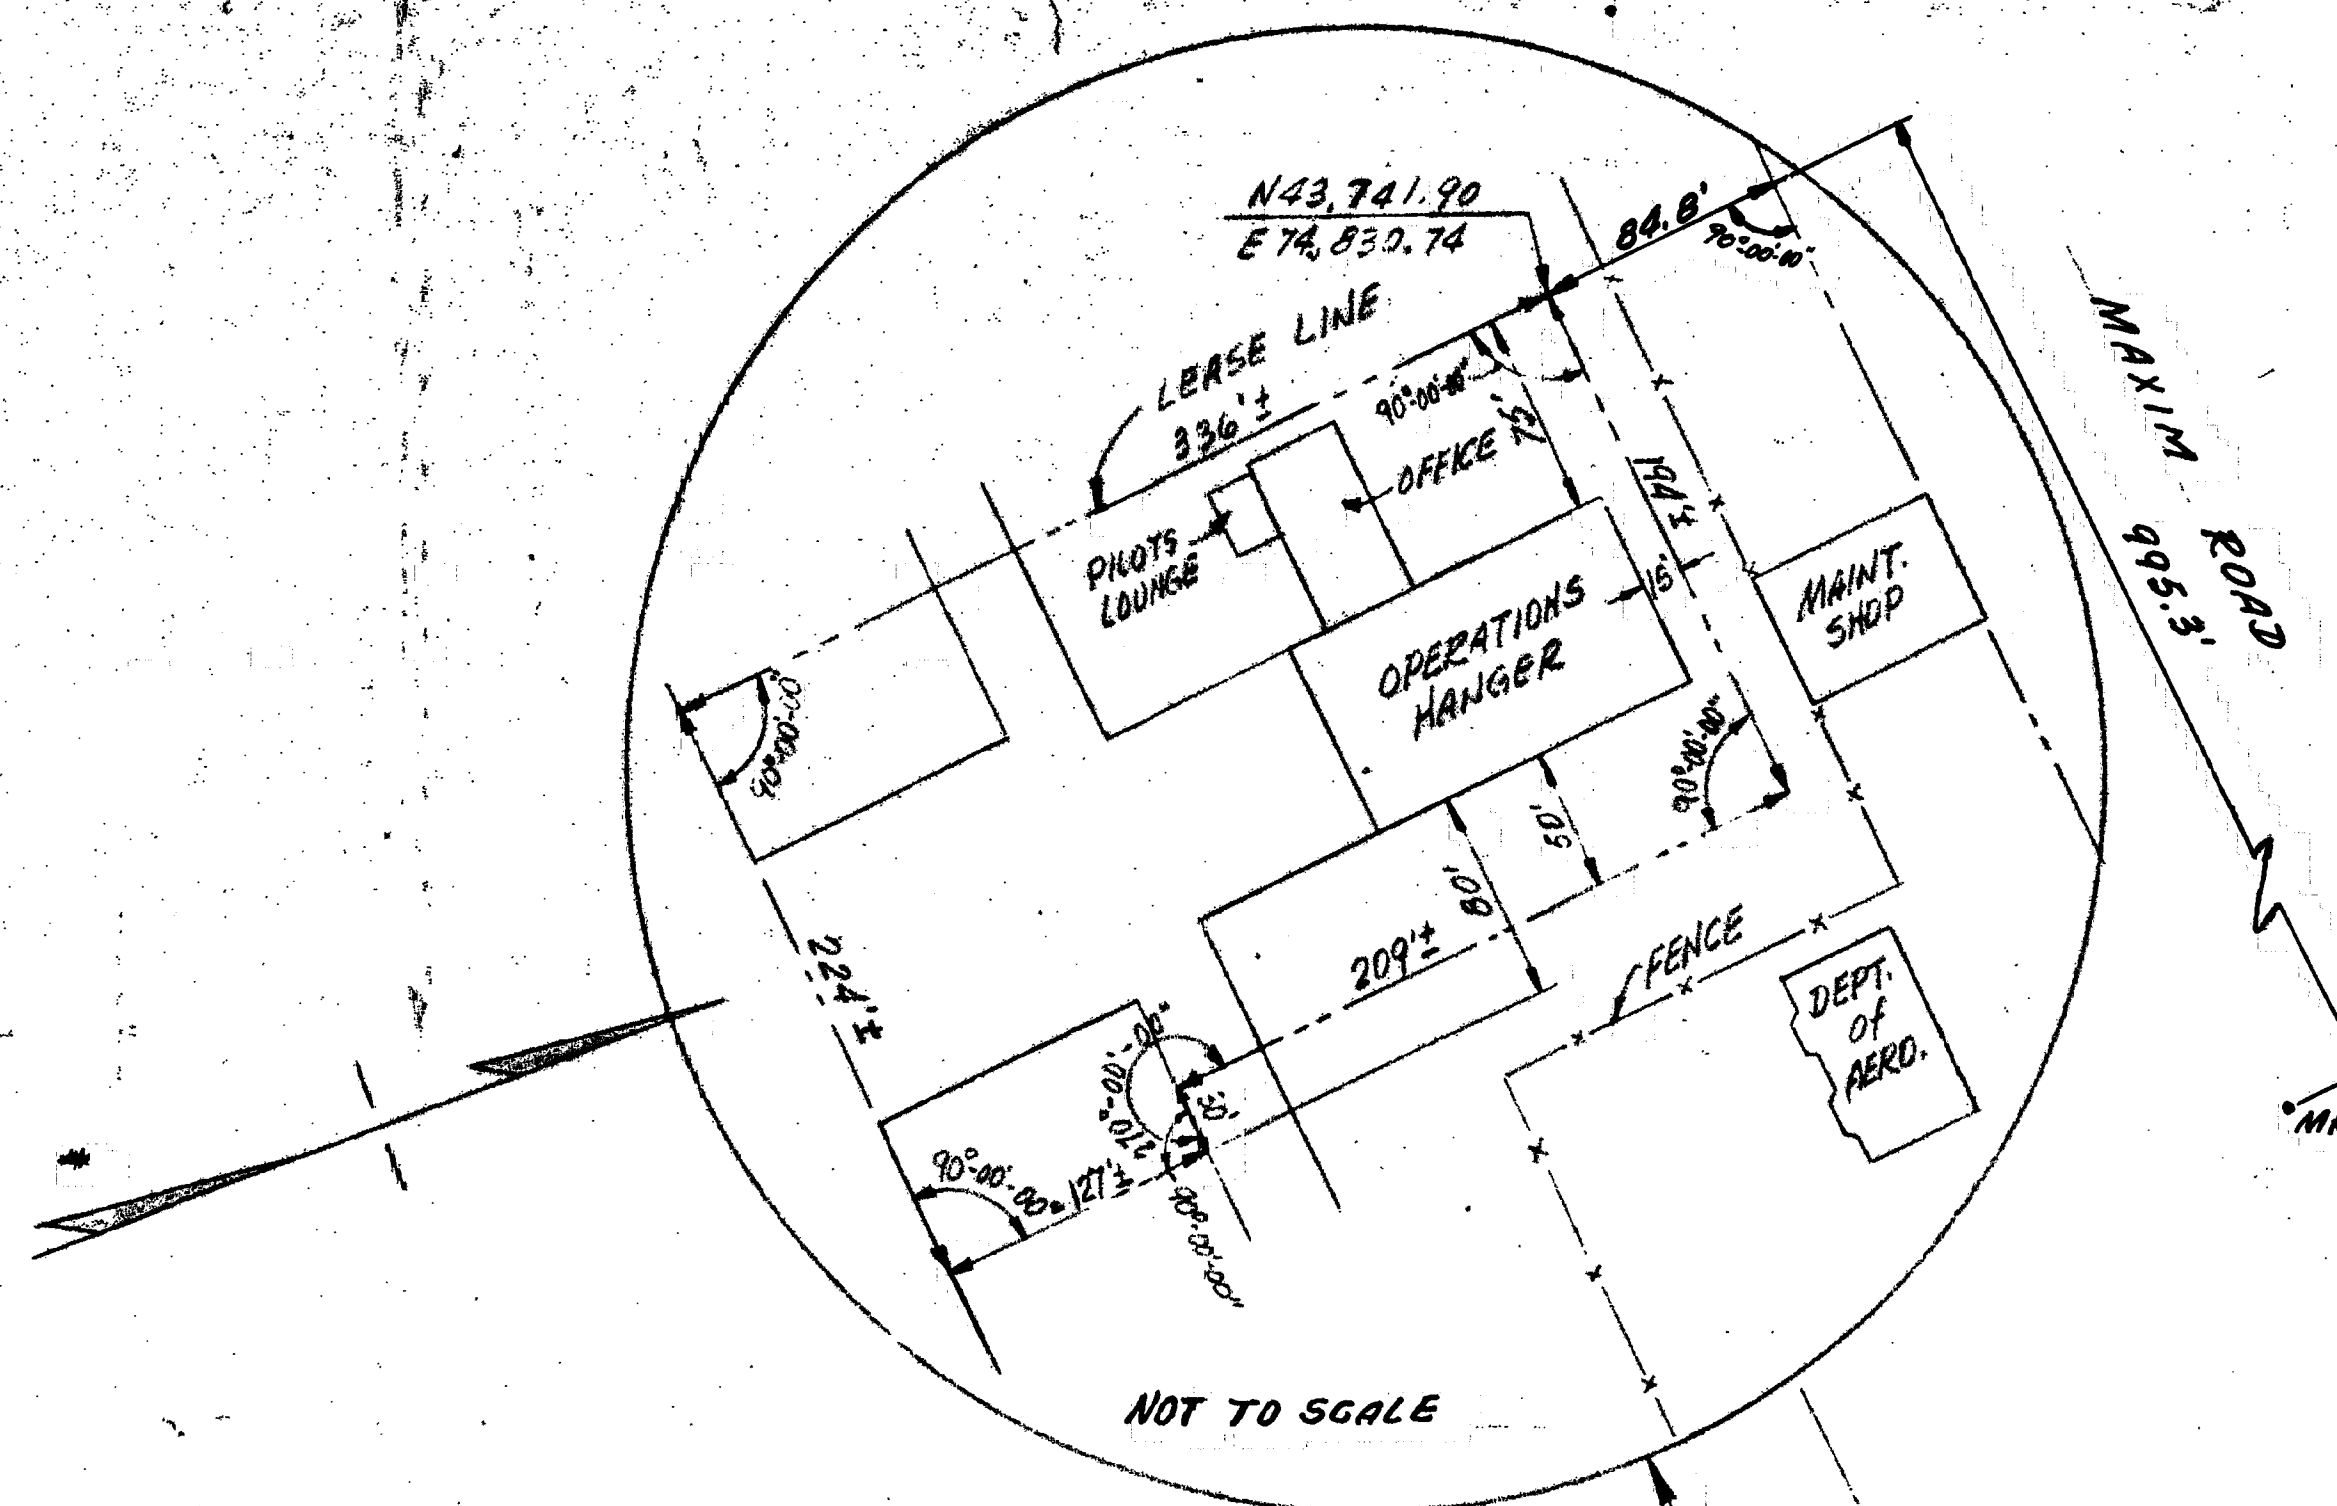

CITY of HARTFORD

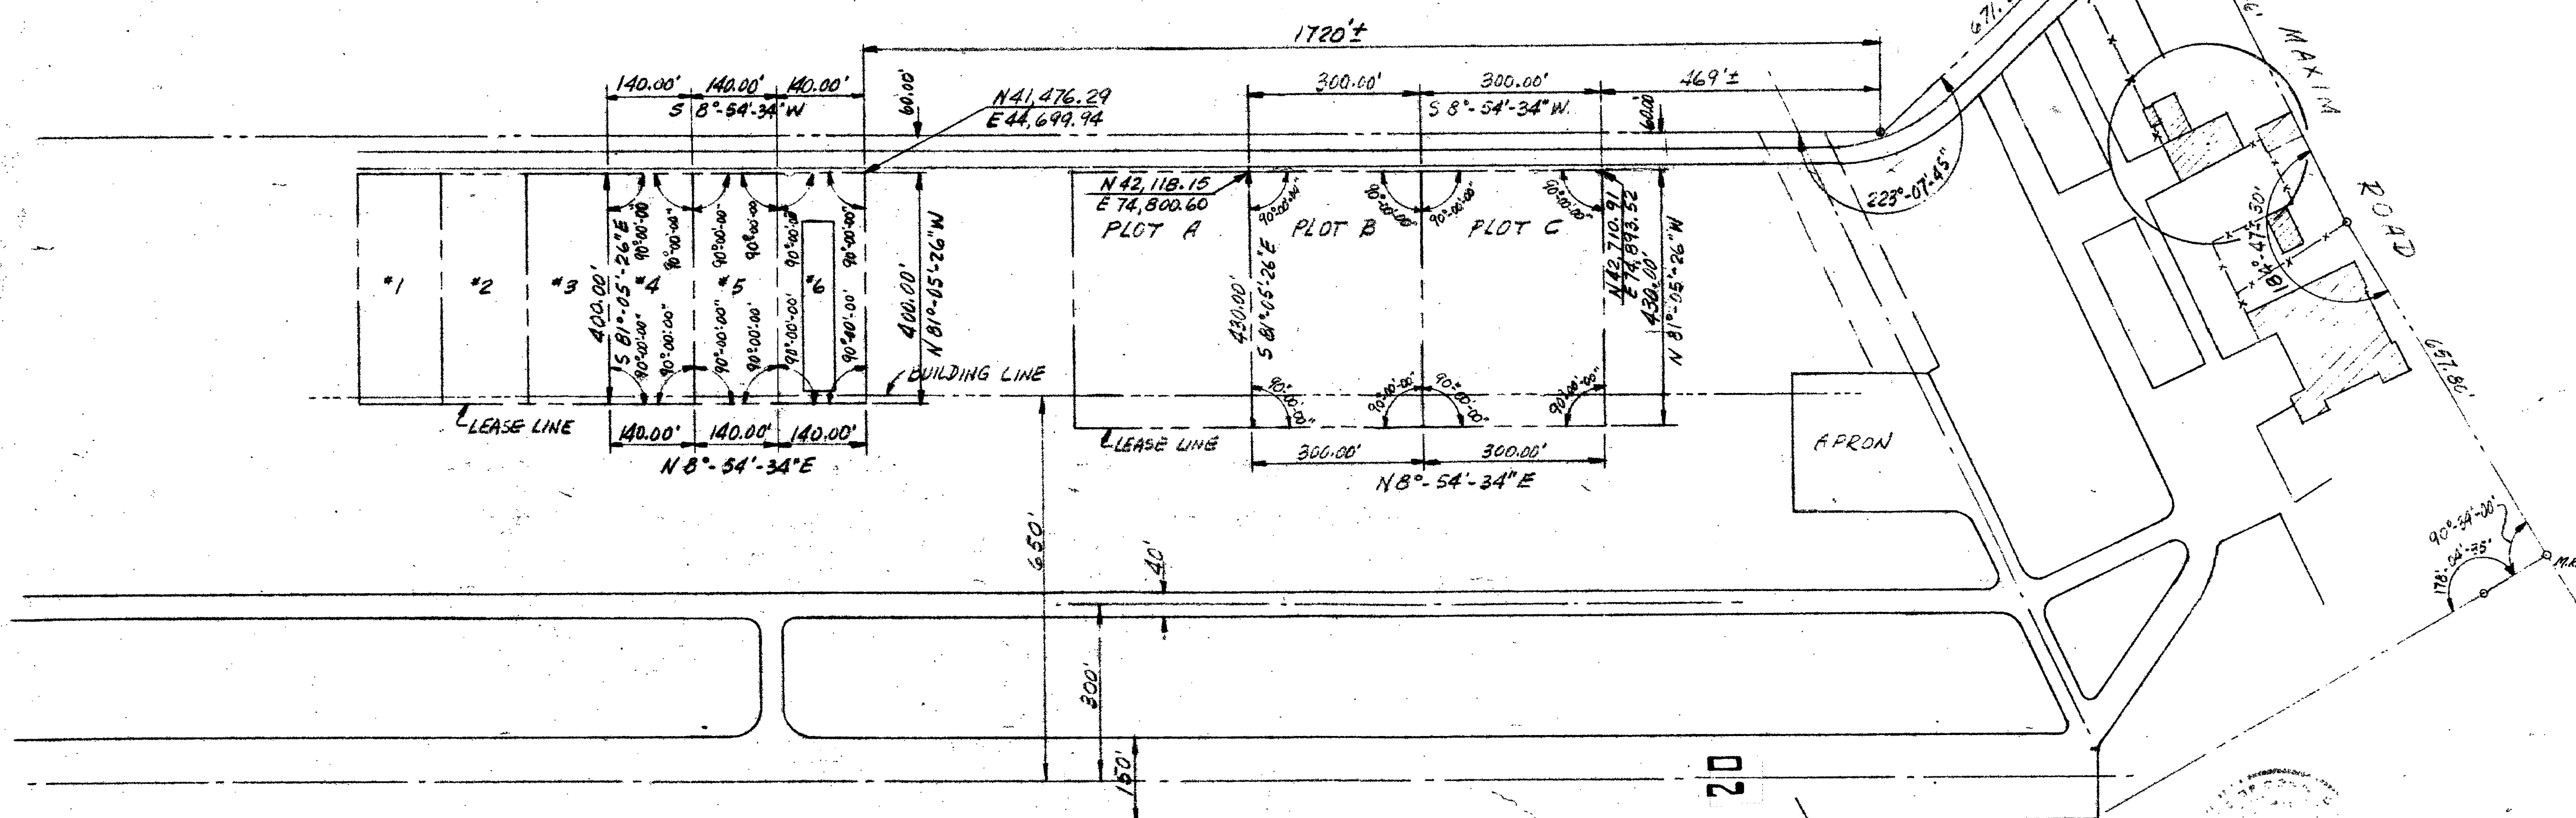

"To Connecticut Attorneys' Title Guaranty Fund, Inc.
I hereby certify that this survey was actually made upon the ground, and that it and the information, courses and distances shown thereon are correct; that the title lines and lines of actual possession are the same; that the size, location and type of buildings and improvements are as shown and all are within the boundary lines of the property.

David F. Hirsch
Registered Land Surveyor

DEPARTMENT OF AERONAUTICS
State of Connecticut
Brainard Field
Hartford, - Connecticut

AREA LEASED TO HARTFORD AIR MOTIVE INC.
BRANARD AIRPORT HARTFORD CONN.

Drawn by <i>wel</i>	Date 2-20-67
Checked by <i>h. me</i>	Scale 1"=200'

CHART-PAY, INC. LEEDS, MASS. SPH-2080

