

863

RECEIVED
HARTFORD, CONN.
NOV 8 4 03 PM '67
ROBERT J. GALLIVAN
TOWN & CITY CLERK

Survey of
Property of
THE R. & W. COMPANY
3400-06 Main Street (rear)
Hartford Conn.
Sept. 1967 Scale 1" = 40'




Certified substantially
correct, zoning not
violated.
William F. Koganski
Surveyor

Ruth Sobol

N.Y. N.H. & H.R.R.CO.

North

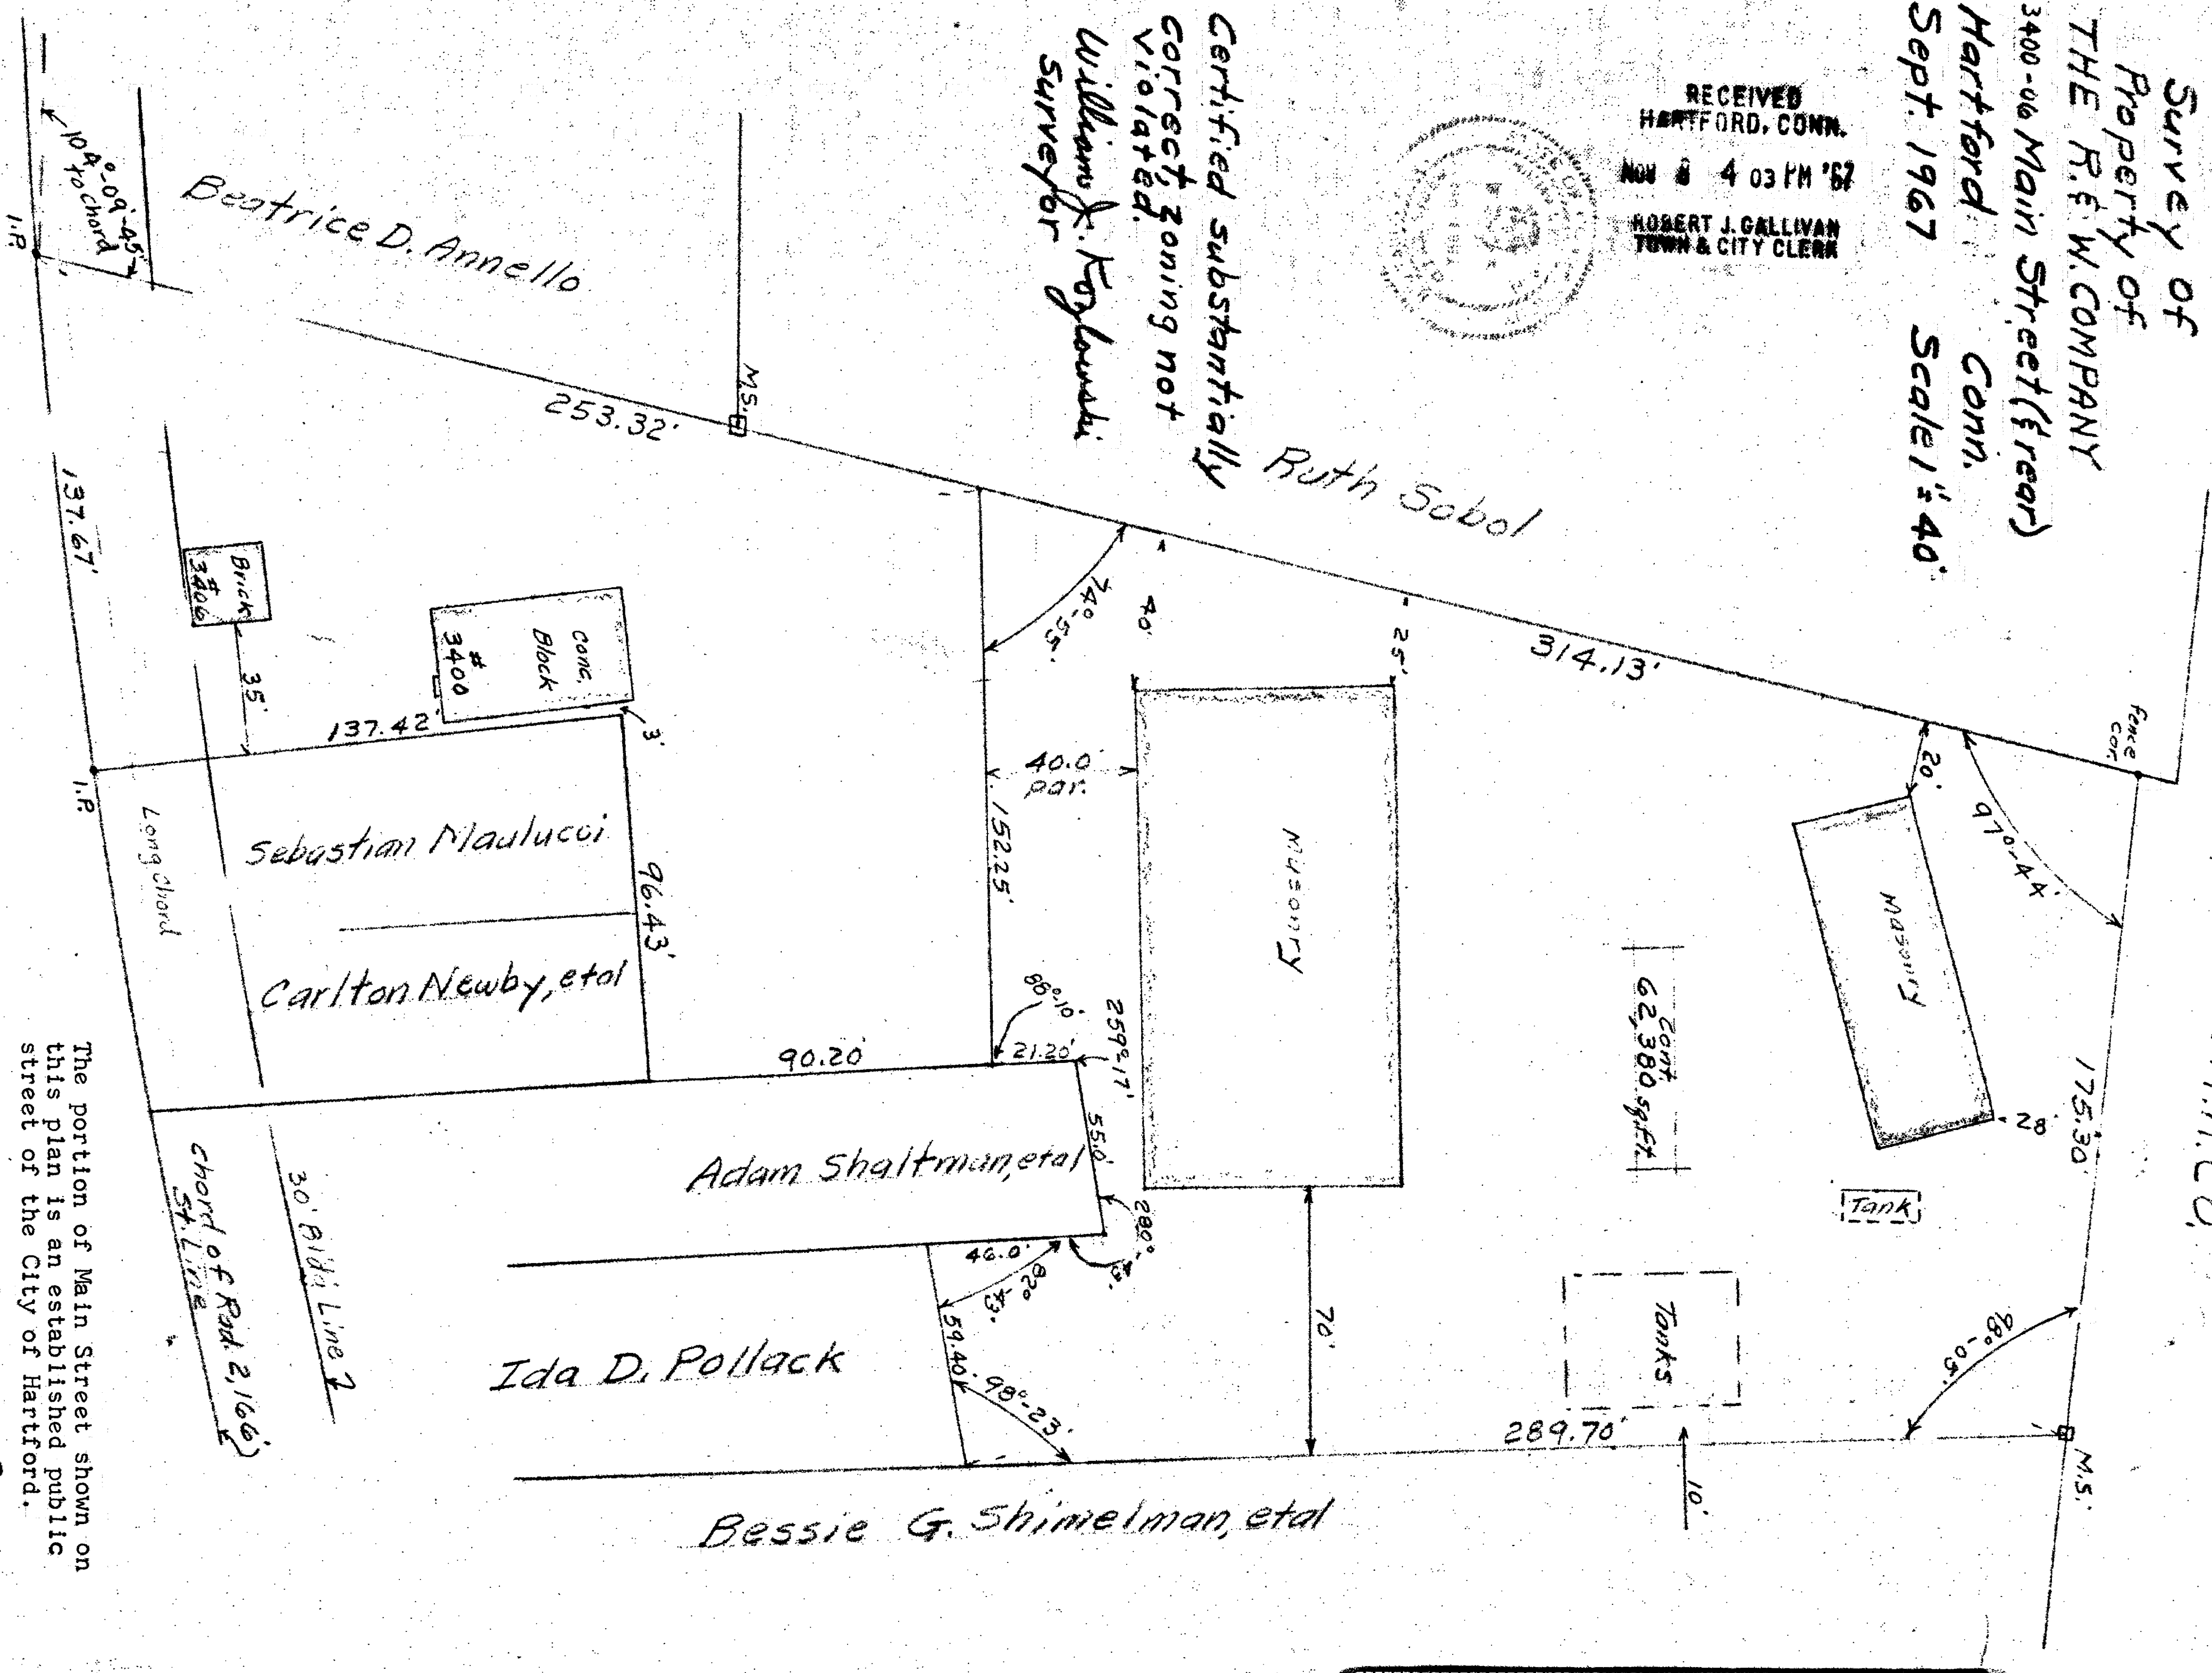

The portion of Main Street shown on this plan is an established public street of the City of Hartford.

City Engineer

ST November 9, 1967

