


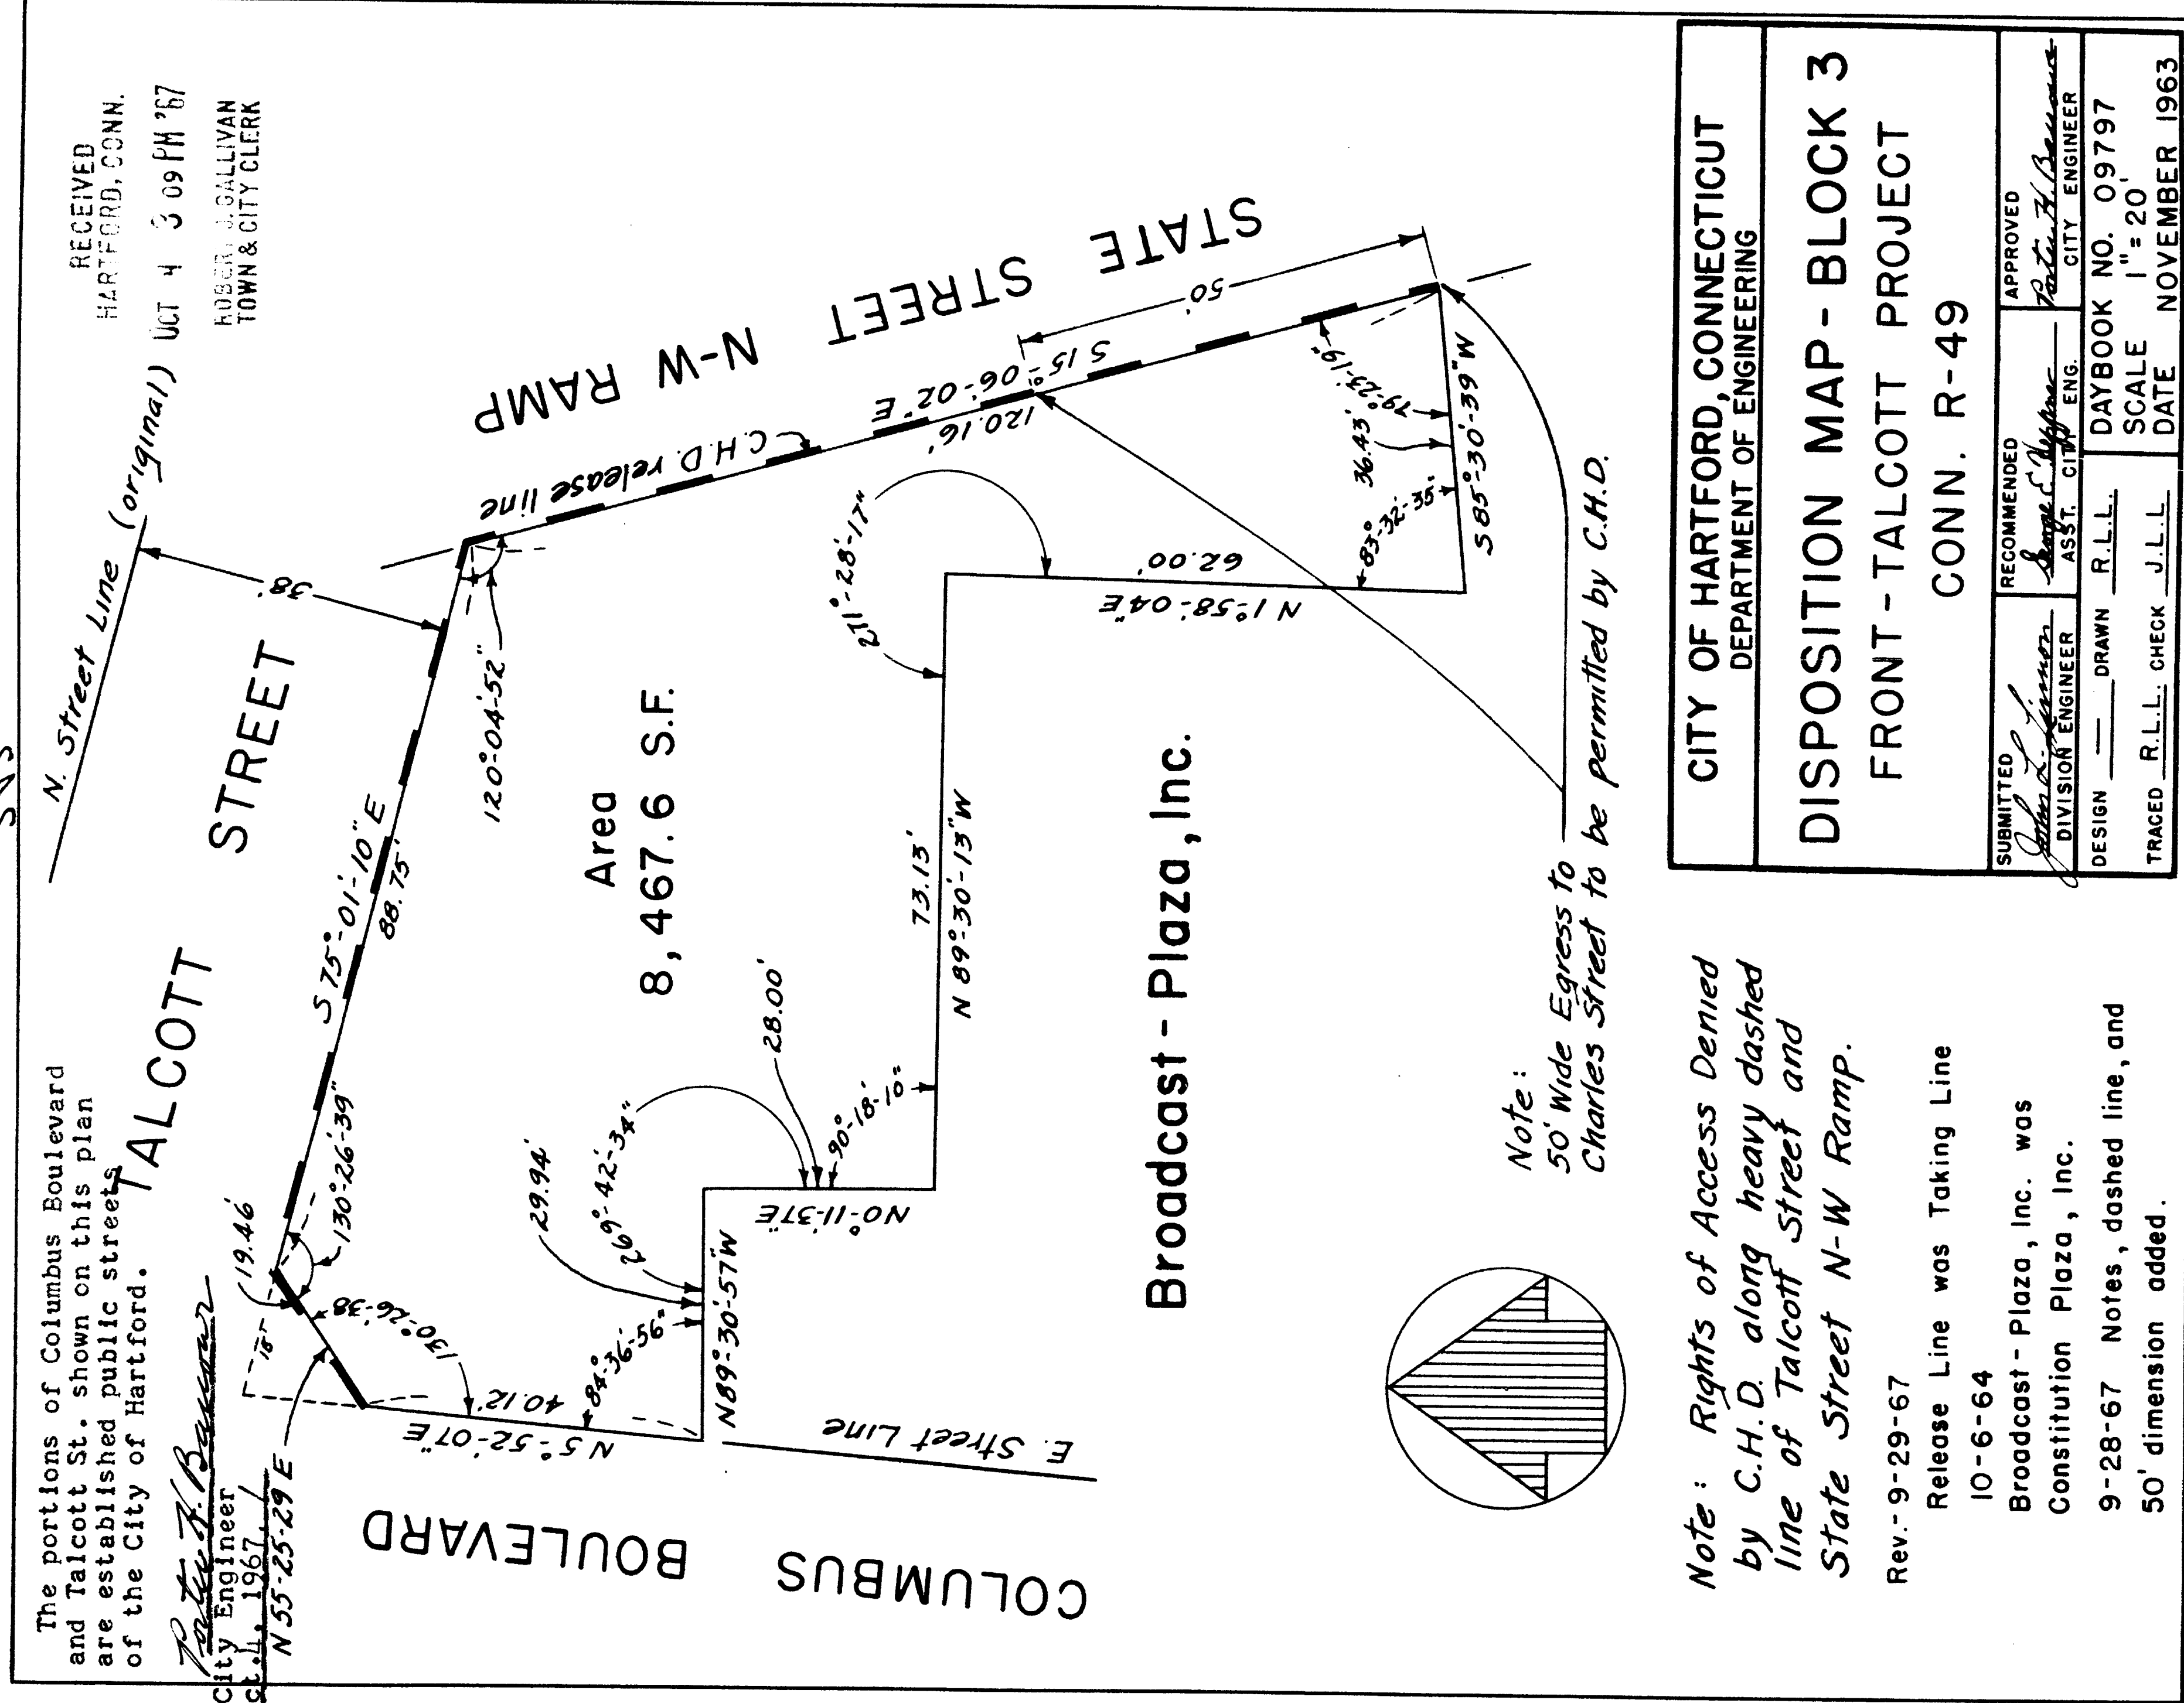

EASI FILE CORP. IRVINE CA EFM-34

863

863-1

SAS
PS