

January 10, 1968

Robert H. Bannow
City Engineer

WASHINGTON STREET
HARTFORD, CONN.


SCALE: 1 INCH = 20 FEET DECEMBER, 1967

PETERSEN & HOFFMAN
SUCCESSORS TO SPENCER & WASHBURN, INC.

I HEREBY CERTIFY THAT THIS MAP IS SUBSTANTIALLY CORRECT.

Alton H. Smith

RECEIVED
HARTFORD, CONN.
JAN 9 3 31 PM '68
ROBERT J. GALLIVAN
TOWN & CITY CLERK

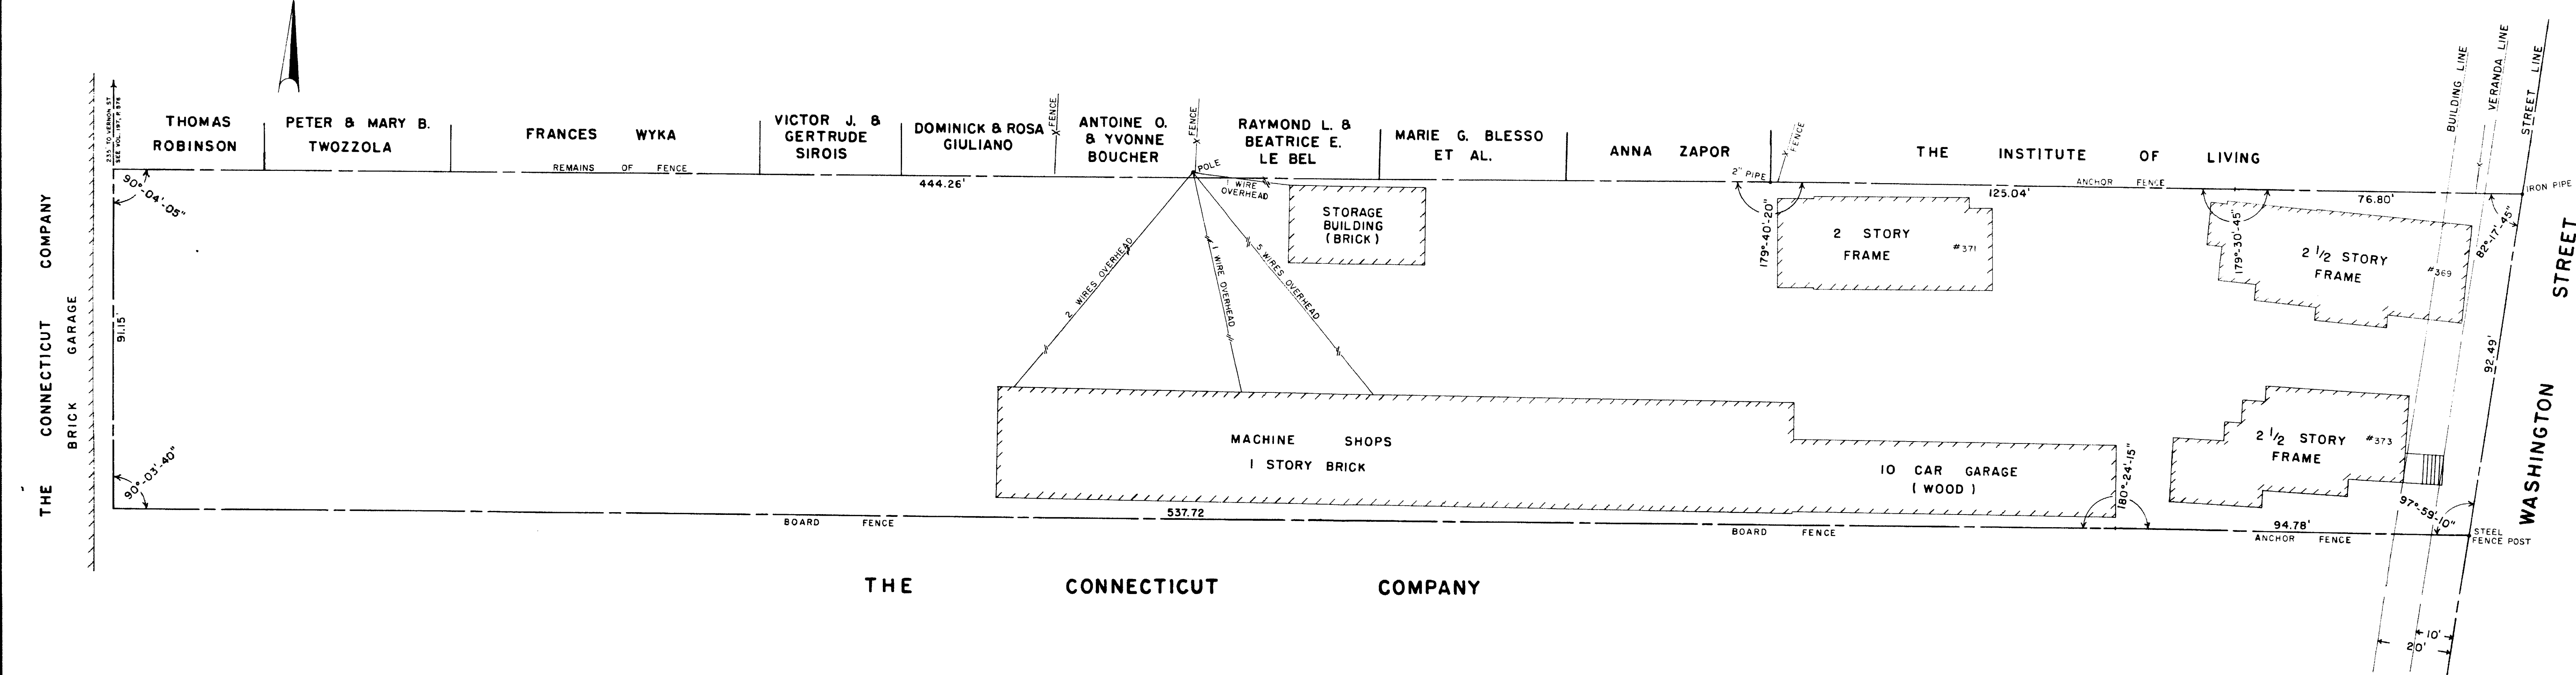

THE CONNECTICUT COMPANY

593