


CPH 34

869-1

Mar. 1, 1968

Walter H. Bower
City of Hartford
City Engineer

RECEIVED
HARTFORD, CONN.
MAR 1 11 05 AM '68
ROBERT J. GALLIVAN
TOWN & CITY CLERK

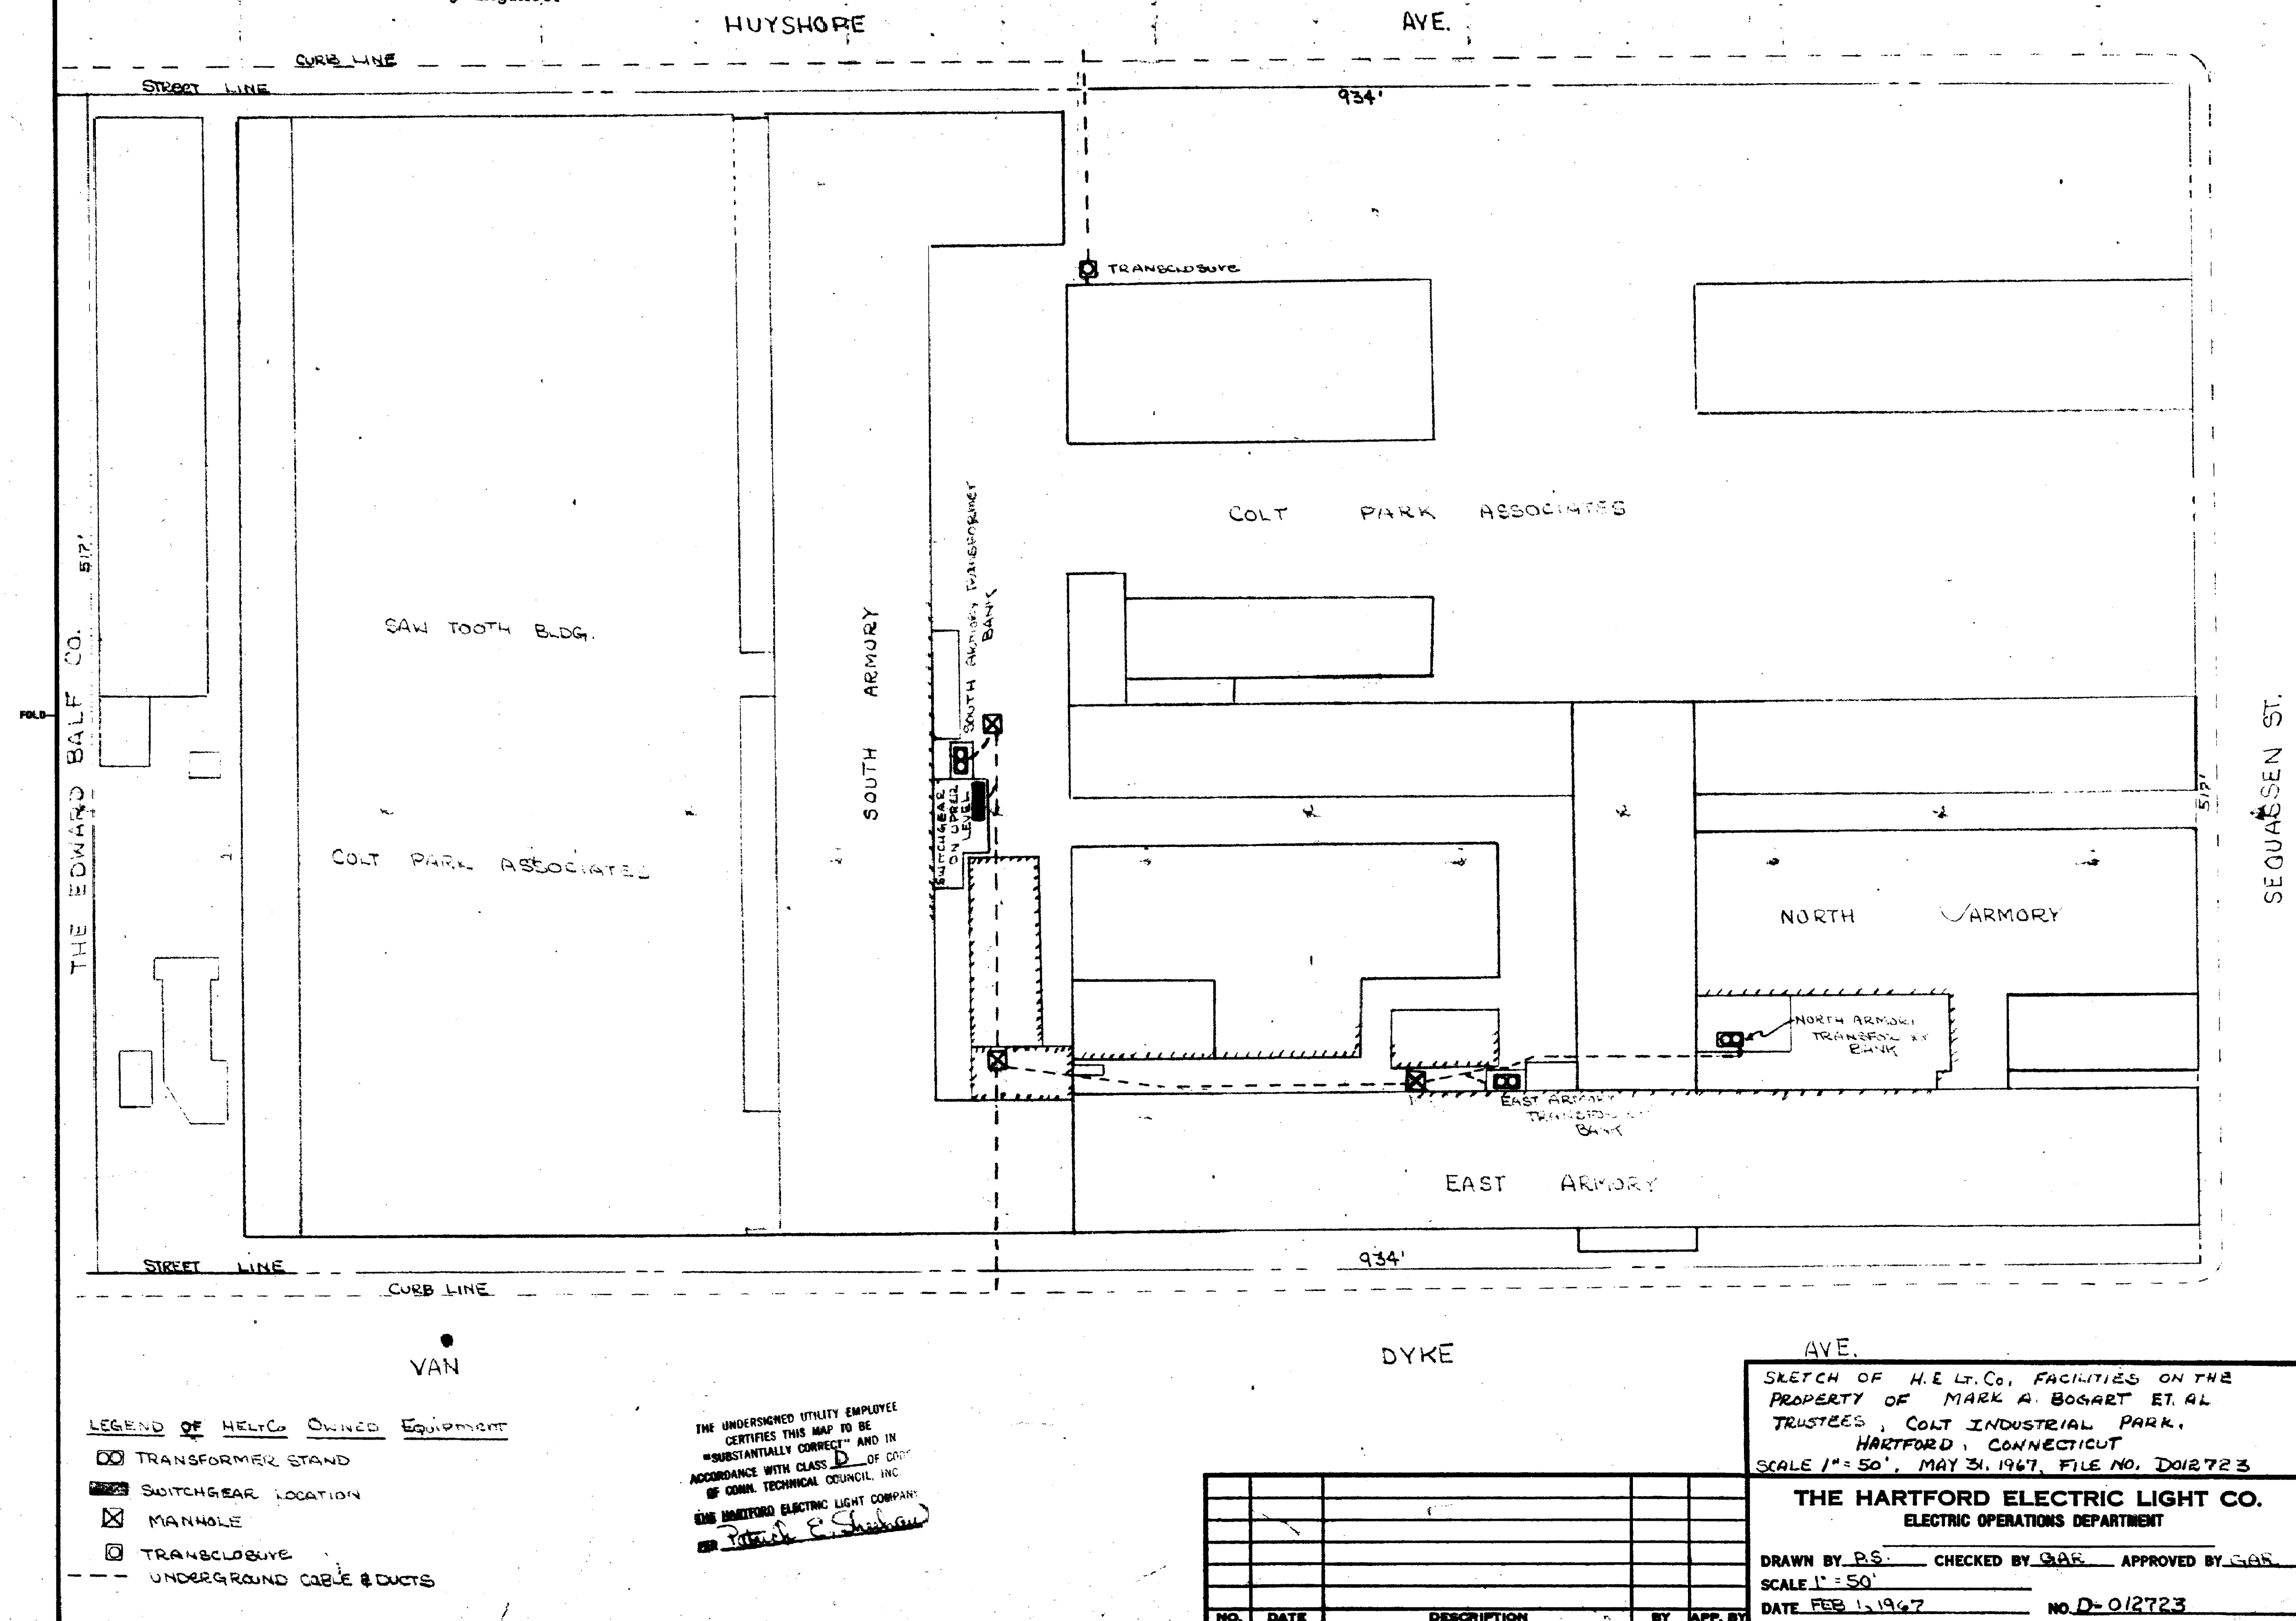

SKETCH OF H.E. LT. CO. FACILITIES ON THE
PROPERTY OF MARK A. BOGART ET AL
TRUSTEES, COLT INDUSTRIAL PARK,
HARTFORD, CONNECTICUT
SCALE 1"=50', MAY 31, 1967, FILE NO. DOIR 723

THE HARTFORD ELECTRIC LIGHT CO.
ELECTRIC OPERATIONS DEPARTMENT

DRAWN BY P.S. CHECKED BY GAR APPROVED BY GAR
SCALE 1" = 50'
DATE FEB 15, 1967 NO. D-012723