EASI FILE CORP IRVINE CA

877

877-2

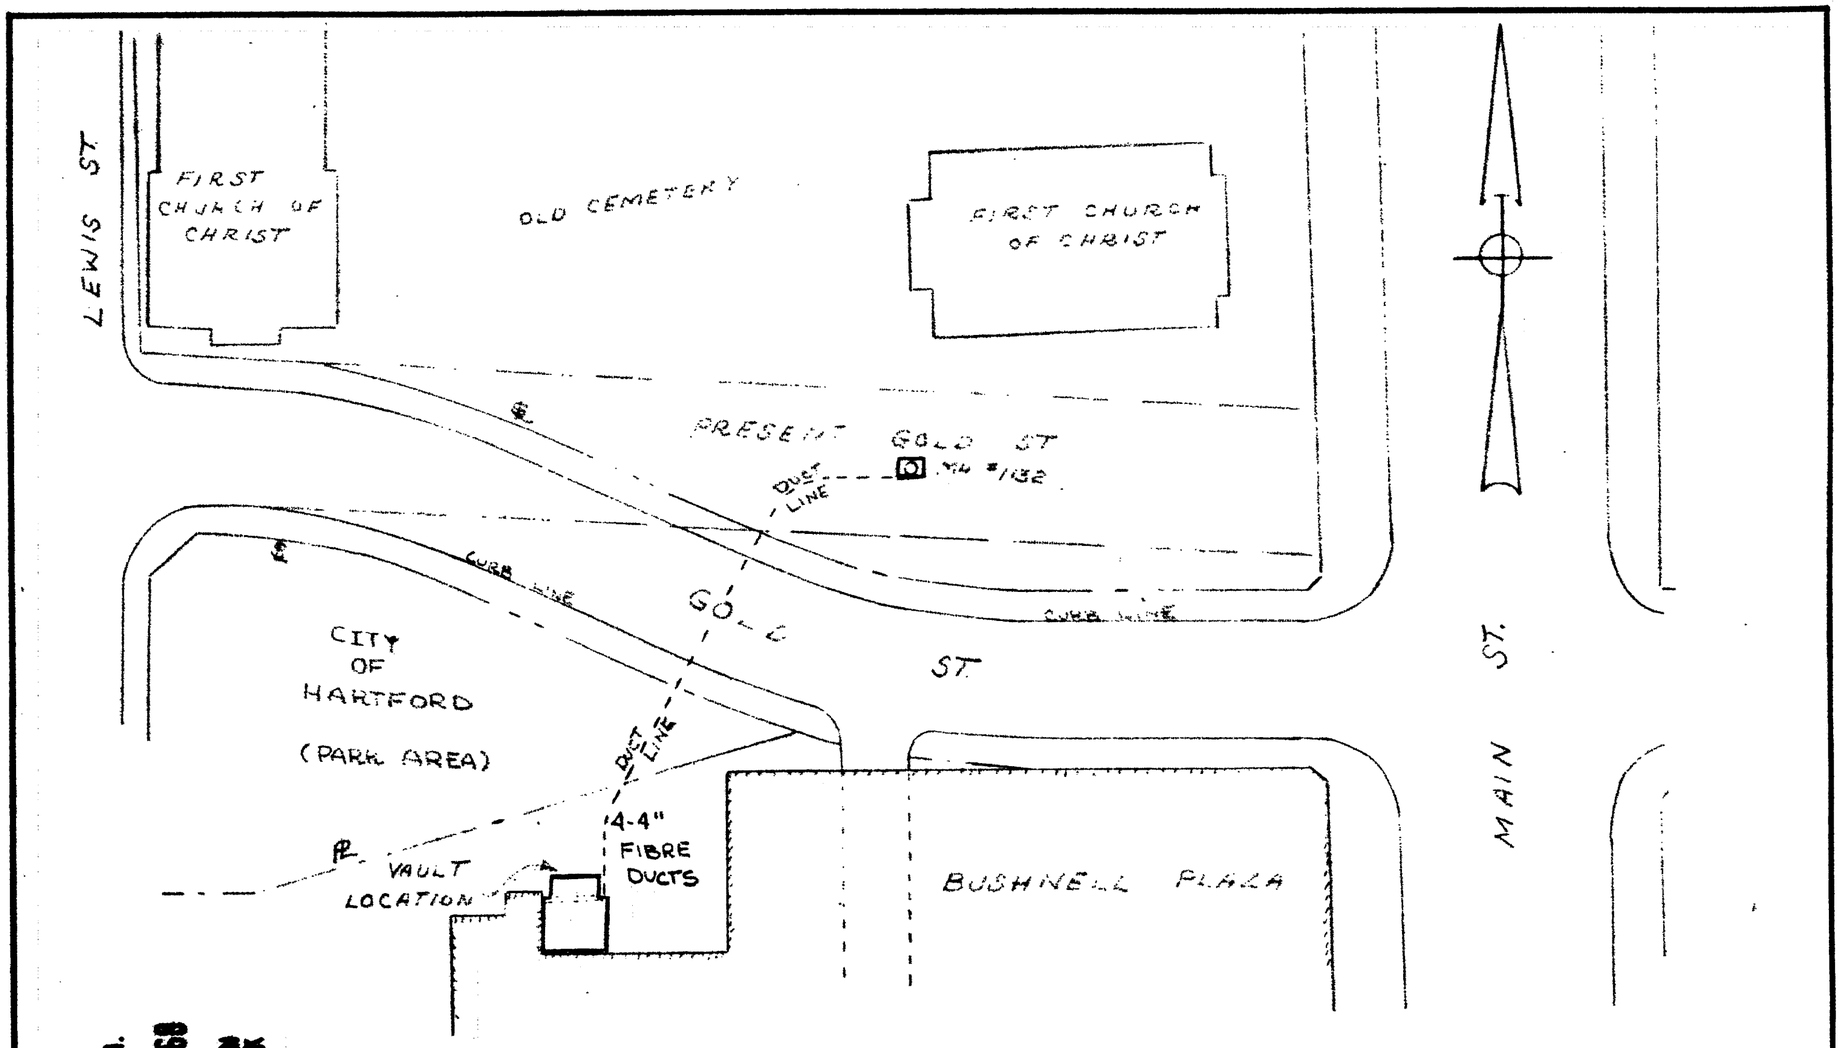

The portions of Main Street, Gold Street and Lewis Street shown on this plan are established public streets of the City of Hartford.

Apr. 8, 1968 Porter H. Barrows
City Engineer

RECEIVED
HARTFORD, CONN.
APR 8 2 46 PM '68
ROBERT J. GALLIVAN
TOWN & CITY CLERK

NO.	DATE	DESCRIPTION	BY	APP. BY

REVISIONS

Sketch Showing U. G. Facilities of The Hartford Electric Light Co. on the Property of The City of Hartford, Gold Street, Hartford, Connecticut.

THE HARTFORD ELECTRIC LIGHT CO.
ELECTRIC OPERATIONS DEPARTMENT

DRAWN BY P.S. CHECKED BY GAR APPROVED BY GAR
SCALE 1" = 60'
DATE MAR. 17, 1967 NO. D-012717

0 INCHES 1 2 3 4