


RECEIVED
HARTFORD, CONN.
SEP 9 11 15 AM '68
ROBERT J. GALLIVAN
TOWN & CITY CLERK

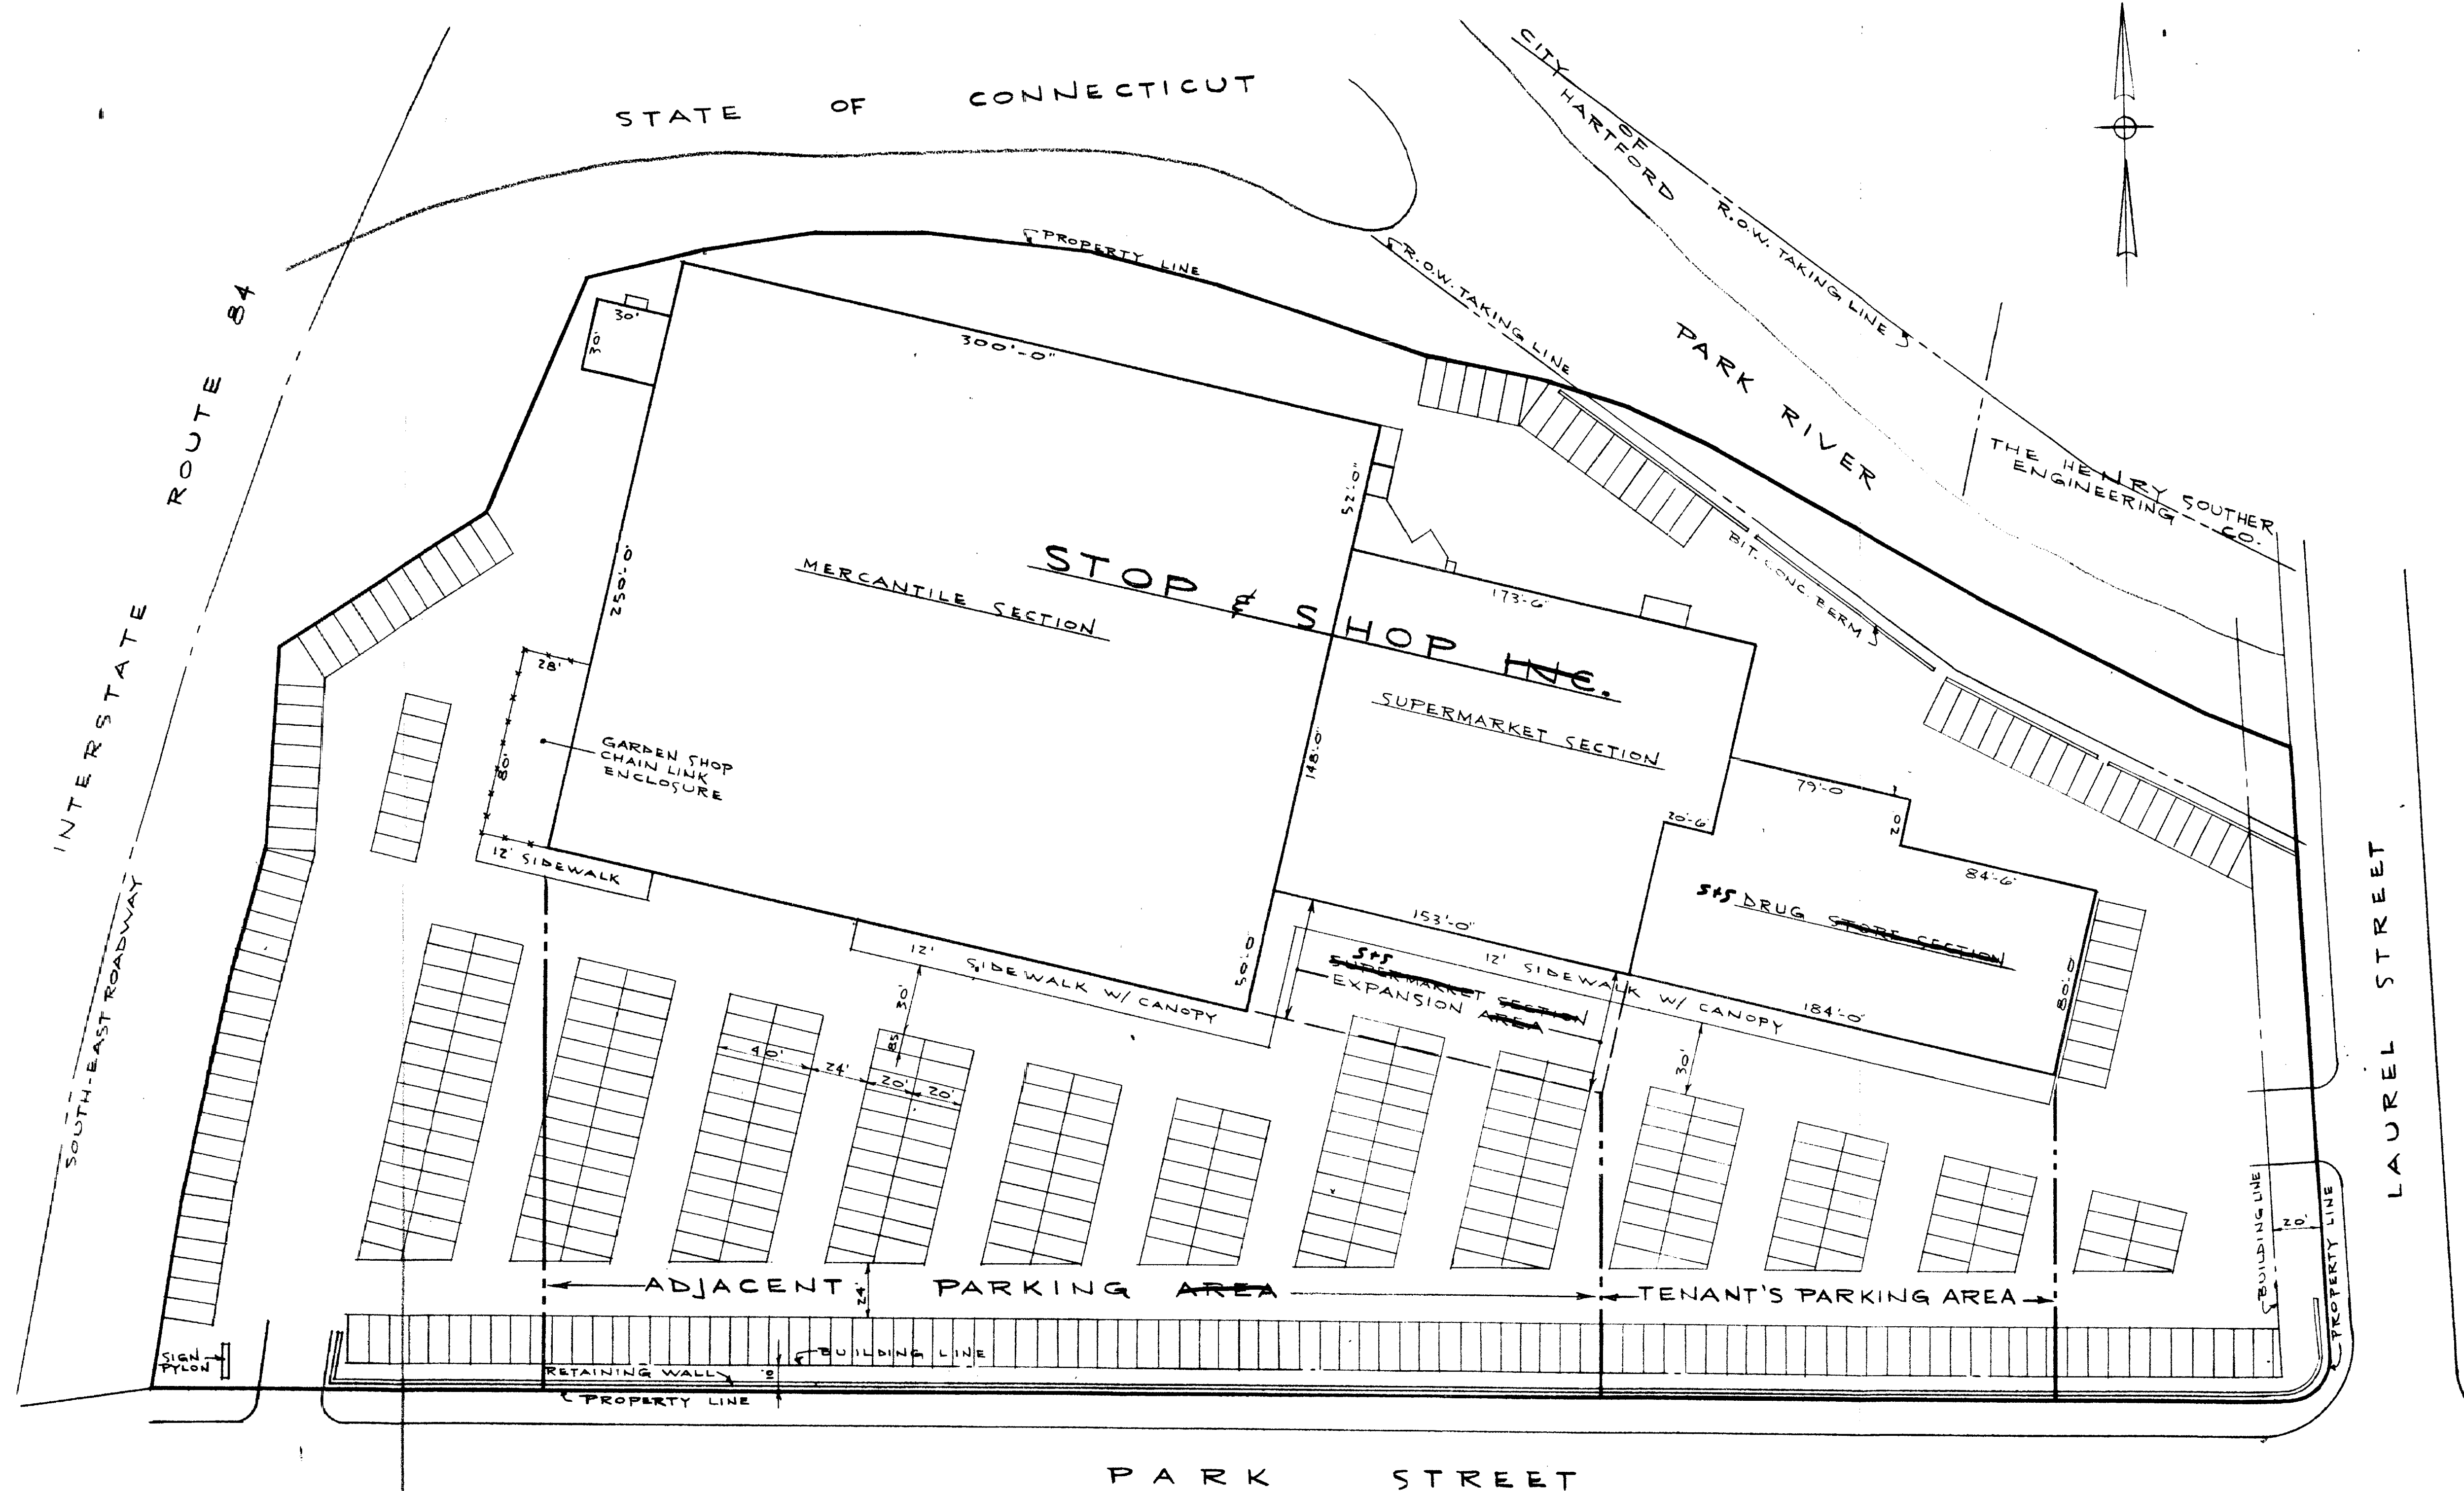

TOTAL PARKING - 410 CARS

EXHIBIT AAA

DESIGNED	SITE PLAN	JOB
DRAWN	SHOPPING PLAZA	DATE
CHECKED	PARK & LAUREL STREETS	6-27-68
APPROVED	HARTFORD, CONN.	SCALE
STOP & SHOP INC.		
PLANNING & ENGINEERING DEPT.		
397 D ST. - BOSTON - MASS.		

888