


RECEIVED
HARTFORD, CONN.
SEP 9 11 17 AM '68
ROBERT A. ALLEN
TOWN & CITY CLERK

THE HENRY SOUTHER
ENGINEERING CO.

688

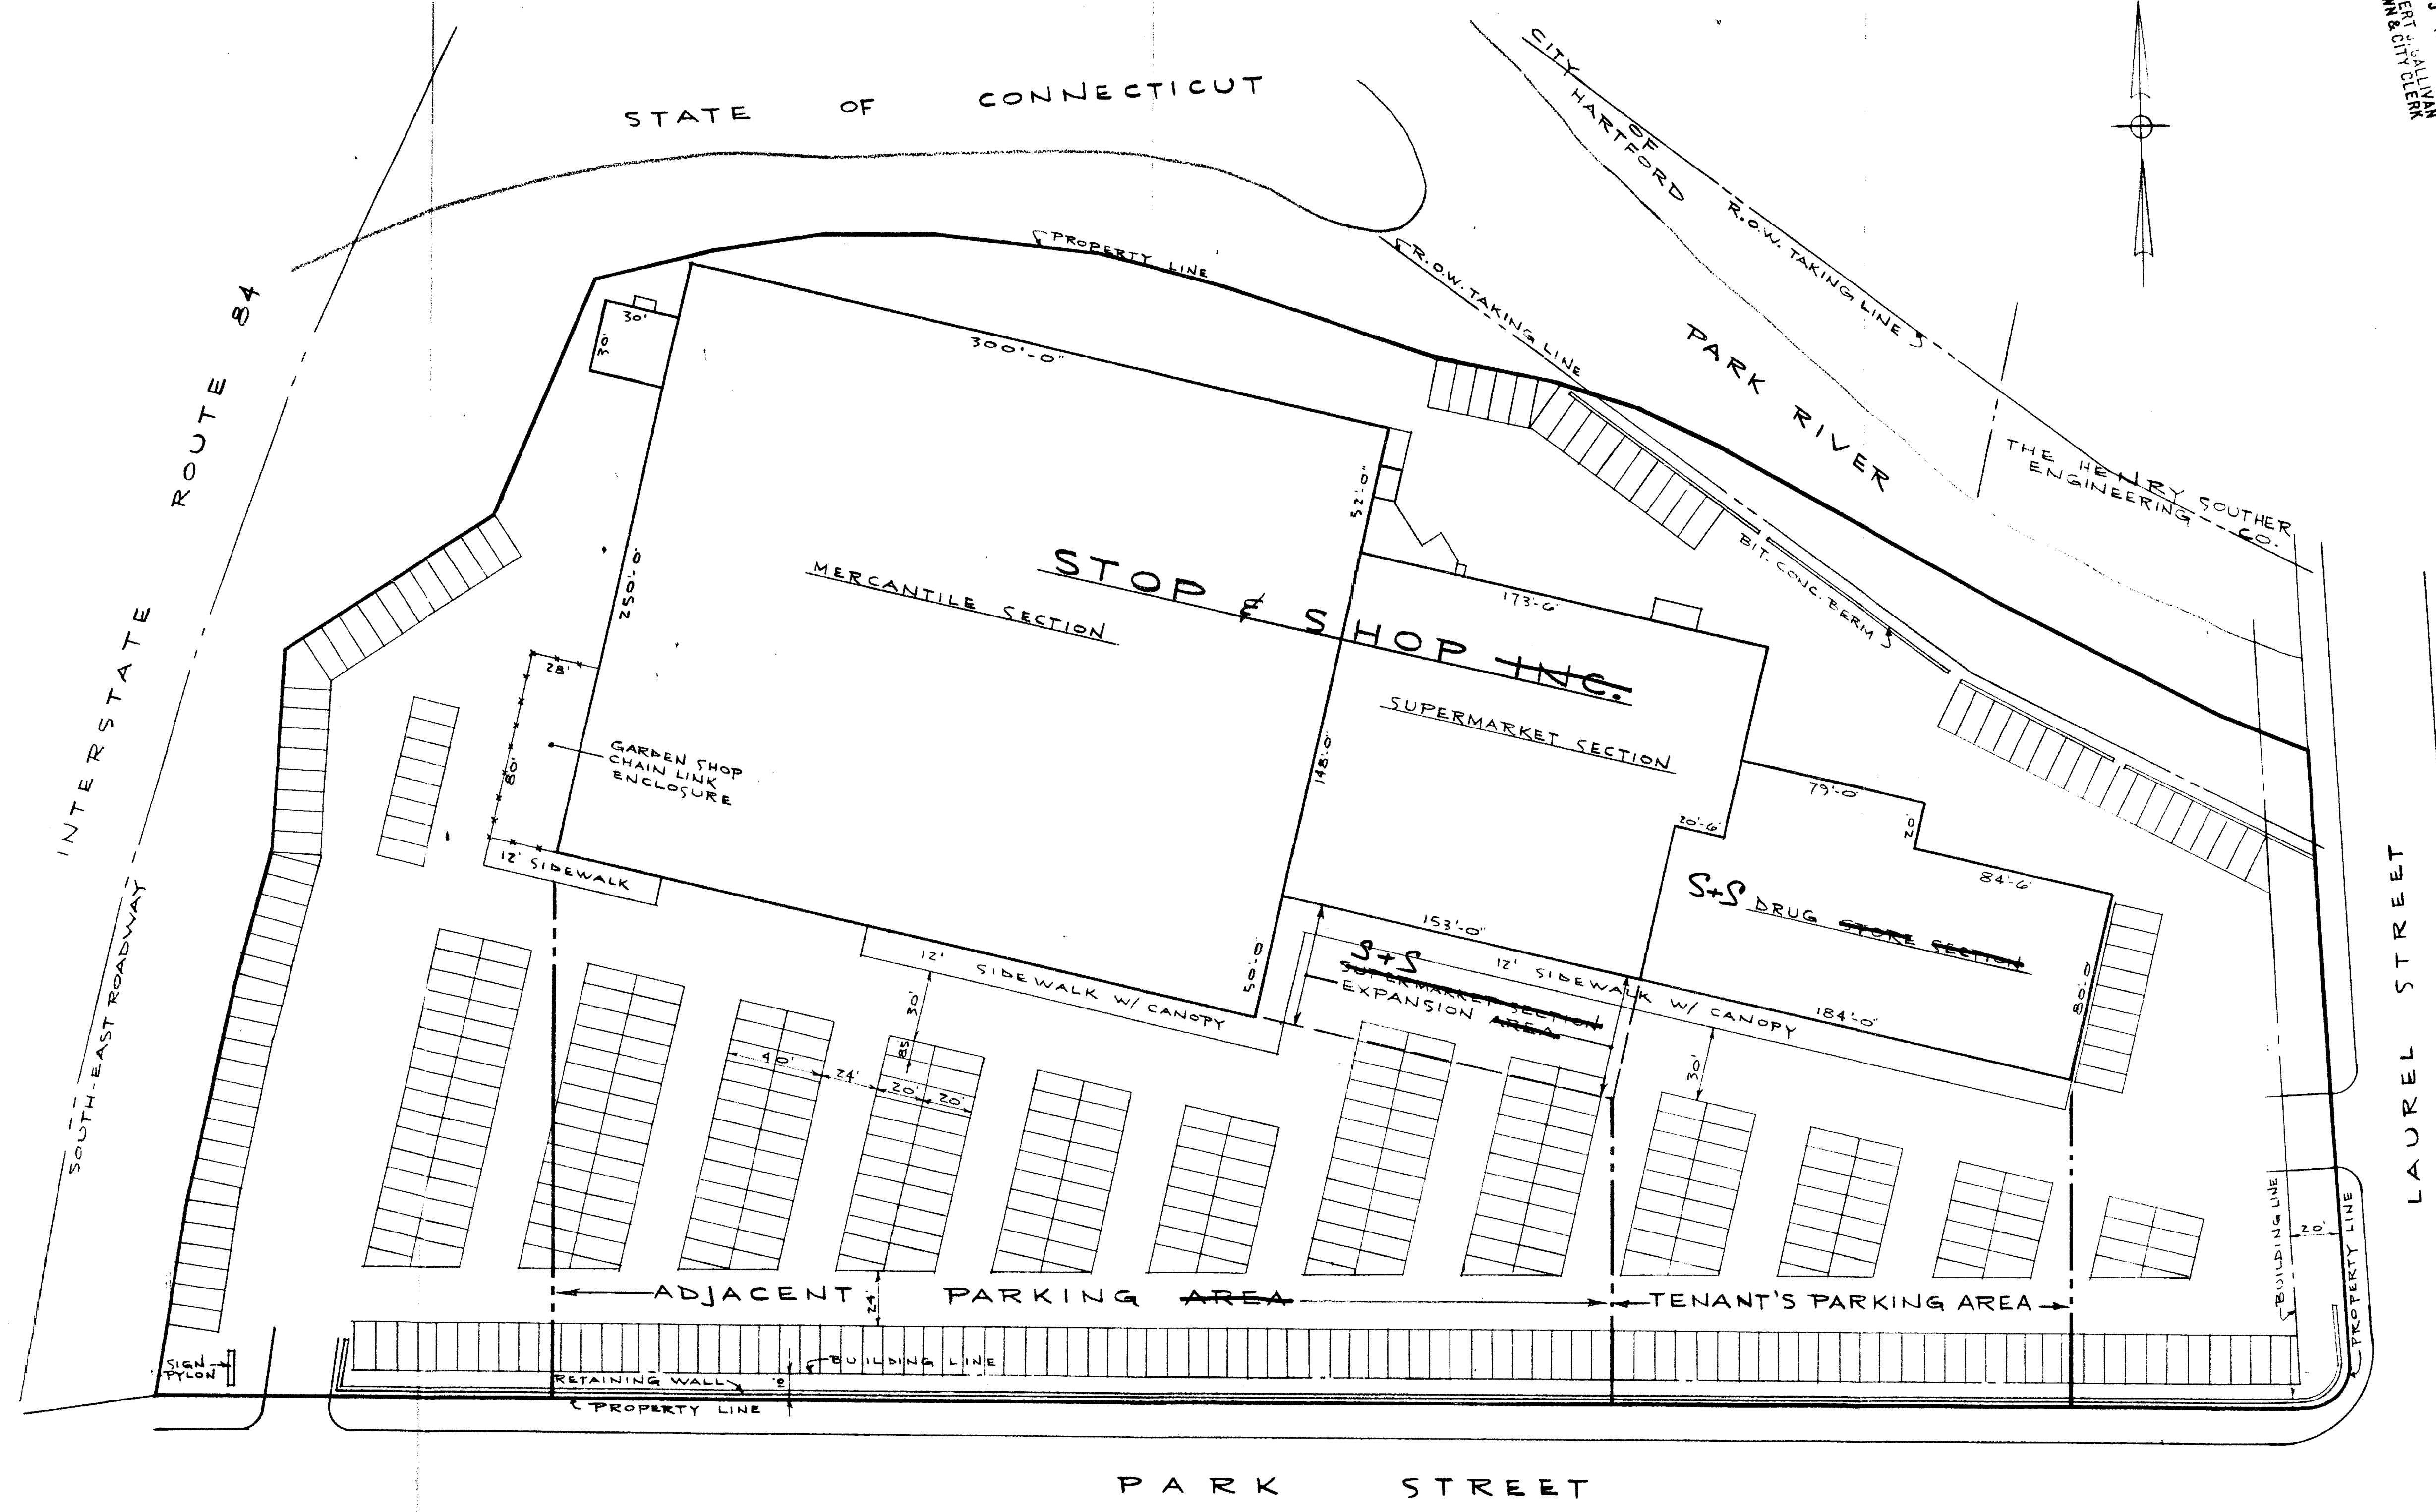

TOTAL PARKING - 410 CARS

DESIGNED	SITE PLAN	JOB
DRAWN	SHOPPING PLAZA	DATE
CHECKED	PARK & LAUREL STREETS	6-27-68
APPROVED	HARTFORD, CONN.	SCALE
STOP & SHOP INC.		
PLANNING & ENGINEERING DEPT.		
397 D ST. - BOSTON - MASS.		

