


899

899-3

ROBERT J. GALLIVAN
TOWN & CITY CLERK

George E. Hoppner
City Engineer

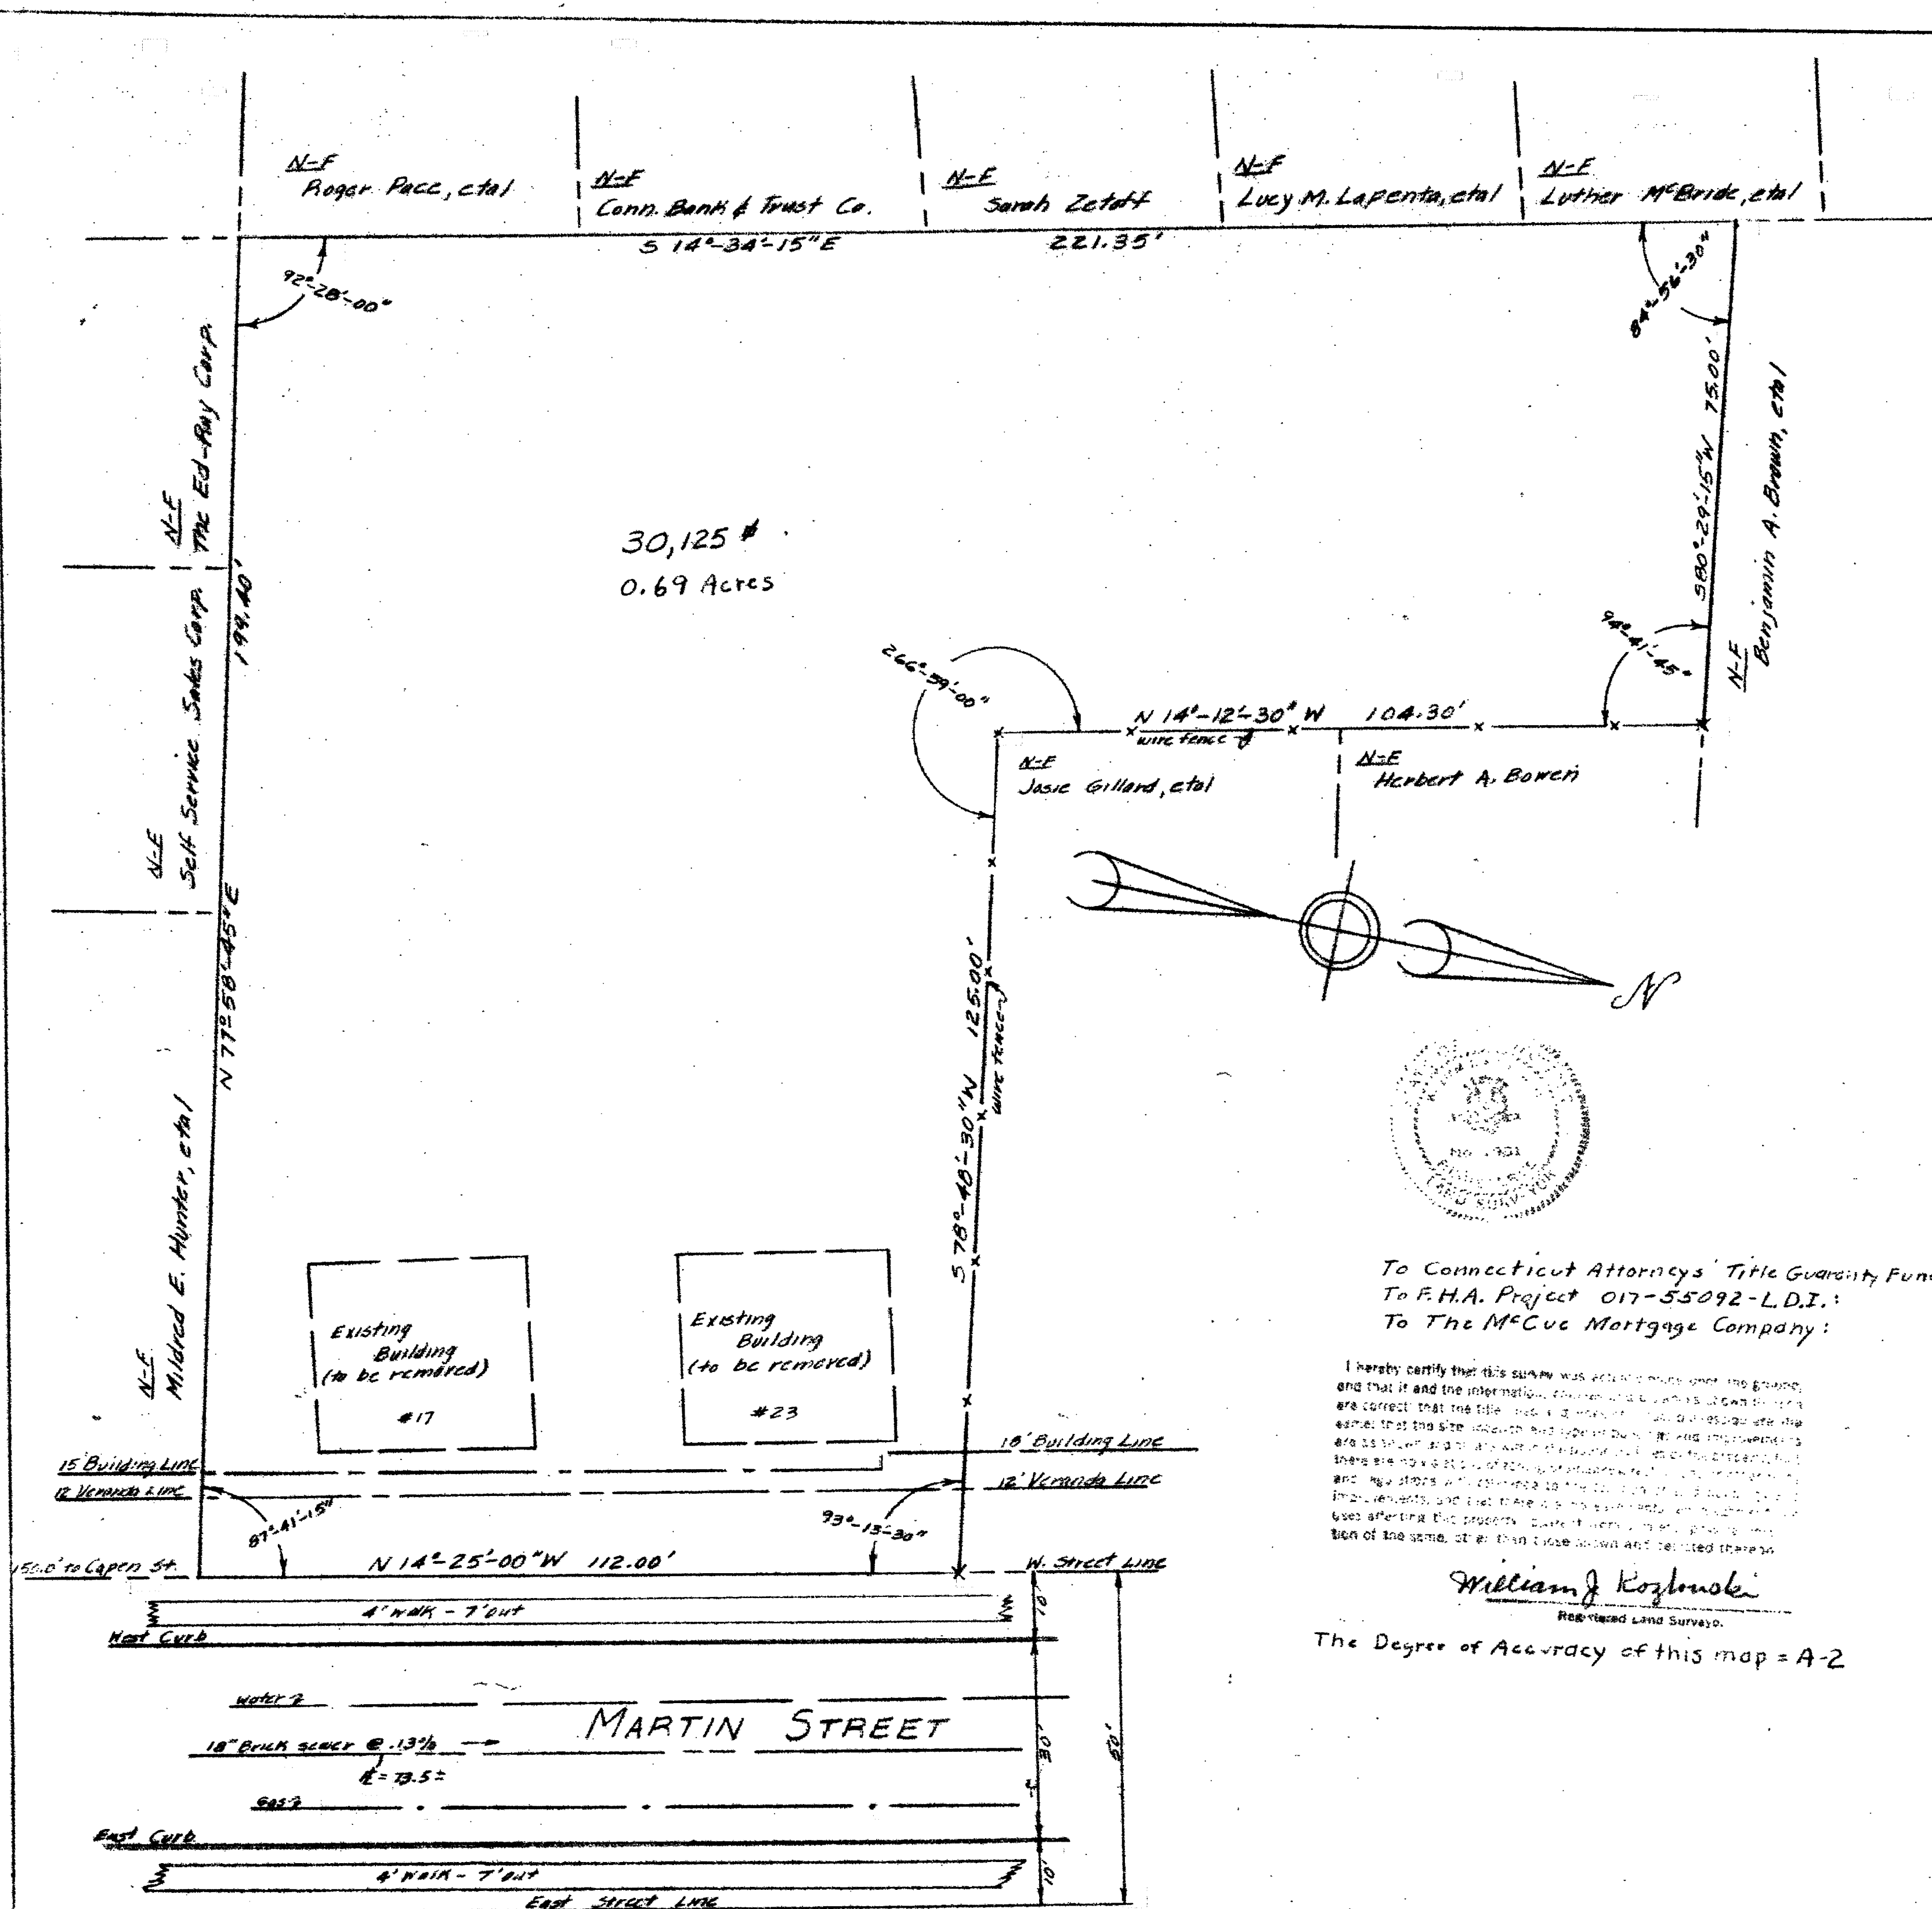

To Connecticut Attorneys Title Guaranty Fund, Inc.:
To F.H.A. Project 017-55092-L.D.I.:
To The McCue Mortgage Company:

[illegible]

William J. Kozlowski
Registered Land Surveyor.

The Degree of Accuracy of this map = A-2

PROPERTY OF
WILLIAM E. CURRY
MARTIN STREET
HARTFORD, CONNECTICUT
MAY 6, 1969 SCALE: 1"=20'
F.H.A. PROJECT # 017-55092-LDL

